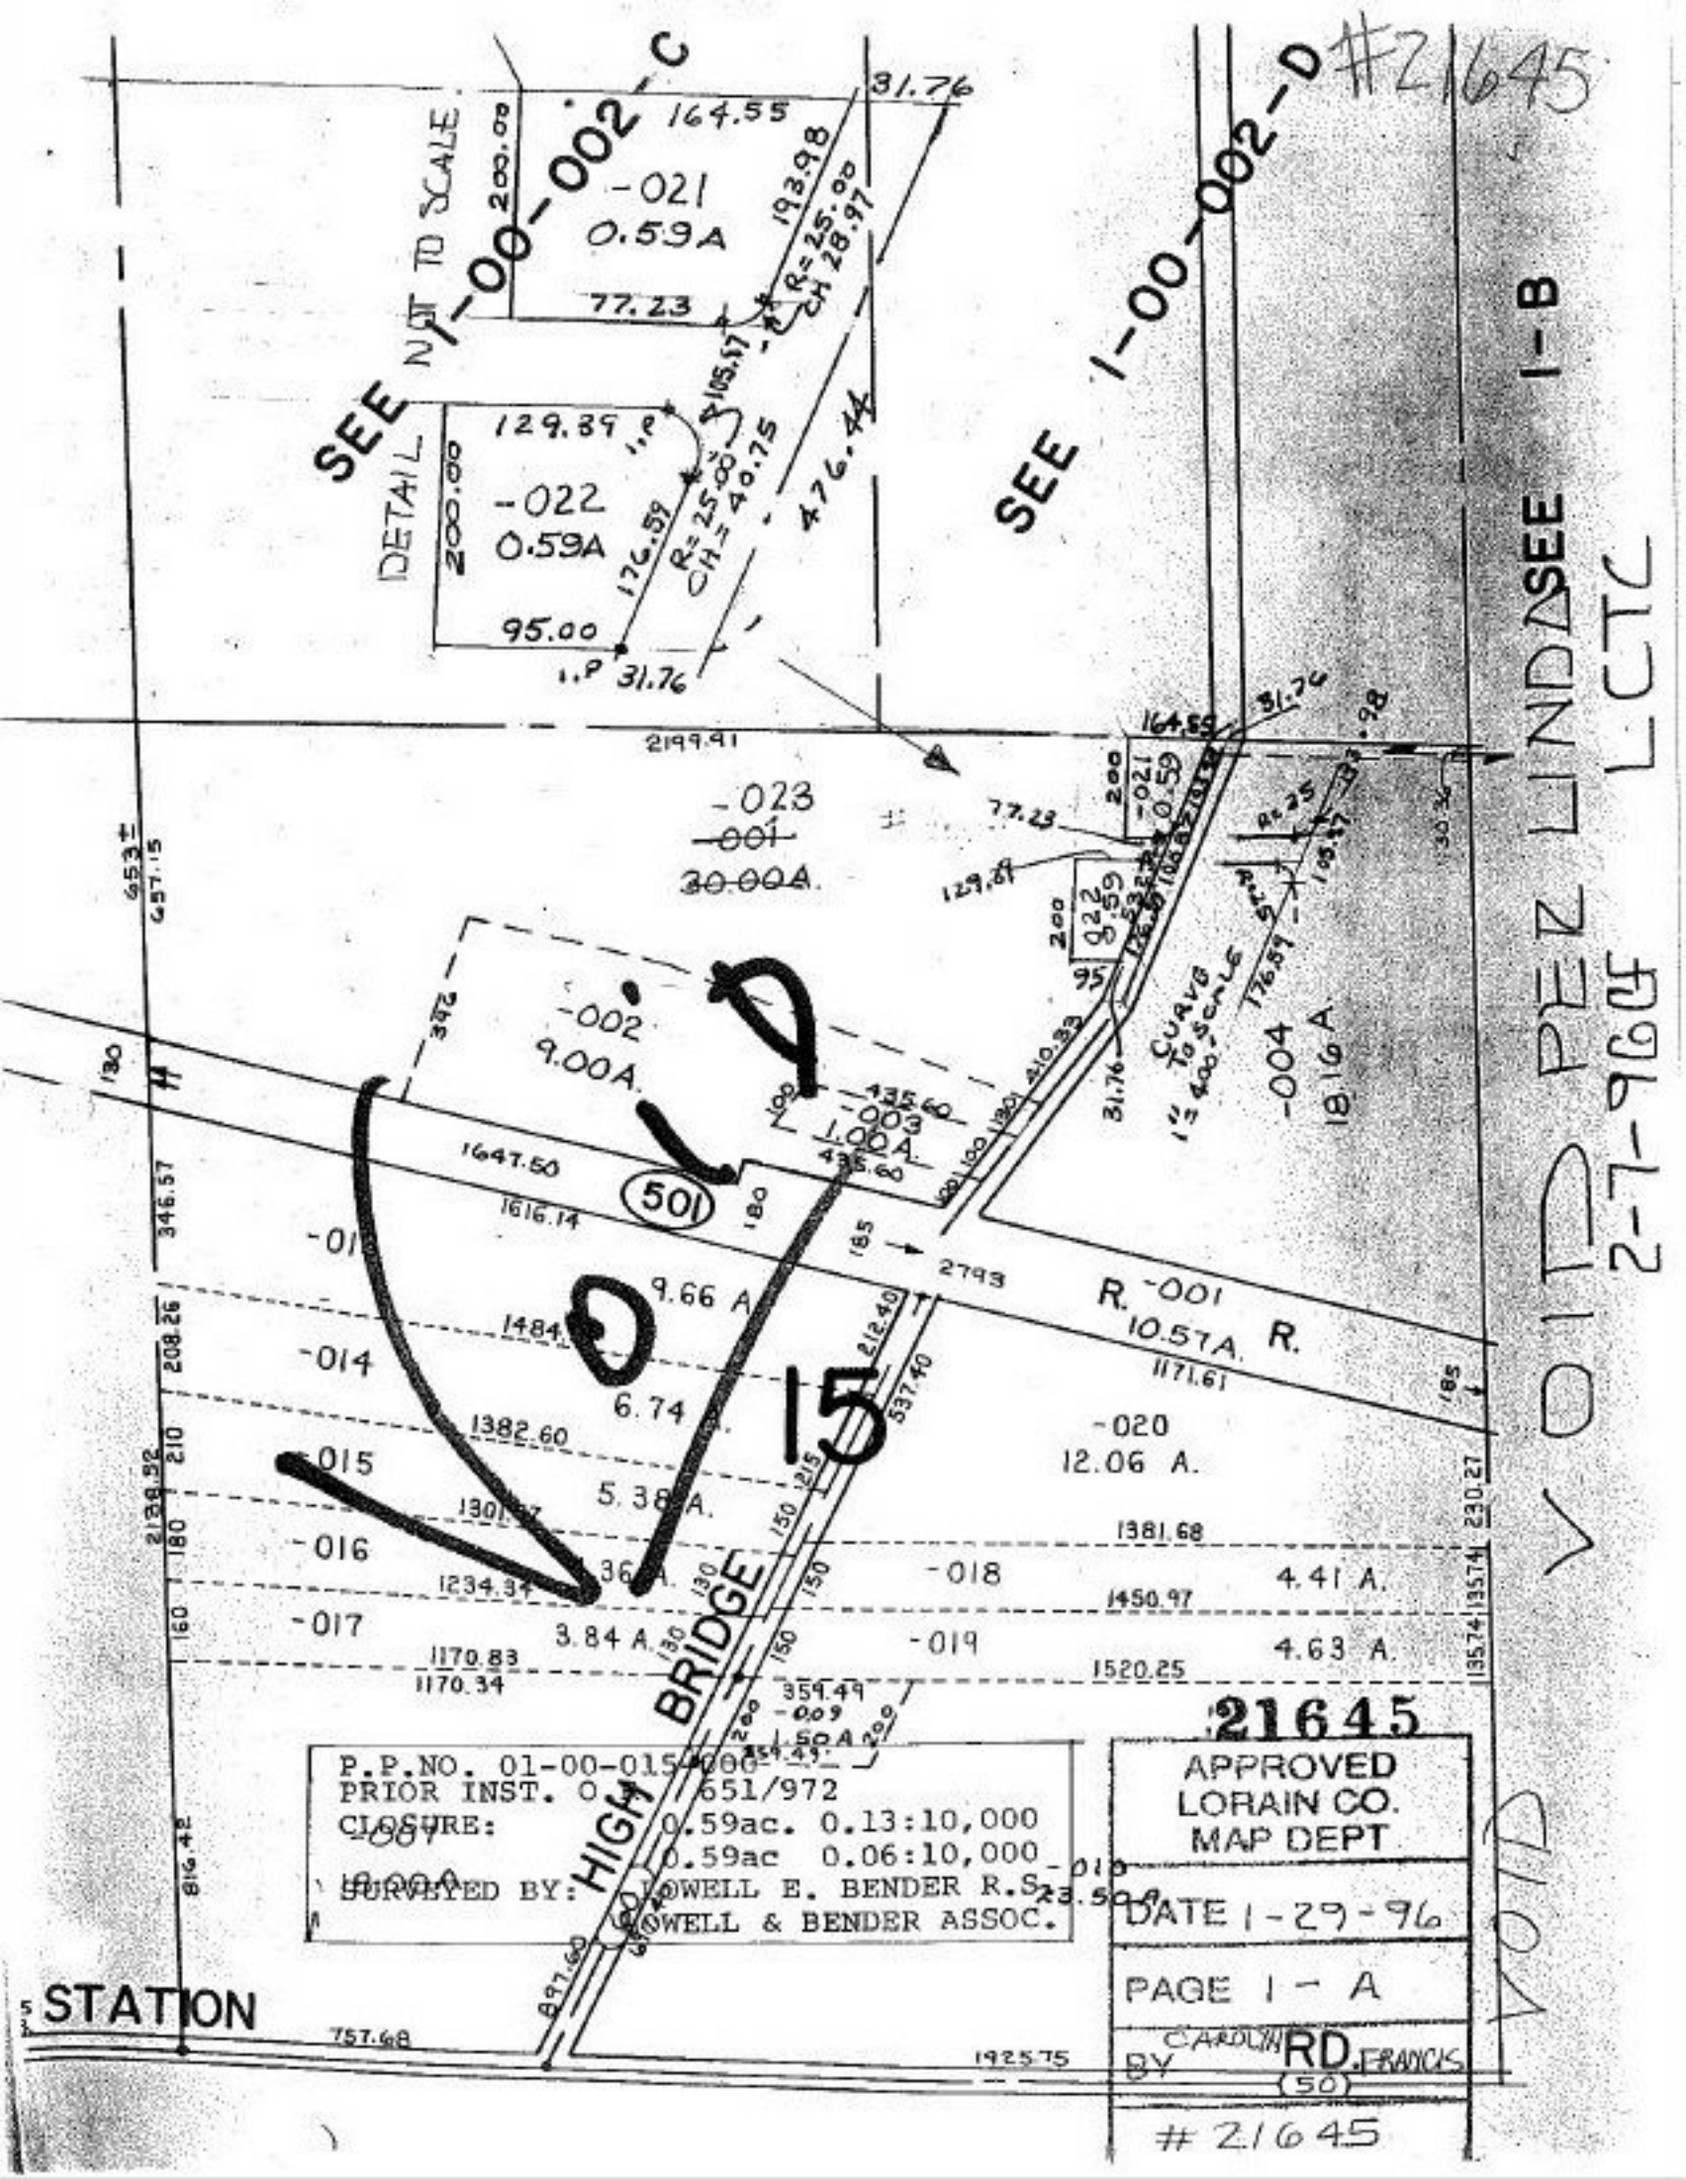
#21645
SEE 1-00-002-C
SEE 1-00-002-D
SEE DETAIL
NOT TO SCALE
-021
0.59A
-022
0.59A
-023
001
30.00A.
-002
9.00A.
-001
10.57A.
-004
18.16A.
-020
12.06 A.
-018
4.41 A.
-019
4.63 A.
-017
3.84 A.
-016
-015
5.38 A.
-014
6.74 A.
9.66 A
-010
23.50 A.
-009
1.50 A.
-008
8.00 A.
CURVE
1" = 400' SCALE
HIGH BRIDGE
STATION
CARDINAL
RD.
FRANCIS
50
501
VOID PEZ LINDA SEE 1-B
2-7-96 LCTC
VOID
P.P.NO. 01-00-015-000-
PRIOR INST. O 651/972
CLOSURE: 0.59ac. 0.13:10,000
0.59ac 0.06:10,000
SURVEYED BY: LOWELL E. BENDER R.S.
LOWELL & BENDER ASSOC.
21645
APPROVED
LORAIN CO.
MAP DEPT
DATE 1-29-96
PAGE 1 - A
BY
21645