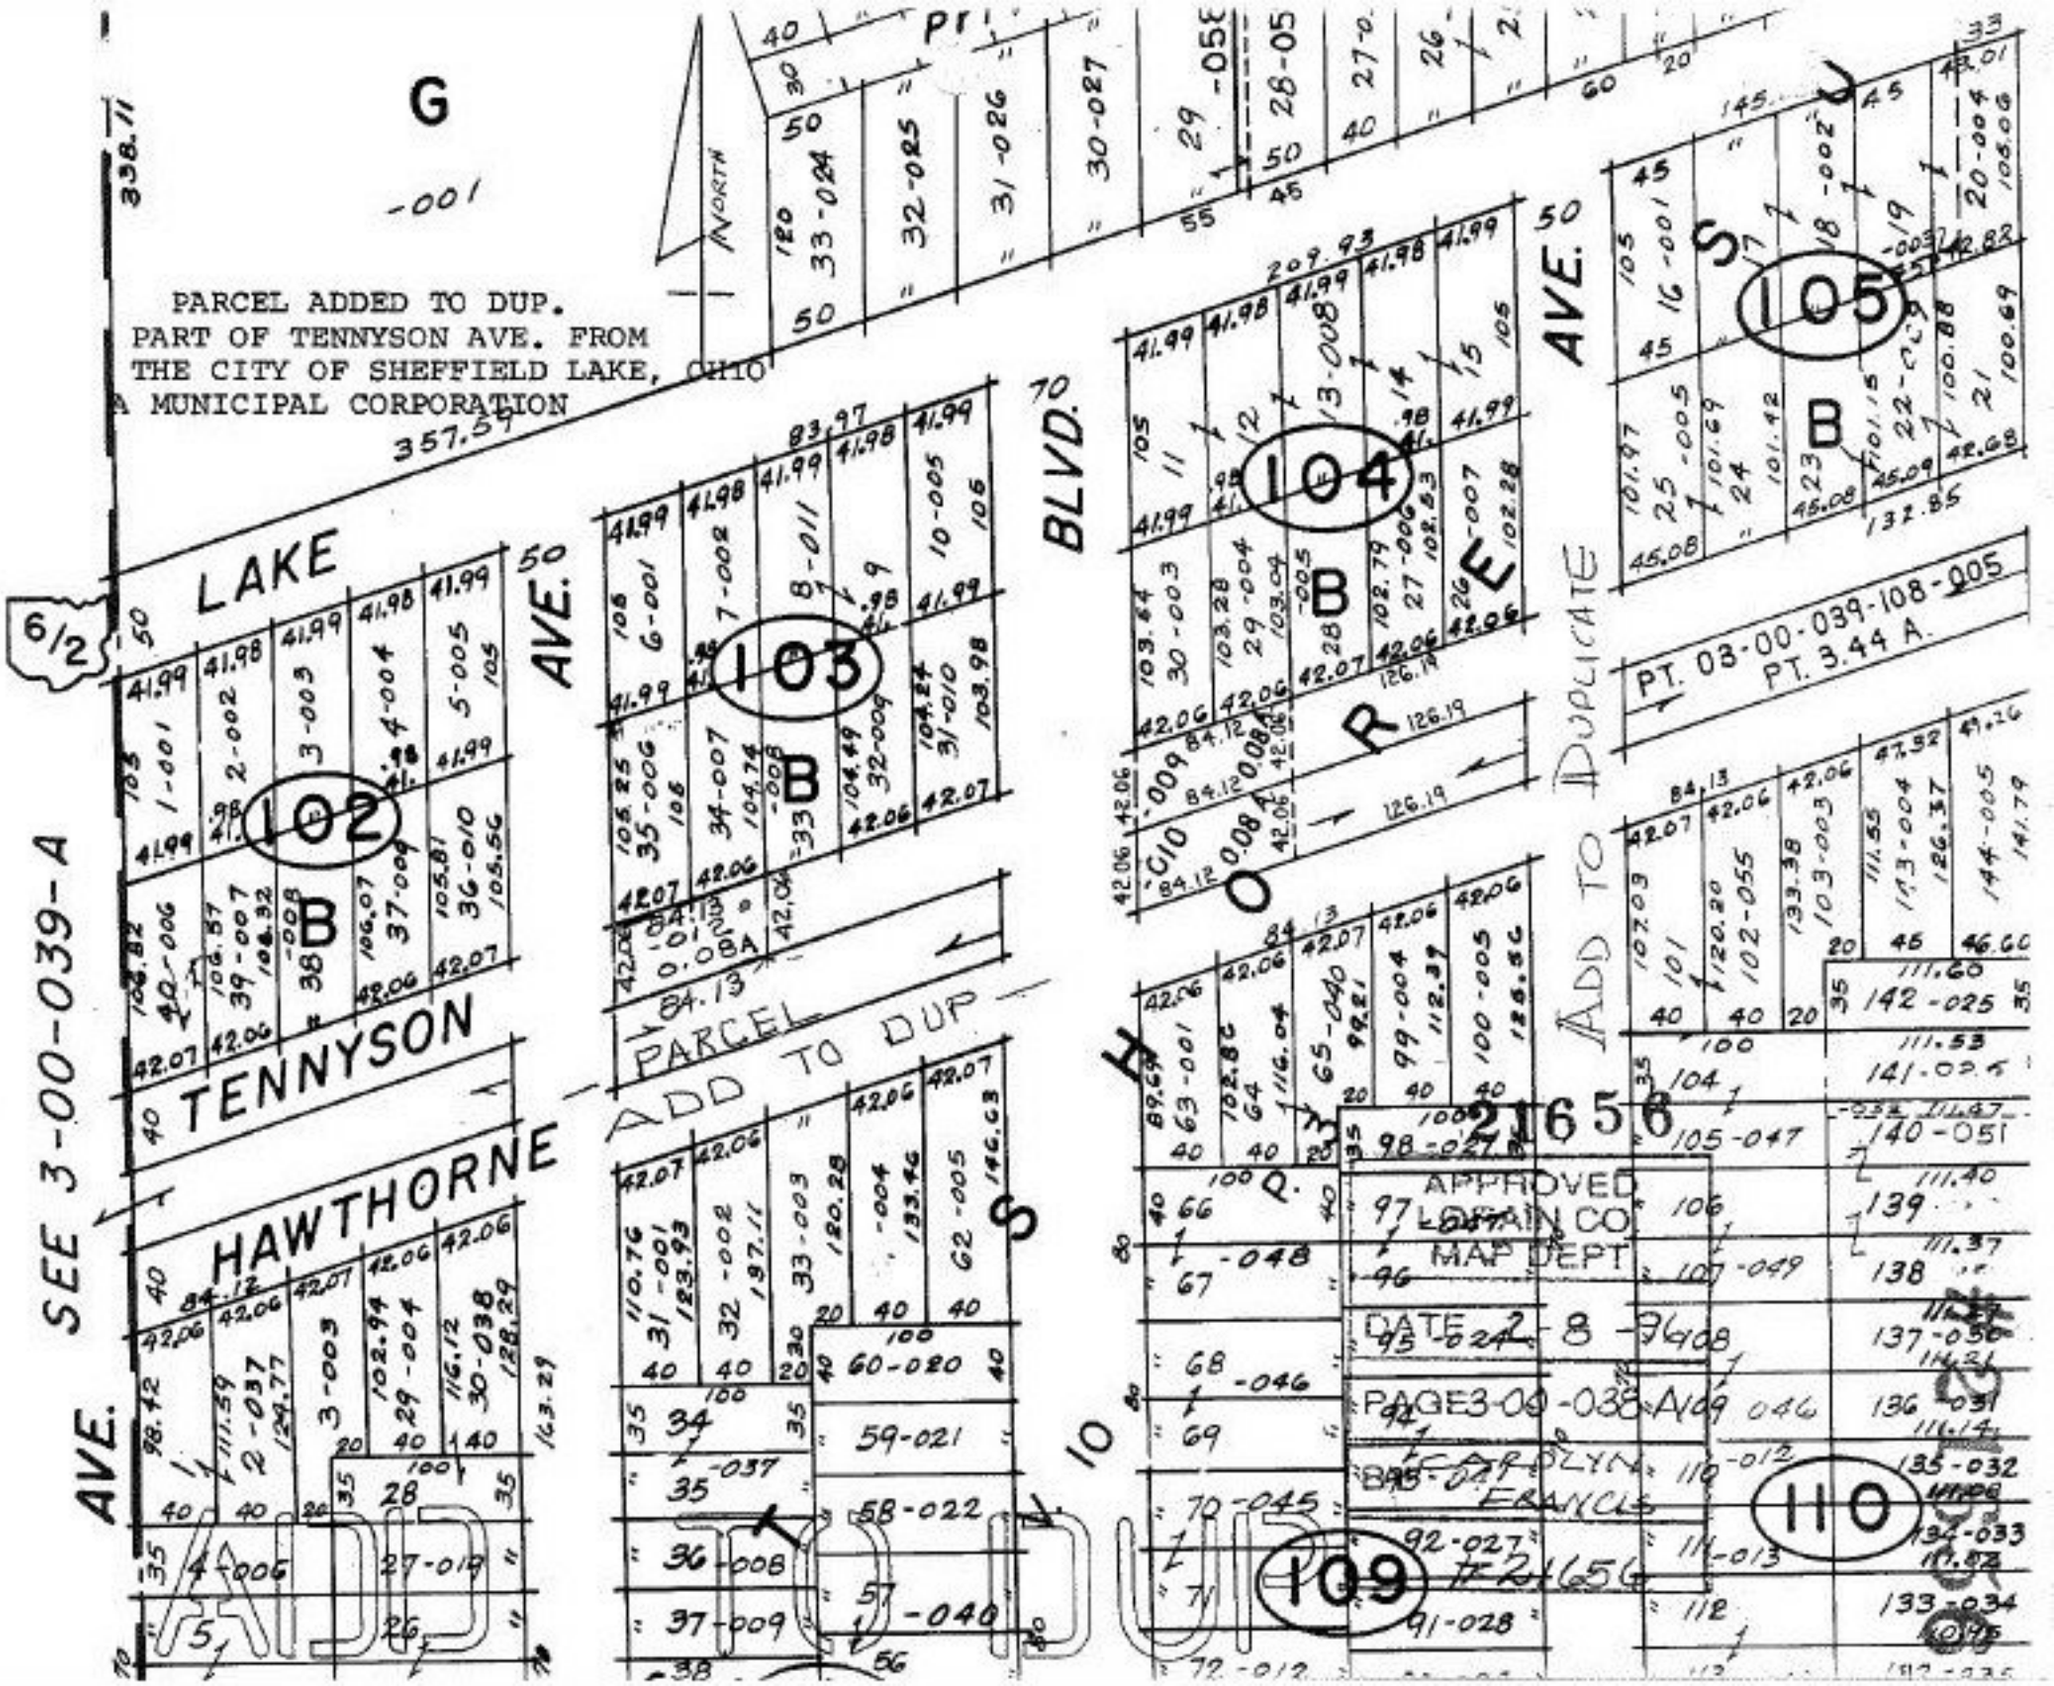
PARCEL ADDED TO DUP.
PART OF TENNYSON AVE. FROM
THE CITY OF SHEFFIELD LAKE, OHIO
A MUNICIPAL CORPORATION
LAKE AVE.
TENNYSON AVE.
HAWTHORNE AVE.
BLVD.
PARCEL ADD TO DUP
ADD TO DUPLICATE
SEE 3-00-039-A
PT. 03-00-039-108-005
PT. 3.44 A.
APPROVED
LORAIN CO
MAP DEPT
DATE 2-8-96
PAGE 3-00-038-A
#21656
102
103
104
105
109
110
NORTH
SOUTH
