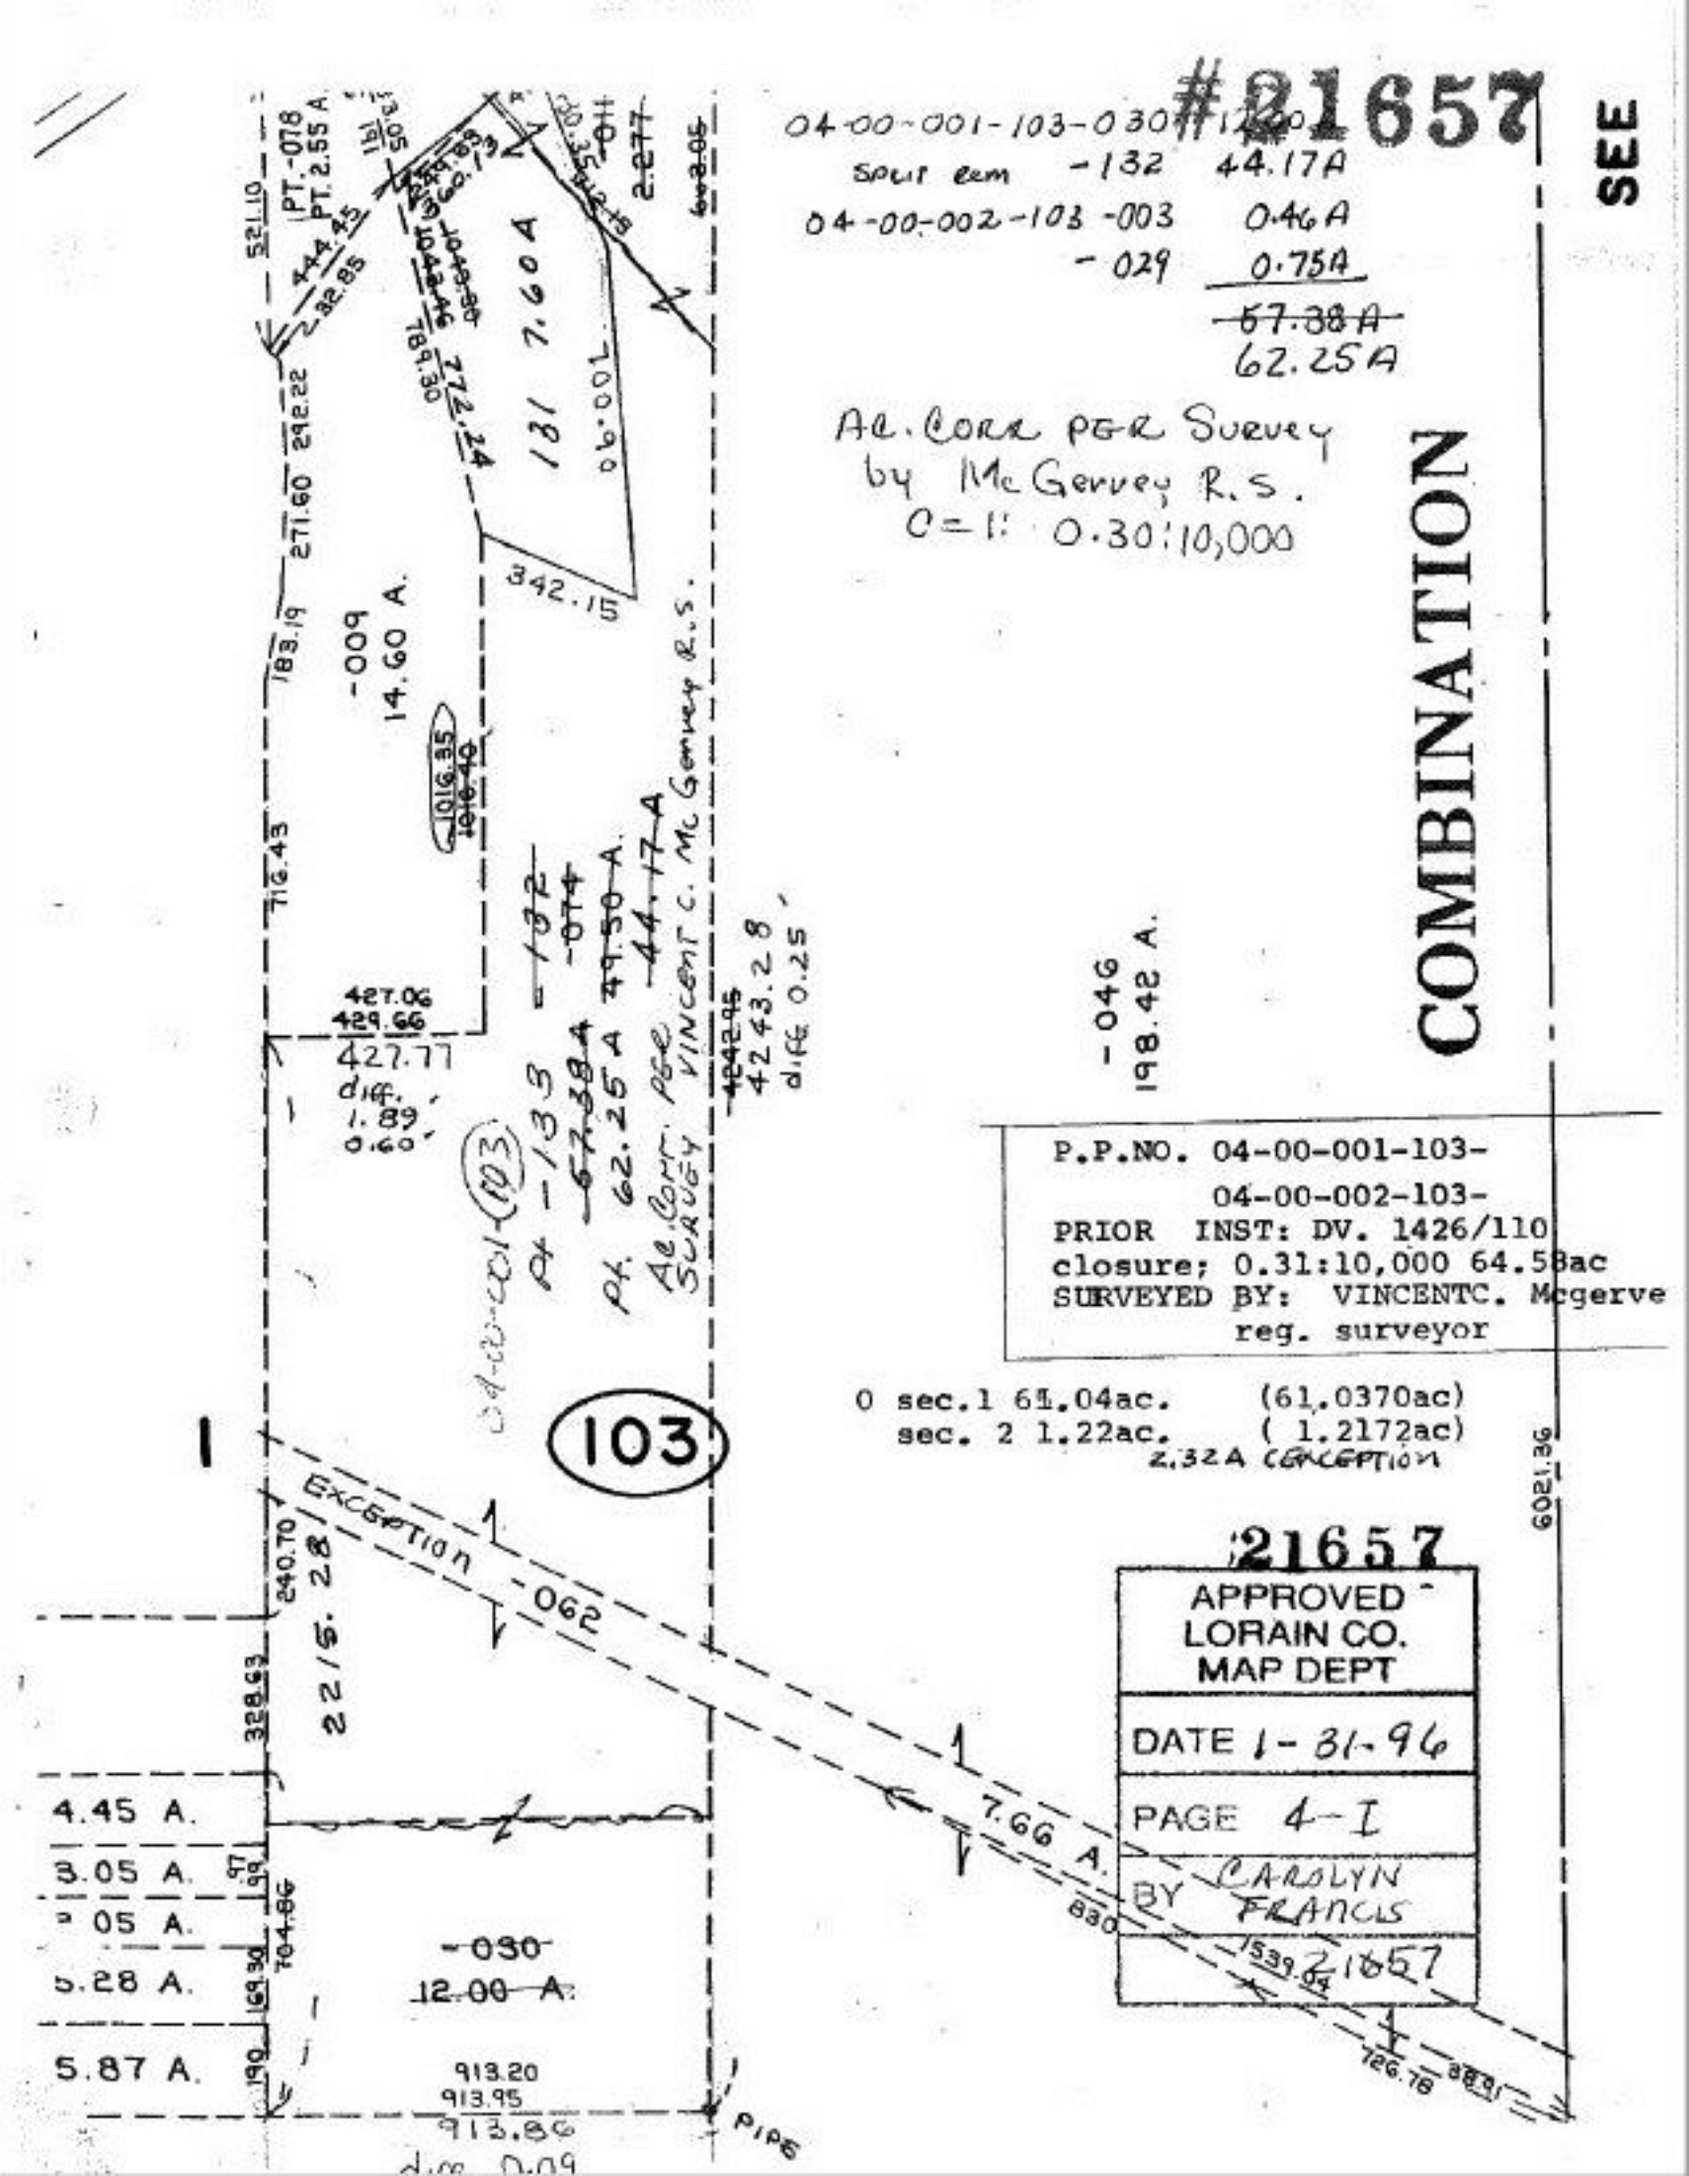
#21657
SEE
04-00-001-103-030 12.00
Split rem -132 44.17A
04-00-002-103 -003 0.46A
-029 0.75A
~~57.38A~~
62.25A
AC. CORR PER SURVEY
by McGervey R.S.
C=1: 0.30:10,000
COMBINATION
PT.-078
PT. 2.55 A
131 7.60 A
-009
14.60 A.
342.15
427.06
429.66
427.77
diff.
1.89
0.60
-046
198.42 A.
P.P.NO. 04-00-001-103-
04-00-002-103-
PRIOR INST: DV. 1426/110
closure; 0.31:10,000 64.58ac
SURVEYED BY: VINCENTC. Mcgerve
reg. surveyor
0 sec.1 61.04ac. (61.0370ac)
sec. 2 1.22ac. (1.2172ac)
2.32A CEXCEPTION
103
EXCEPTION -062
2215.28
7.66 A.
4.45 A.
3.05 A.
5.28 A.
5.87 A.
-030
12.00 A.
913.20
913.95
913.86
PIPE
21657
APPROVED
LORAIN CO.
MAP DEPT
DATE 1-31-96
PAGE 4-I
BY CAROLYN FRANCIS
21657