#21660

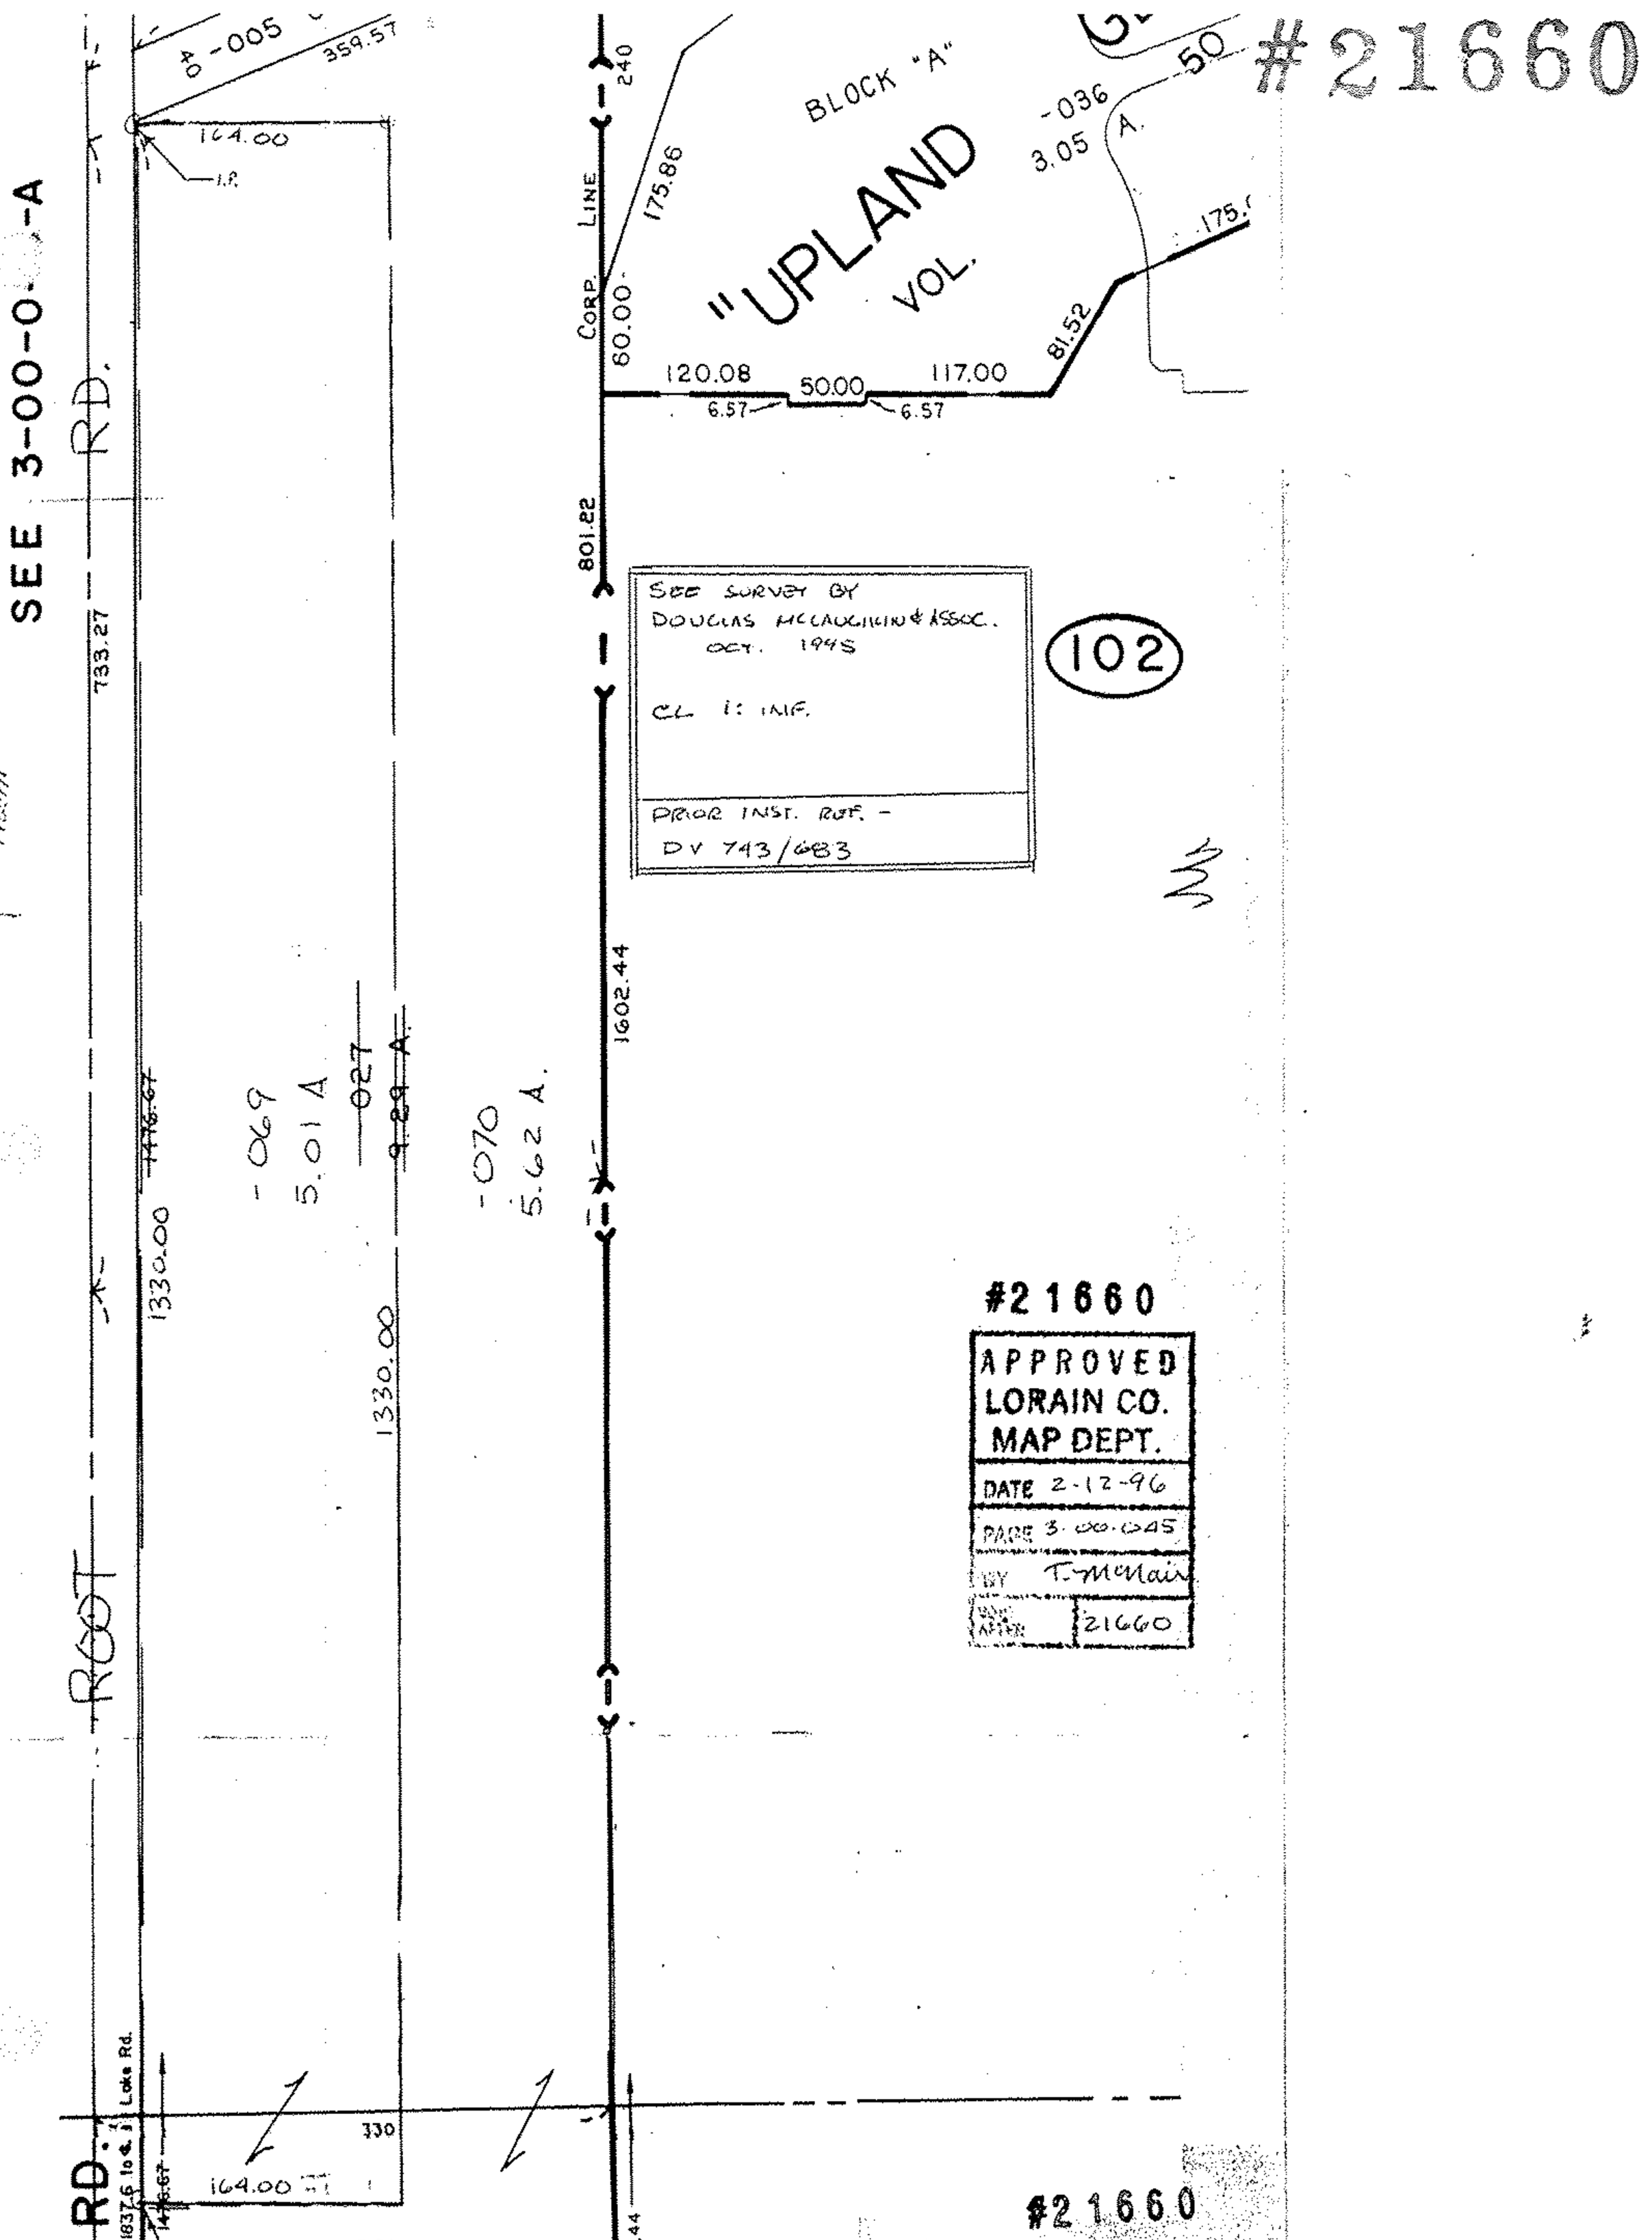
SEE
3-00-0-A
RD.
733.27
416.67
1330.00
-069
5.01 A
027
9.29 A.
-070
5.62 A.
1602.44
801.22
BLOCK "A"
"UPLAND
VOL.
CORP. LINE
240
175.86
60.00
120.08
6.57
50.00
6.57
117.00
81.52
-036
3.05 A.
50
SEE SURVEY BY
DOUGLAS MCLAUGHLIN & ASSOC.
OCT. 1995
CL 1: INF.
PRIOR INST. REF. -
DV 743/683
102
#21660
APPROVED
LORAIN CO.
MAP DEPT.
DATE 2-12-96
BY T. McNair
ENTER AFTER 21660
Root
RD.
Lake Rd.
1837.6 to E. J.
1488.57
1330
164.00
I.P.
001
1.34 A.
1602.44
88°48'
N. -003 Y. C. &
0.50 A.
33
130.03
167.04
#21660
APPROVED
LORAIN CO.
MAP DEPT.
DATE 2-12-96
PAGE 3-00-031-A
BY T. McNair
21660