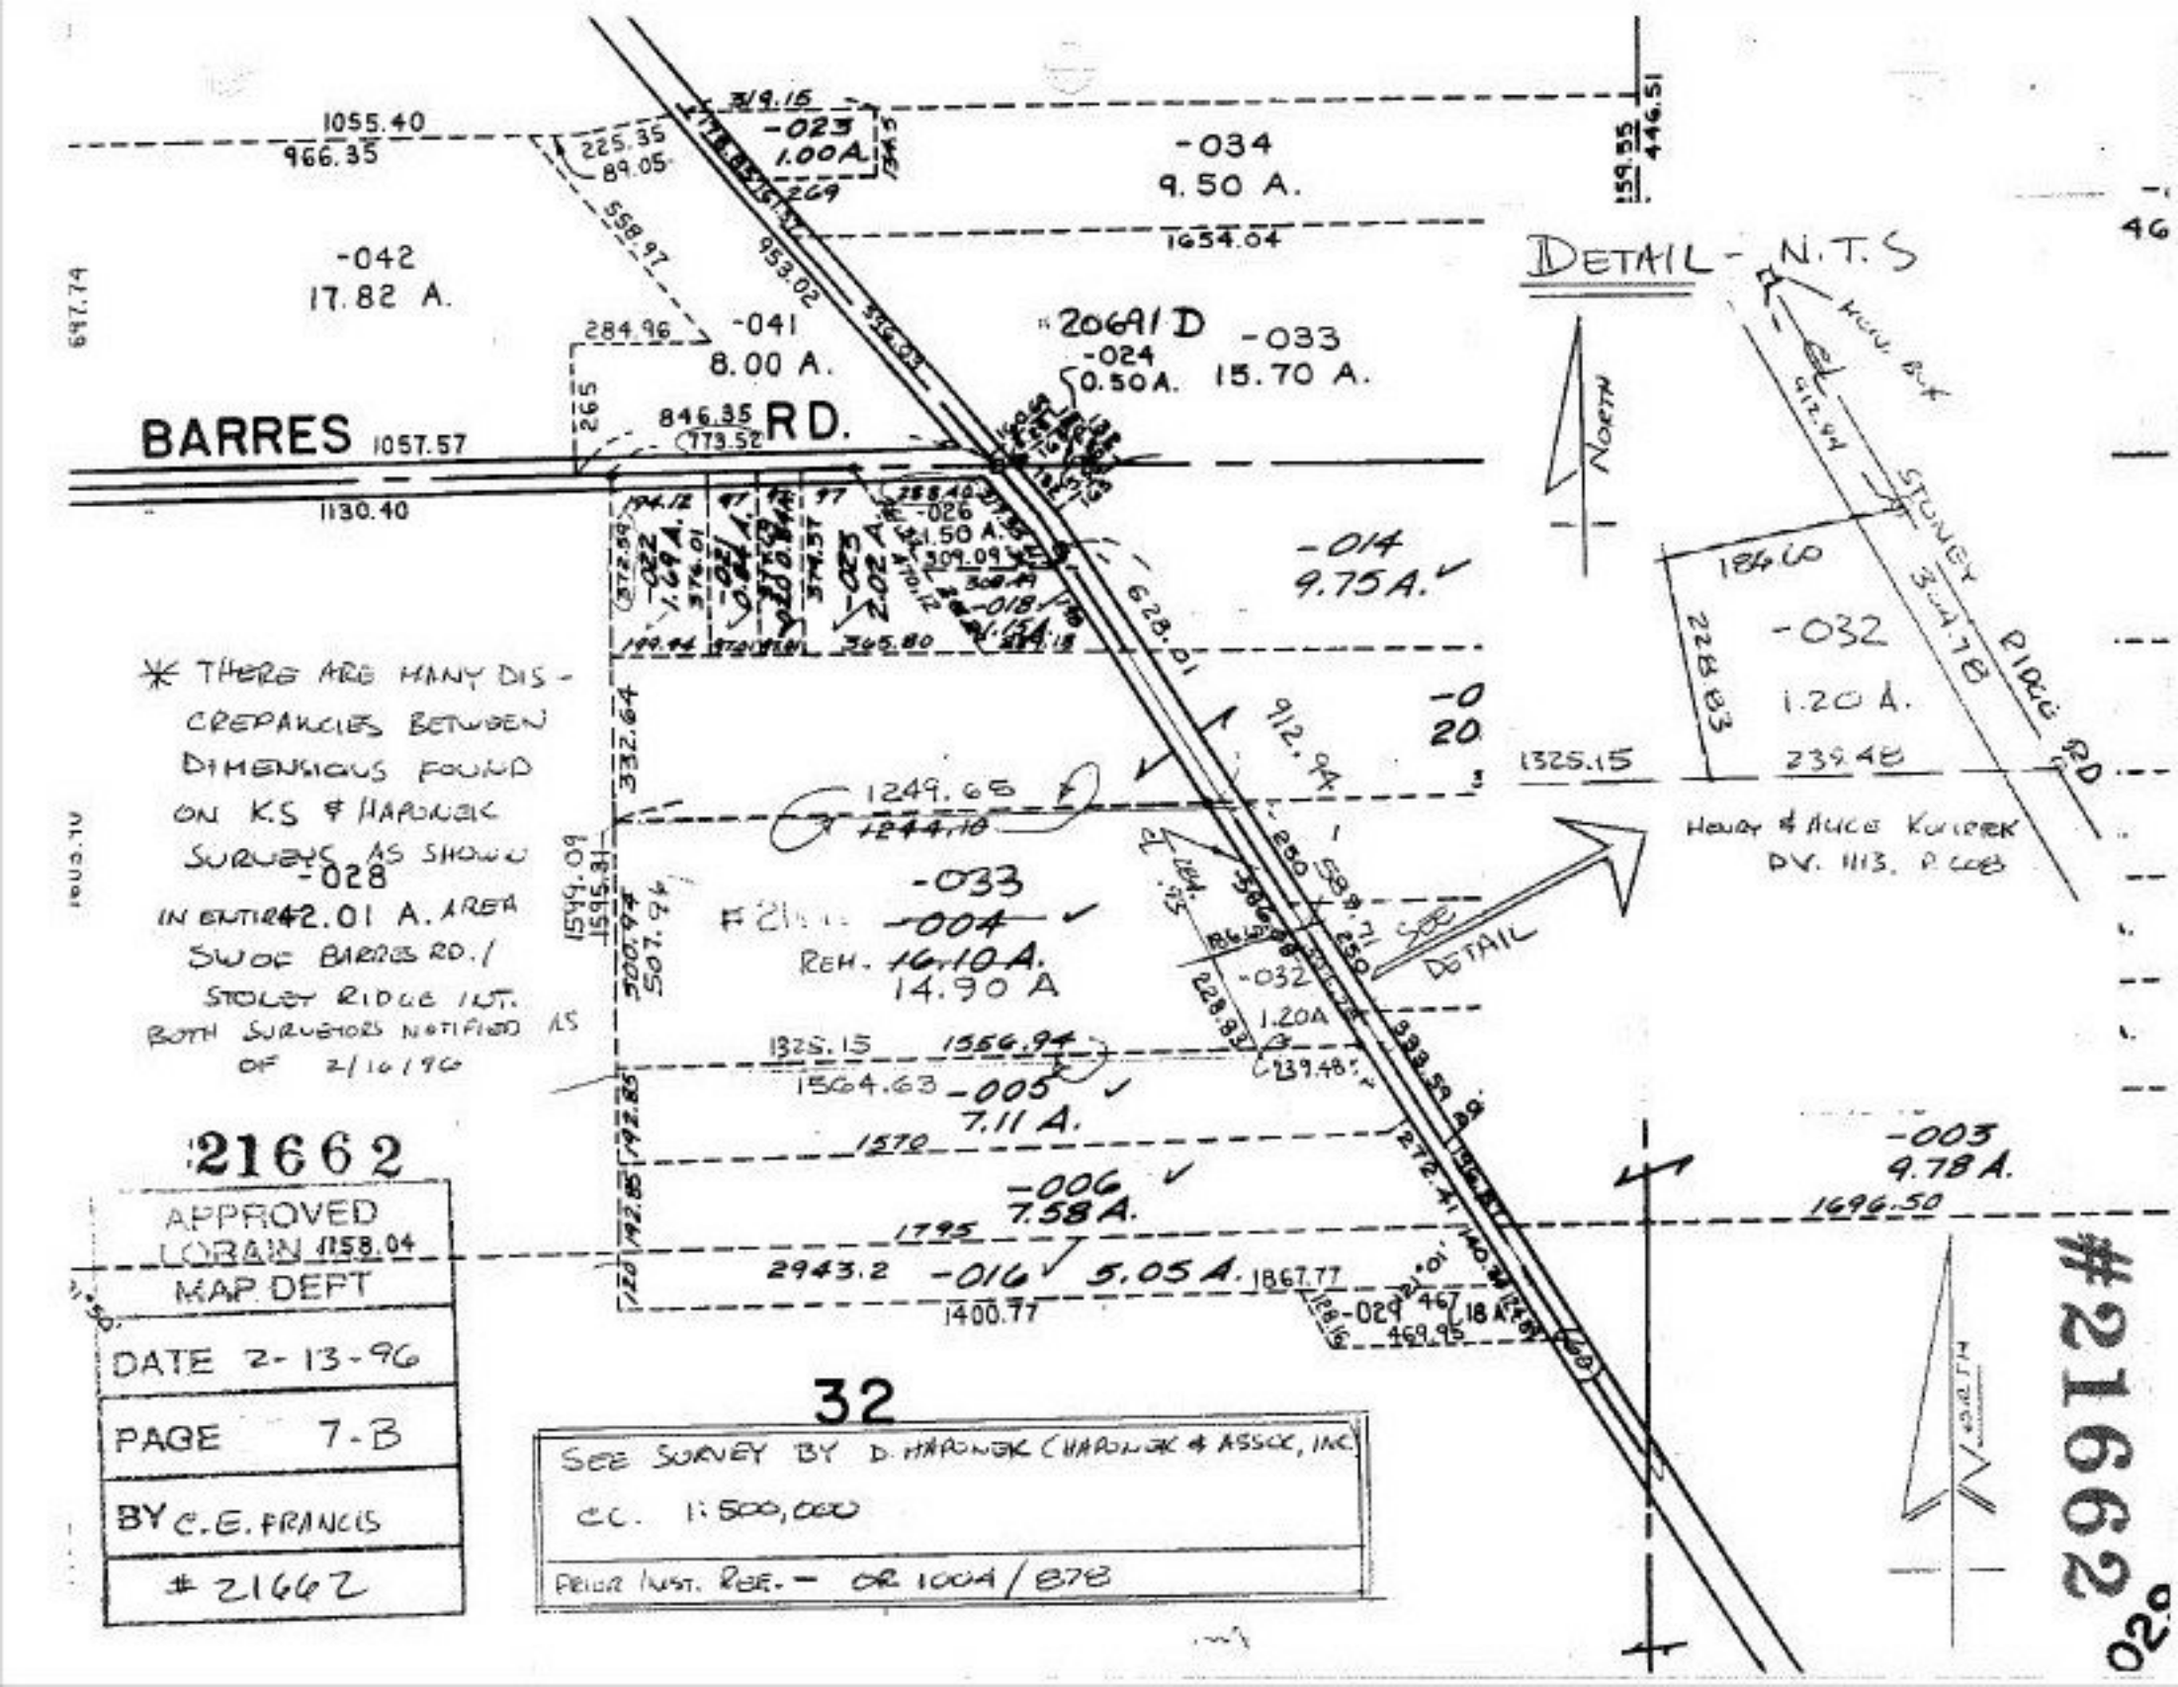

BARRES RD.
1055.40
966.35
-042
17.82 A.
-041
8.00 A.
-023
1.00 A.
-034
9.50 A.
1654.04
20691 D
-024
0.50 A.
-033
15.70 A.
846.35
773.52
1057.57
1130.40
-014
9.75 A.
-032
1.20 A.
1325.15
239.48
Henry & Alice Kurrek
DV. 1113, P. 608
-033
-004
REM. 16.10 A.
14.90 A
-032
1.20A
1249.65
1244.10
1325.15
1556.94
1564.63
-005
7.11 A.
1570
-006
7.58 A.
1795
2943.2
-016
5.05 A.
1867.77
1400.77
-029
-003
9.78 A.
1696.50
DETAIL - N.T.S
NORTH
STONEY RIDGE RD
SEE DETAIL
* THERE ARE MANY DISCREPANCIES BETWEEN DIMENSIONS FOUND ON K.S & HAPONEK SURVEYS AS SHOWN IN ENTIRE 42.01 A. AREA SW OF BARRES RD./ STONEY RIDGE INT. BOTH SURVEYORS NOTIFIED AS OF 2/16/96
21662
APPROVED
LORAIN 1158.04
MAP DEPT
DATE 2-13-96
PAGE 7-B
BY C.E. FRANCIS
21662
32
SEE SURVEY BY D. HAPONEK (HAPONEK & ASSOC, INC)
CC. 1:500,000
PRIOR INST. REF. - OR 1004/878
#21662