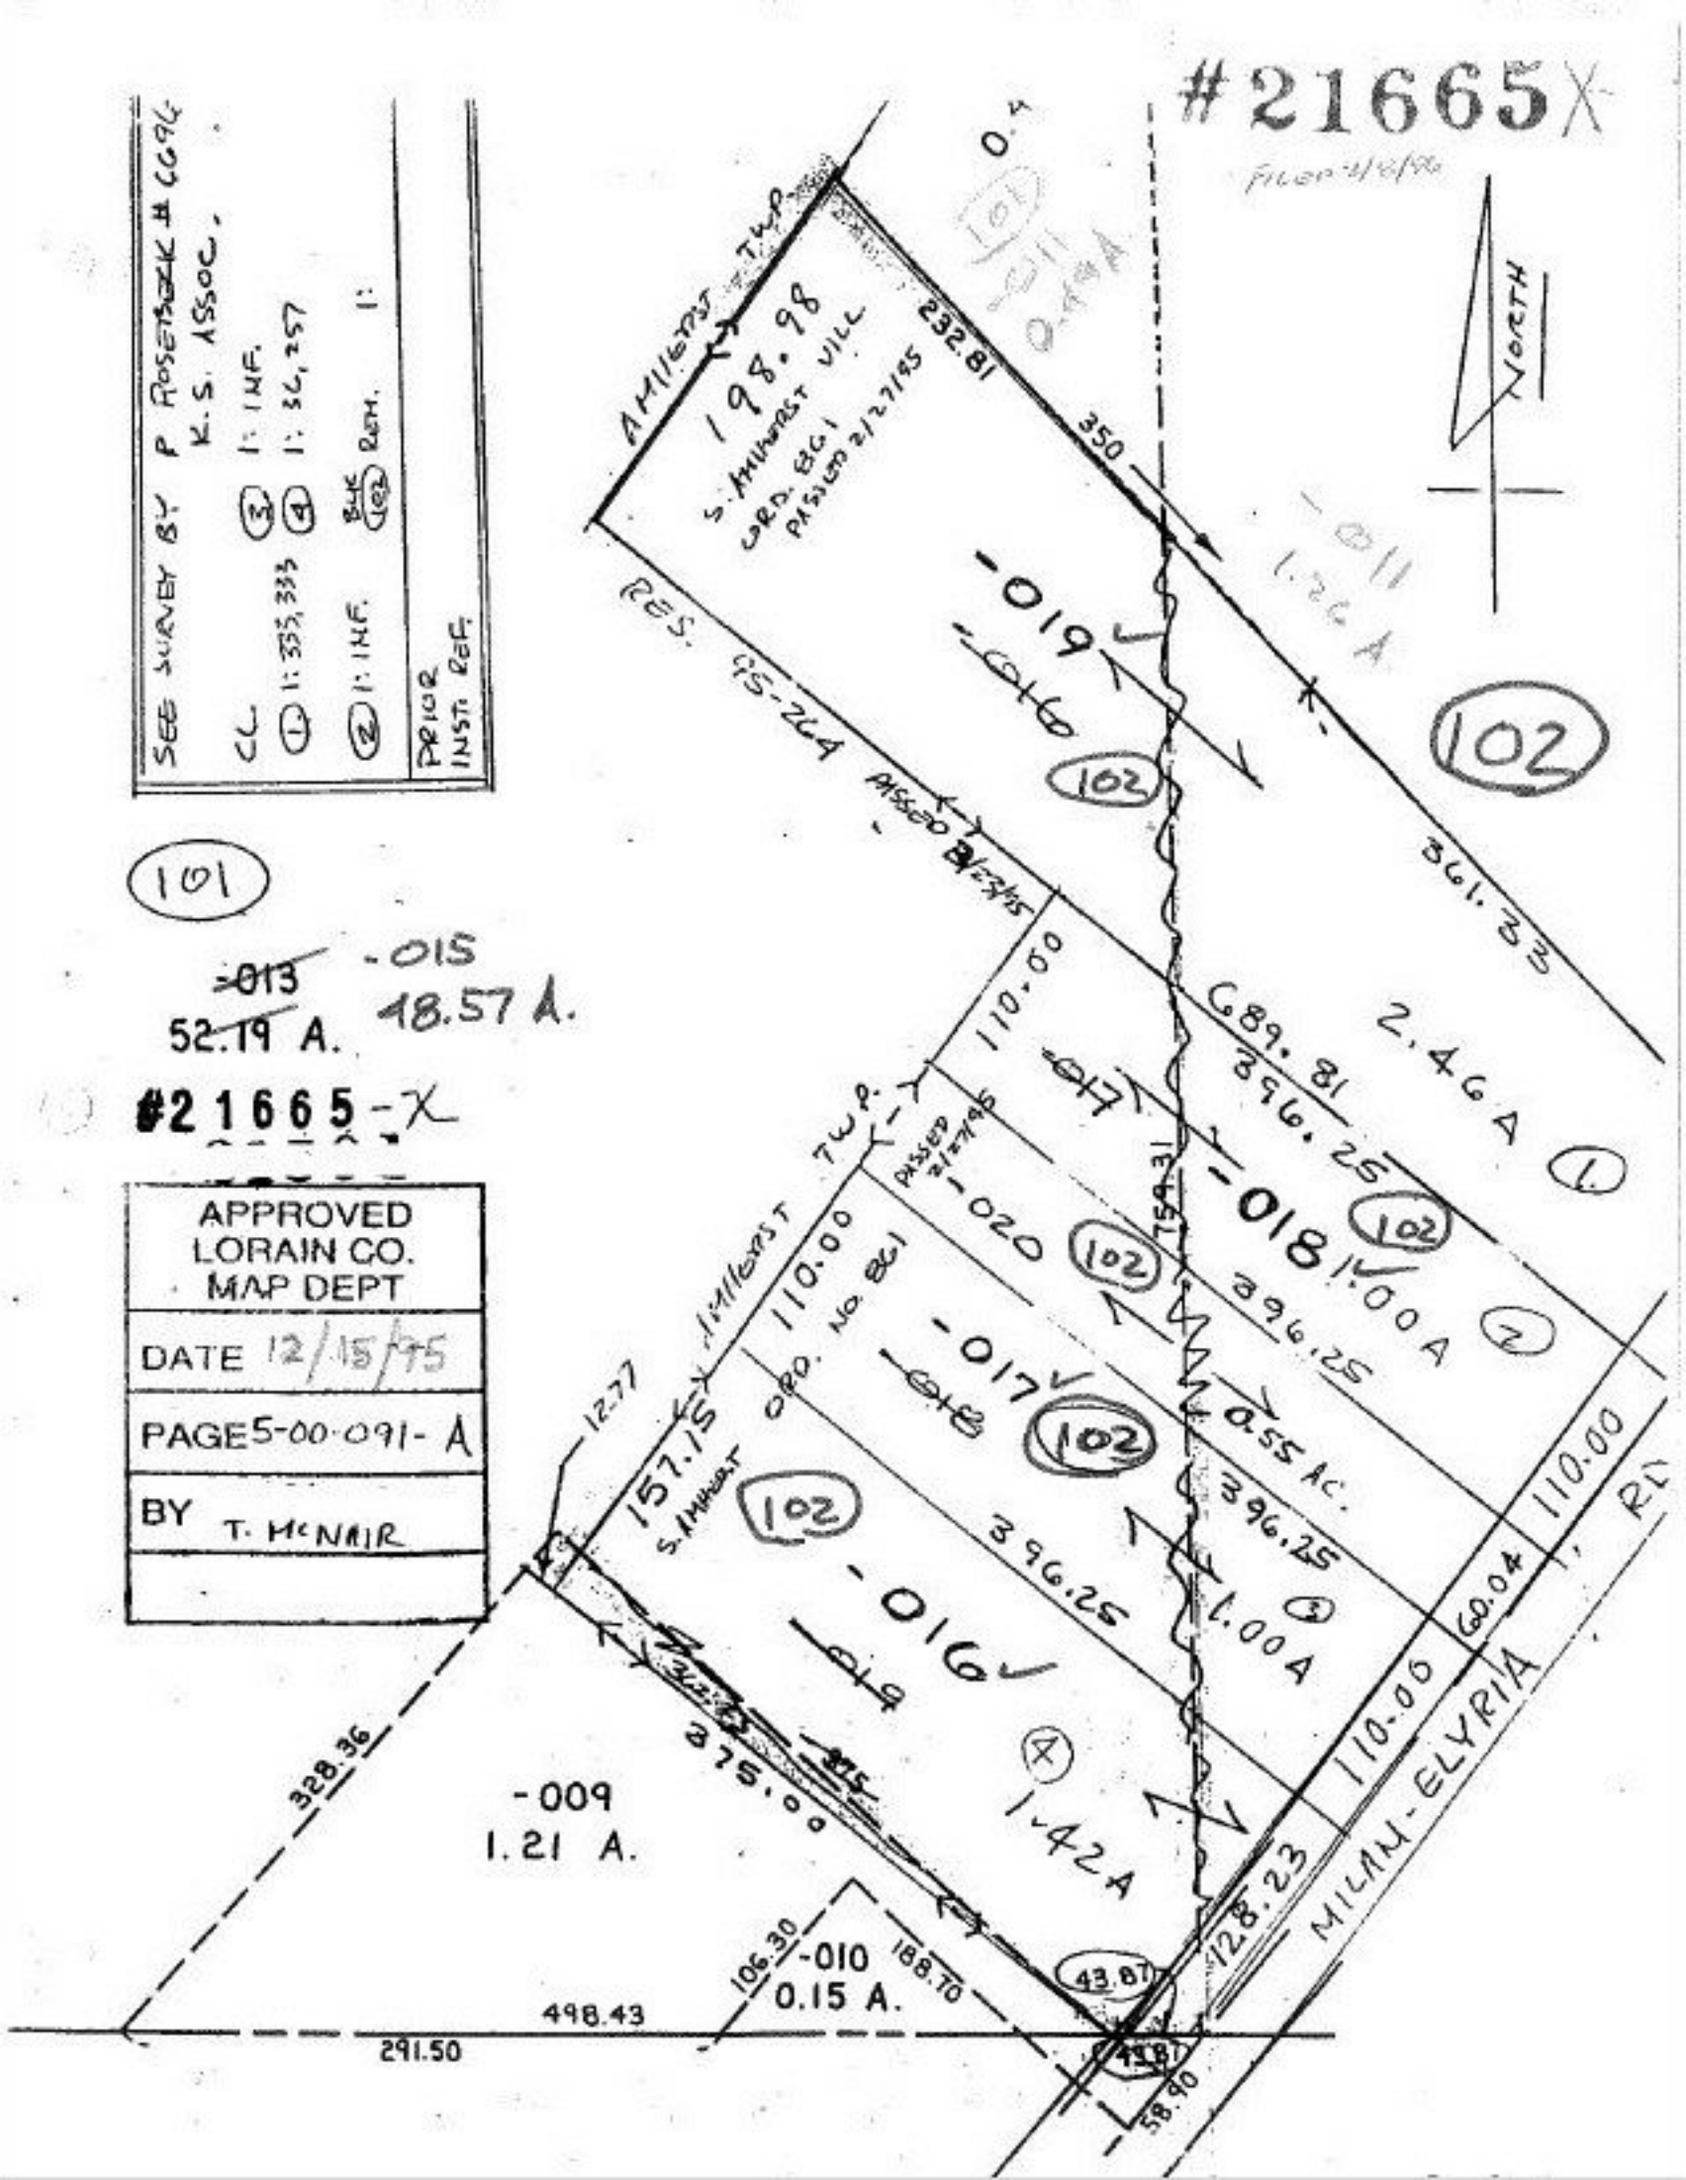
#21665X
SEE SURVEY BY P ROSEBECK # 6696
K.S. ASSOC.
CL
1: 333,333
1: INF.
1: 36,257
1: INF.
REM.
PRIOR INST. REF.
101
-013
52.19 A.
-015
48.57 A.
#21665-X
APPROVED
LORAIN CO.
MAP DEPT
DATE 12/15/95
PAGE 5-00-091-A
BY T. McNAIR
NORTH
AMHERST TWP.
198.98
S. AMHERST VILL
ORD. 861
PASSED 2/27/95
232.81
350
RES. 95-264
PASSED 2/27/95
-019
-016
102
361.33
2.46 A
689.81
396.25
-018
1.00 A
-017
-020
110.00
157.15
S. AMHERST
ORD. NO. 861
12.77
396.25
0.55 AC.
-016
-019
1.00 A
1.42 A
375.00
328.36
-009
1.21 A.
-010
0.15 A.
106.30
188.70
498.43
291.50
43.87
58.90
128.23
MILAN-ELYRIA
60.04
110.00
-011
1.26 A
0.49 A