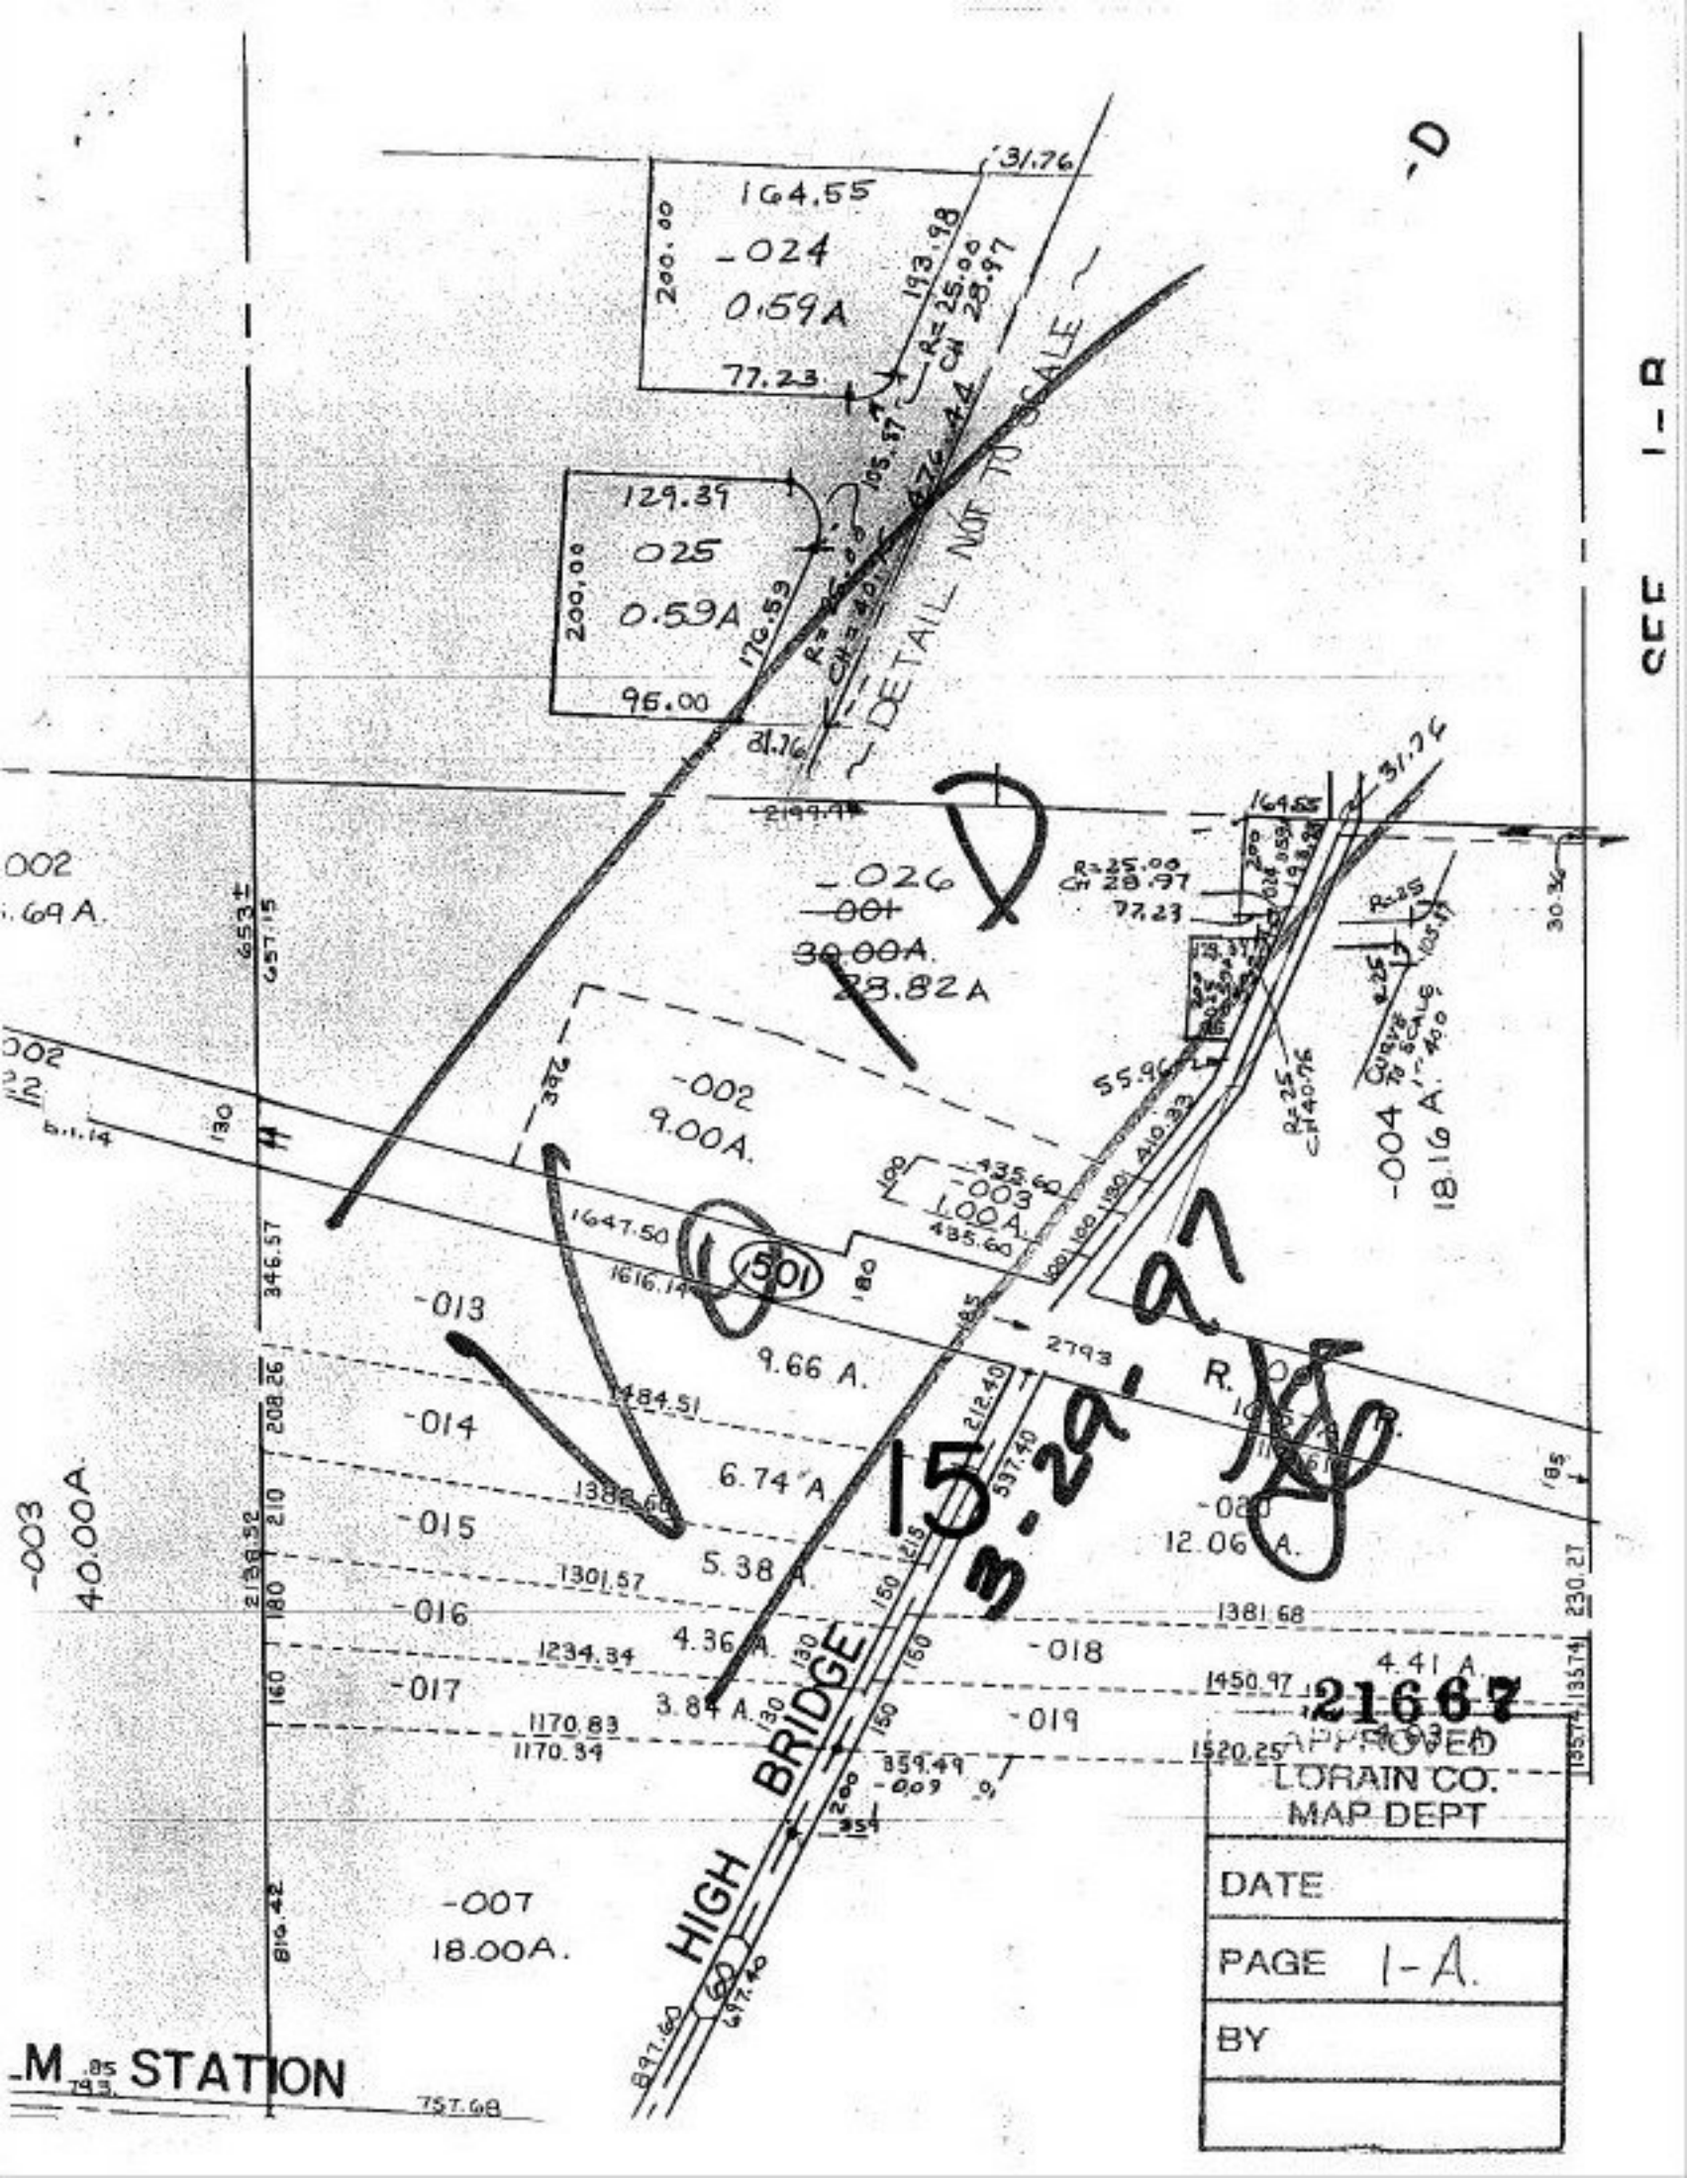
164.55
-024
0.59A
77.23
200.00
193.98
R=25.00
CH 28.97
31.76
129.39
025
0.59A
96.00
200.00
176.59
DETAIL NOT TO SCALE
-026
-001
30.00A.
28.82A
-002
9.00A.
-003
1.00A.
-004
18.16 A.
-013
9.66 A.
-014
6.74 A.
-015
5.38 A.
-016
4.36 A.
-017
3.84 A.
-018
4.41 A.
-019
4.93 A.
-020
12.06 A.
-007
18.00A.
-003
40.00A.
002
.69 A.
HIGH BRIDGE
STATION
15.29.97
21667
APPROVED
LORAIN CO.
MAP DEPT
DATE
PAGE 1-A.
BY
SEE 1-B