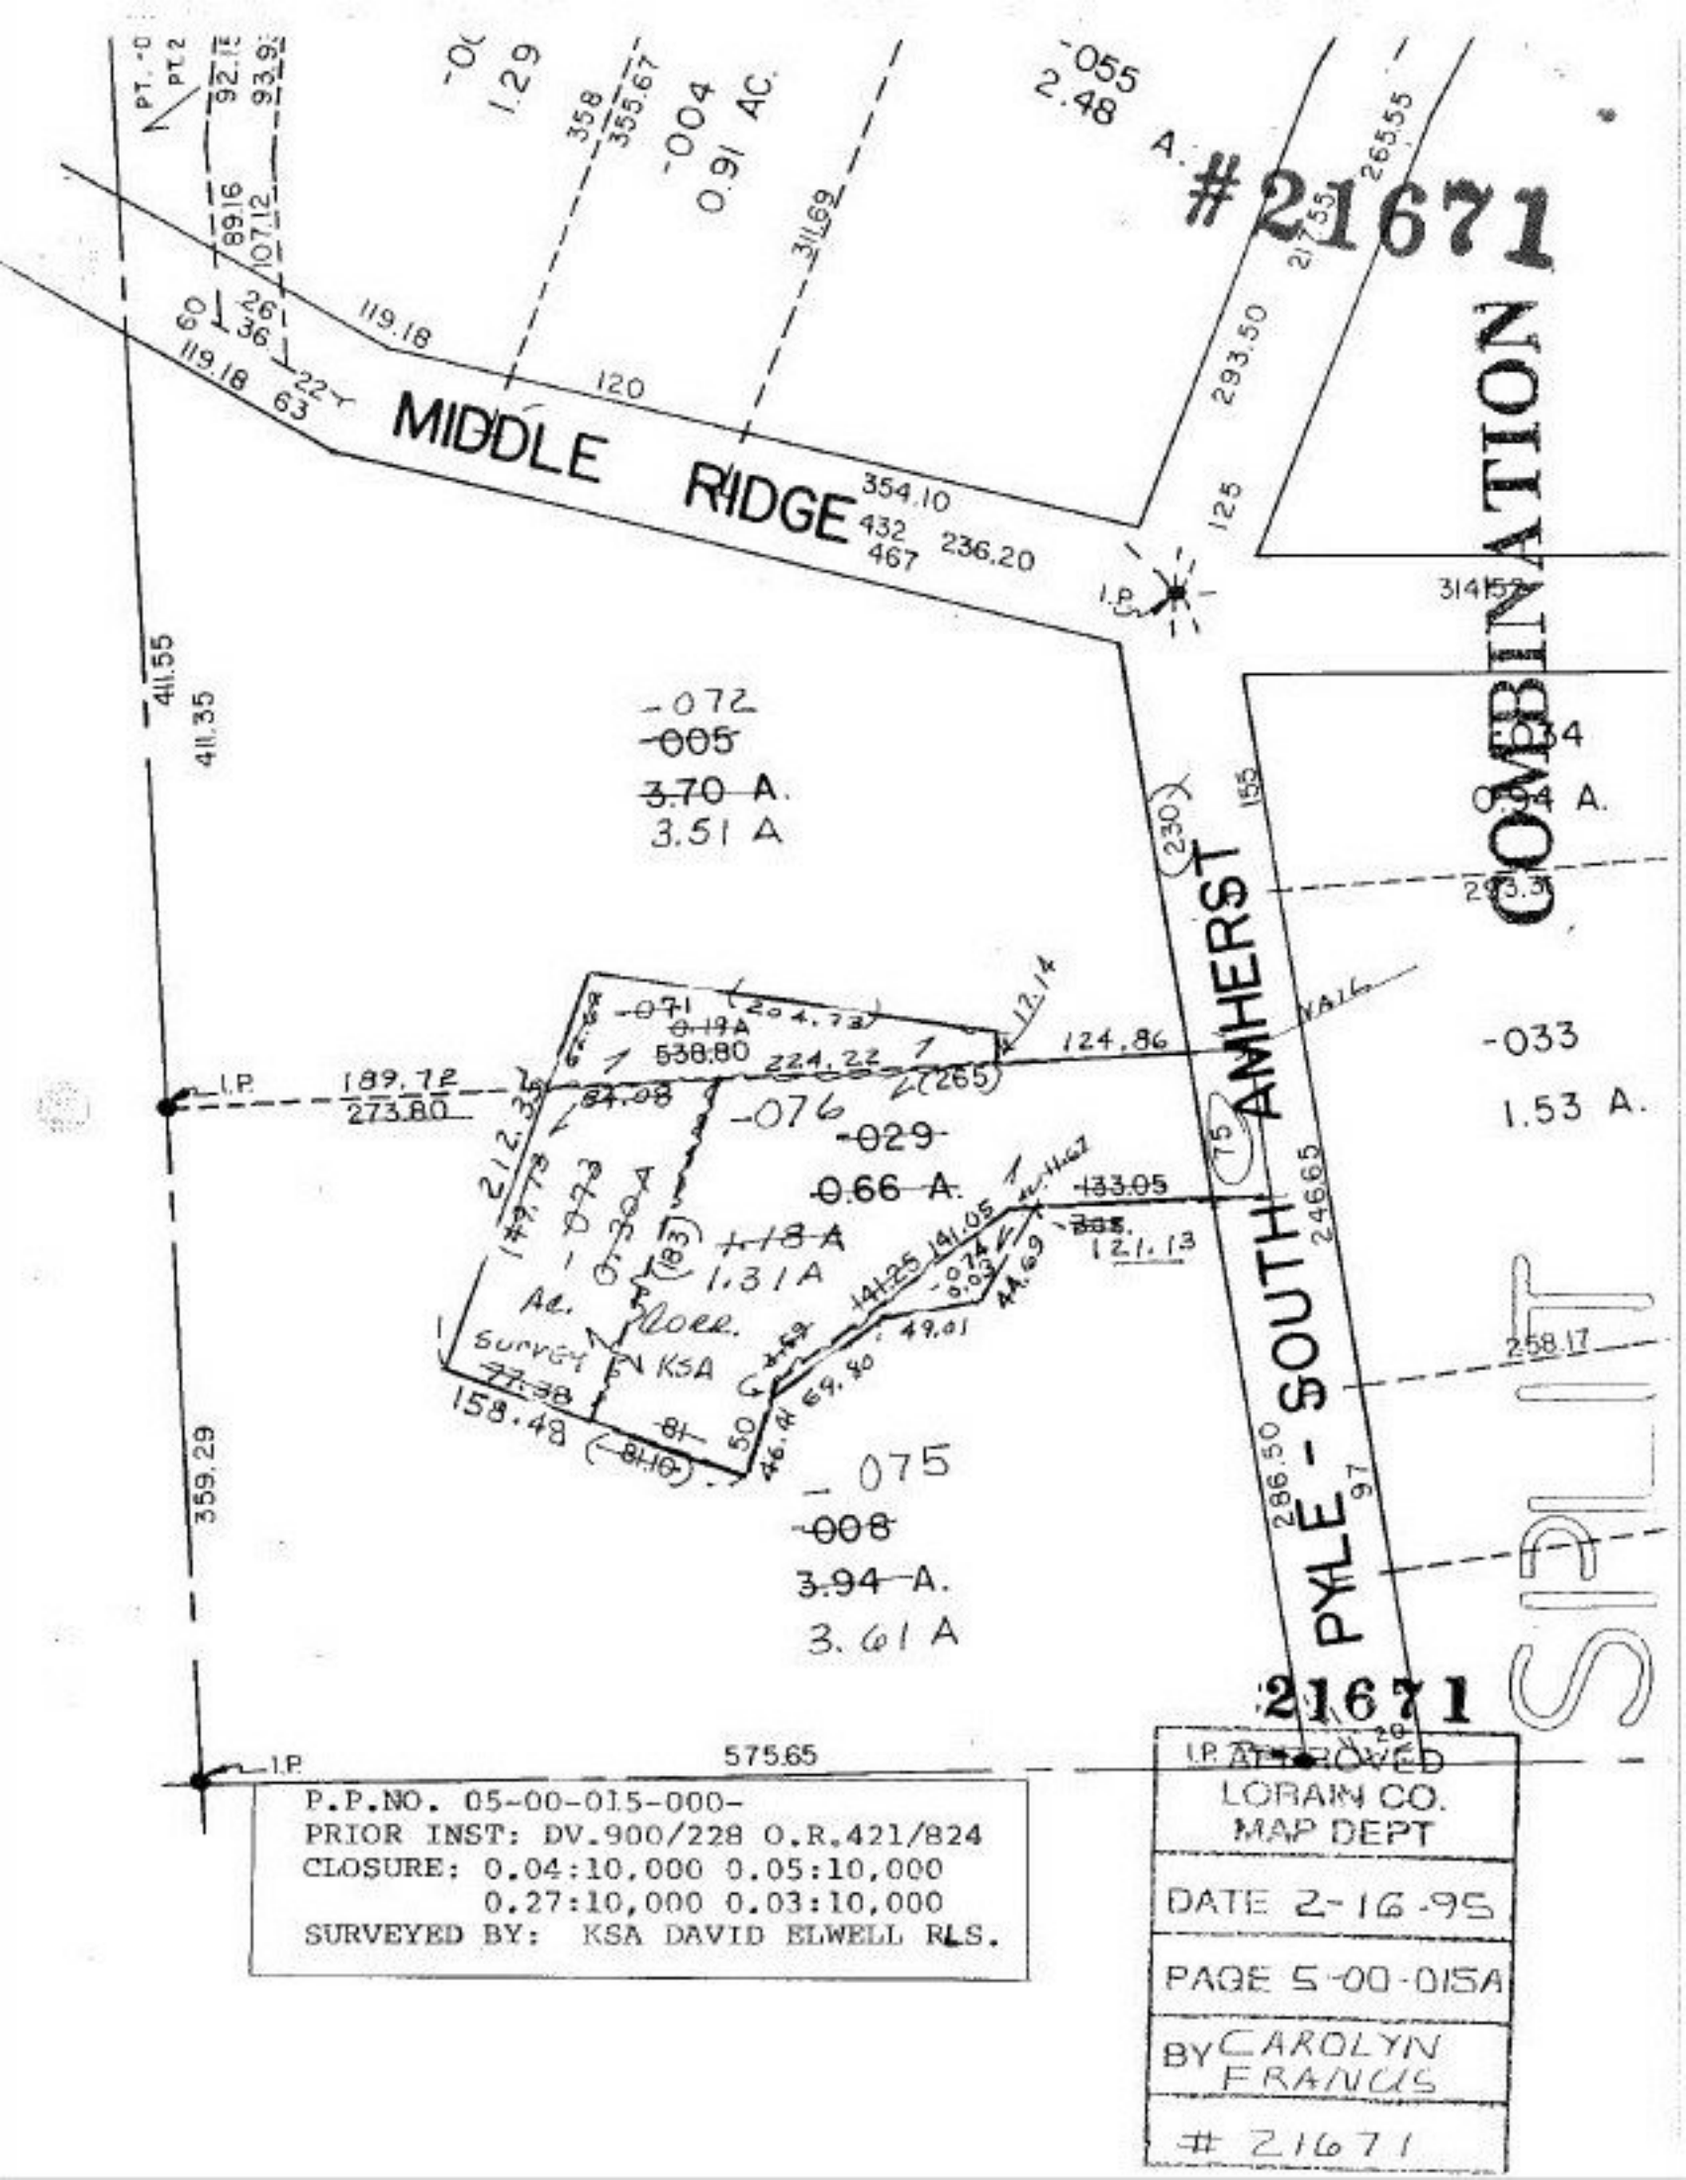
#21671
MIDDLE RIDGE
PYLE - SOUTH AMHERST
COMBINATION
-072
-005
3.70 A.
3.51 A
-071
0.19A
538.80
-076
-029-
0.66 A.
-073
0.30A
1.31A
-075
-008
3.94 A.
3.61 A
-033
1.53 A.
Ac. Mea.
Survey
KSA
158.48
124.86
121.13
575.65
359.29
411.55
411.35
I.P.
P.P.NO. 05-00-015-000-
PRIOR INST: DV.900/228 O.R.421/824
CLOSURE: 0.04:10,000 0.05:10,000
0.27:10,000 0.03:10,000
SURVEYED BY: KSA DAVID ELWELL RLS.
I.P. APPROVED
LORAIN CO.
MAP DEPT
DATE 2-16-95
PAGE 5-00-015A
BY CAROLYN FRANCIS
21671
21671
SPLIT