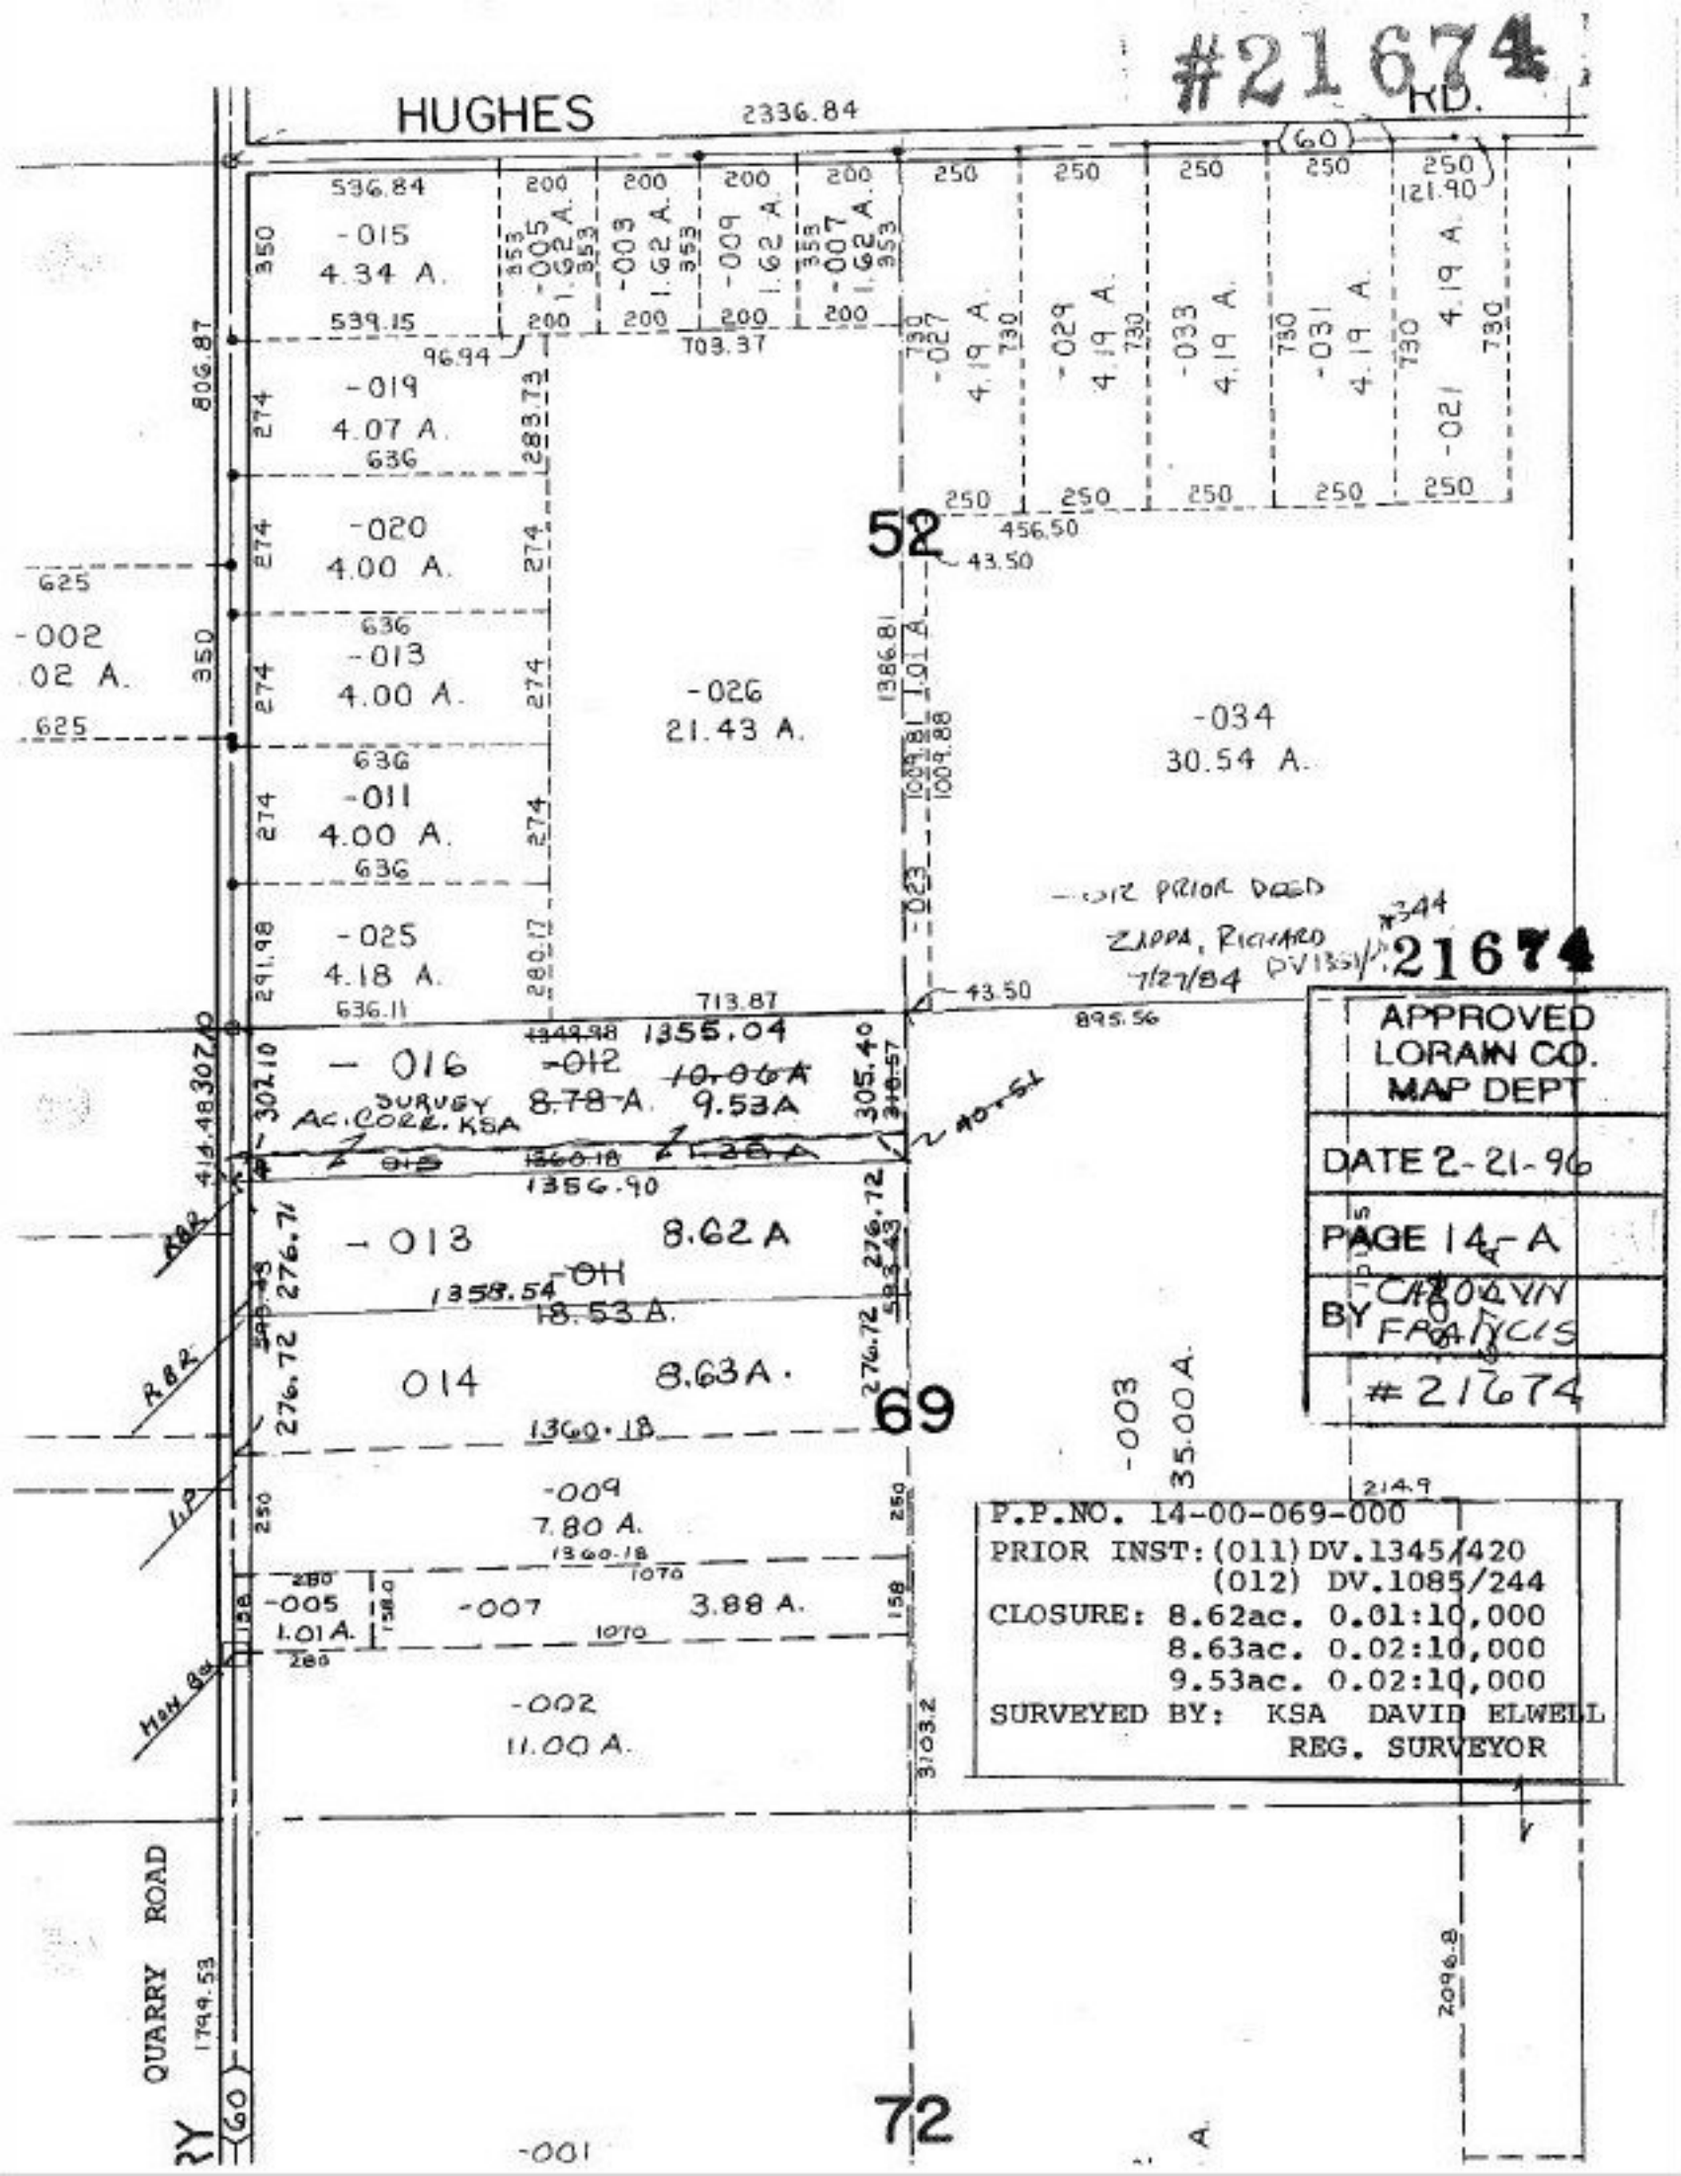
#21674
HUGHES RD.
2336.84
-015
4.34 A.
-019
4.07 A.
-020
4.00 A.
-013
4.00 A.
-011
4.00 A.
-025
4.18 A.
-002
.02 A.
-026
21.43 A.
-034
30.54 A.
52
-012 PRIOR DEED
ZAPPA, RICHARD
7/27/84
#344
21674
-016
SURVEY
AC. CORR. KSA
-012
8.78 A.
1355.04
10.06 A
9.53 A
-013
8.62 A
-011
18.53 A.
014
8.63 A.
69
-003
35.00 A.
-009
7.80 A.
-005
1.01 A.
-007
3.88 A.
-002
11.00 A.
QUARRY ROAD
72
-001
APPROVED
LORAIN CO.
MAP DEPT
DATE 2-21-96
PAGE 14-A
BY CAROLYN FRANCIS
#21674
P.P.NO. 14-00-069-000
PRIOR INST: (011) DV.1345/420
(012) DV.1085/244
CLOSURE: 8.62ac. 0.01:10,000
8.63ac. 0.02:10,000
9.53ac. 0.02:10,000
SURVEYED BY: KSA DAVID ELWELL
REG. SURVEYOR