#21675

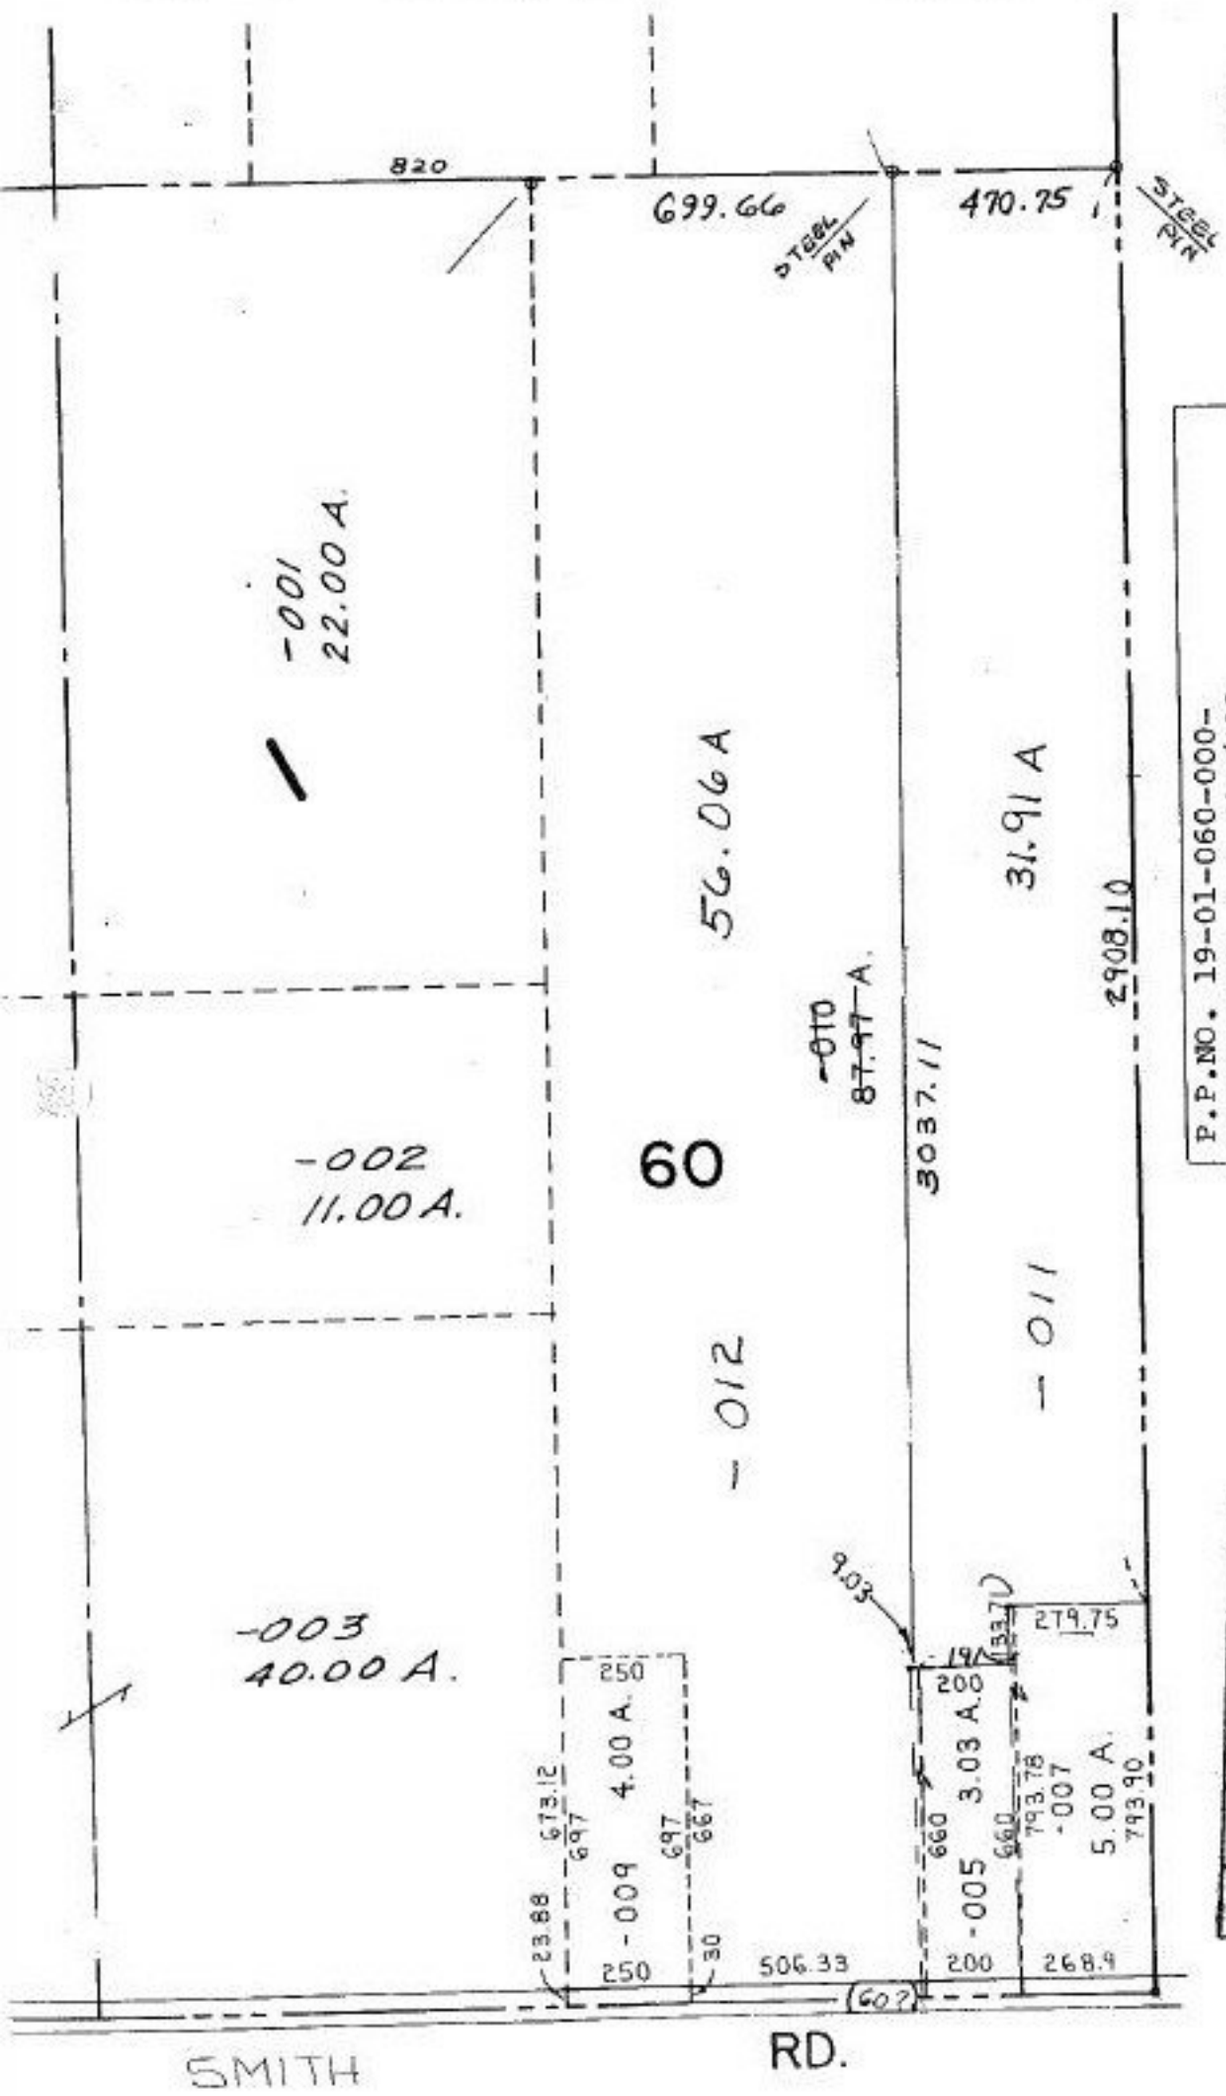

P.P.NO. 19-01-060-000-
PRIOR INST: O.R.580/231
CLOSURE: 0.01:10,000
SURVEYED BY: BRUCE D. ECKELBERRY
REG. SURVEYOR

21675

APPROVED
LORAIN CO.
MAP DEPT

DATE 2-21-96

PAGE 19-H

BY CAROLYN FRANCIS

#21675