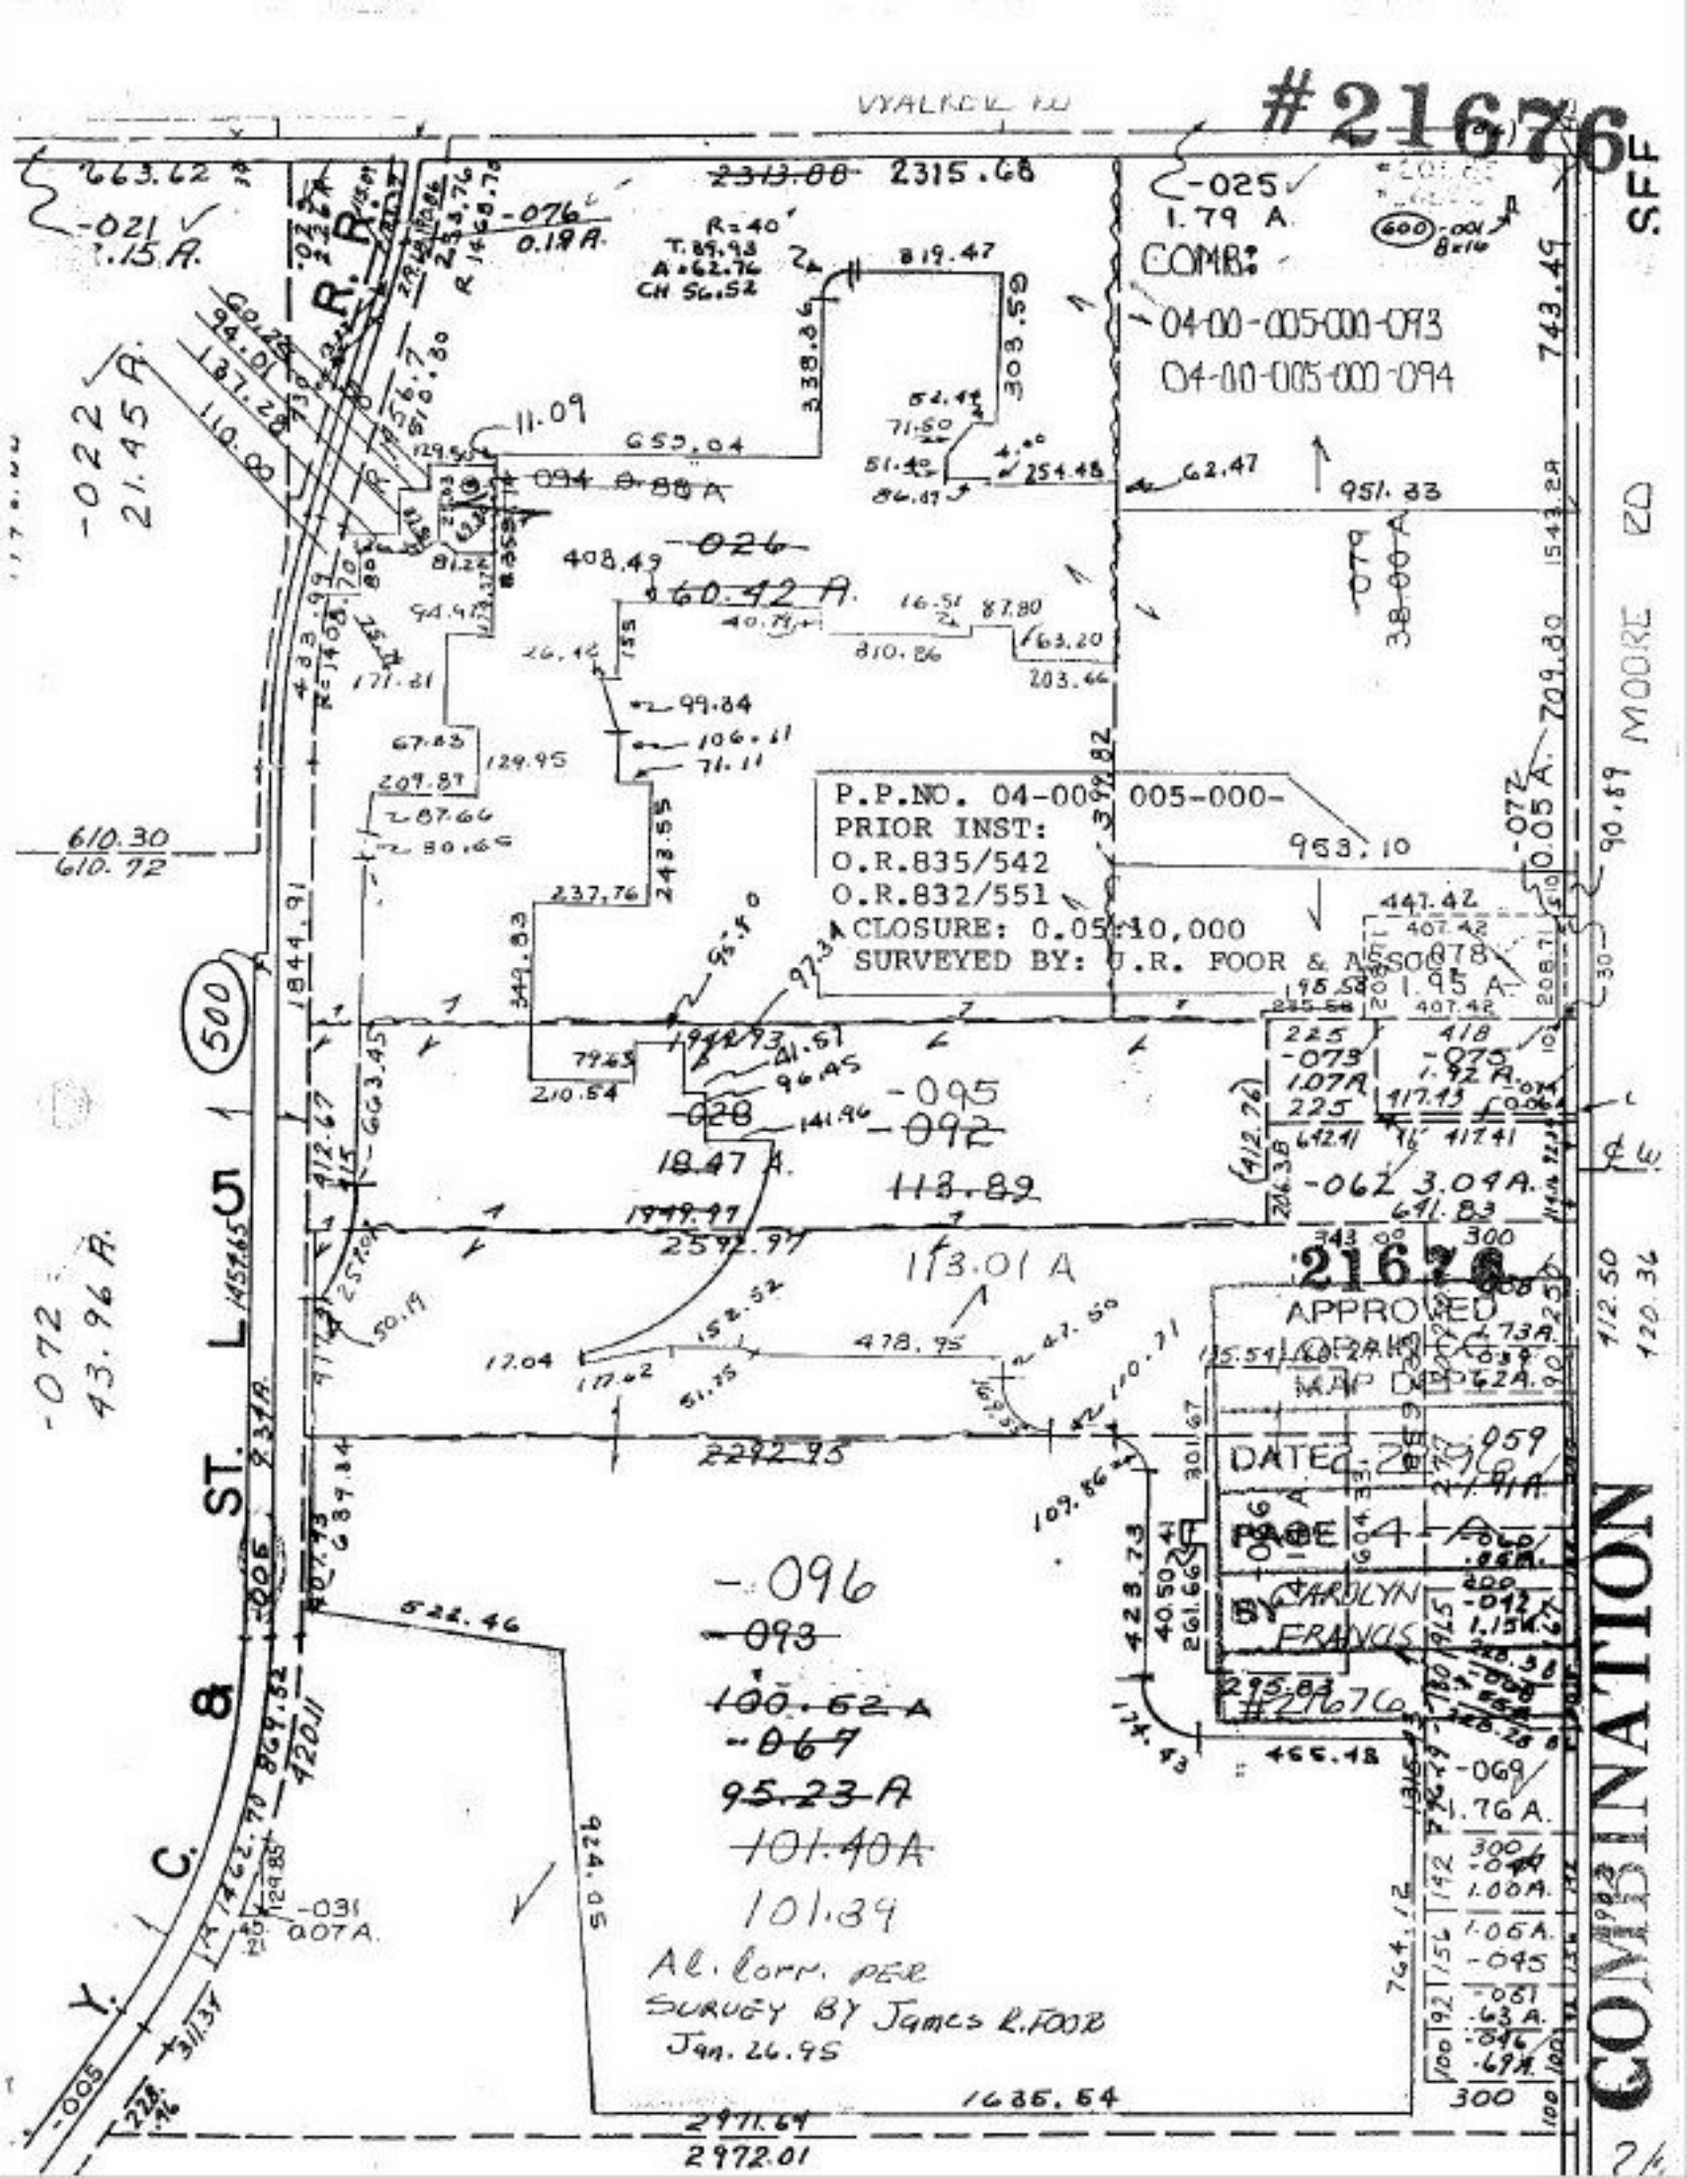
#21676
VYALRCL RD
663.62
-021
1.15 A.
-022
21.45 A.
R.R.
-076
0.18 A.
R=40'
T.89.93
A=62.76
CH 56.52
2313.00
2315.68
819.47
338.36
303.59
-025
1.79 A.
COMB:
04-00-005-000-093
04-00-005-000-094
743.45
951.83
62.47
254.48
650.04
094 0.88 A
11.09
408.49
-026
60.42 A.
40.71±
810.86
203.44
-079
38.00 A.
1543.29
709.80
-077
0.05 A.
90.89
MOORE RD
P.P.NO. 04-00 005-000-
PRIOR INST:
O.R.835/542
O.R.832/551
CLOSURE: 0.05 10,000
SURVEYED BY: U.R. POOR & ASSOC
963.10
610.30
610.72
1844.91
500
-095
-092
118.89
18.47 A.
1949.97
2592.97
113.01 A
478.95
2292.93
-062
3.09 A.
641.83
-075
1.92 A.
-073
1.07 A.
-078
1.95 A.
216.76
APPROVED
MAP DATED
DATED
PAGE
CAROLYN
FRANCIS
#21676
-059
1.91 A.
-060
.96 A.
-069
1.76 A.
-045
1.06 A.
1.00 A.
-081
.63 A.
-046
.69 A.
300
-096
-093
100.62 A
-067
95.23 A
101.40 A
101.39
Al. corr. per
SURVEY BY James R. POOR
Jan. 26.95
S. SFF
COMBINATION
S. L. C. & R. R. ST.
-031
0.07 A.
-005
1686.64
2971.64
2972.01