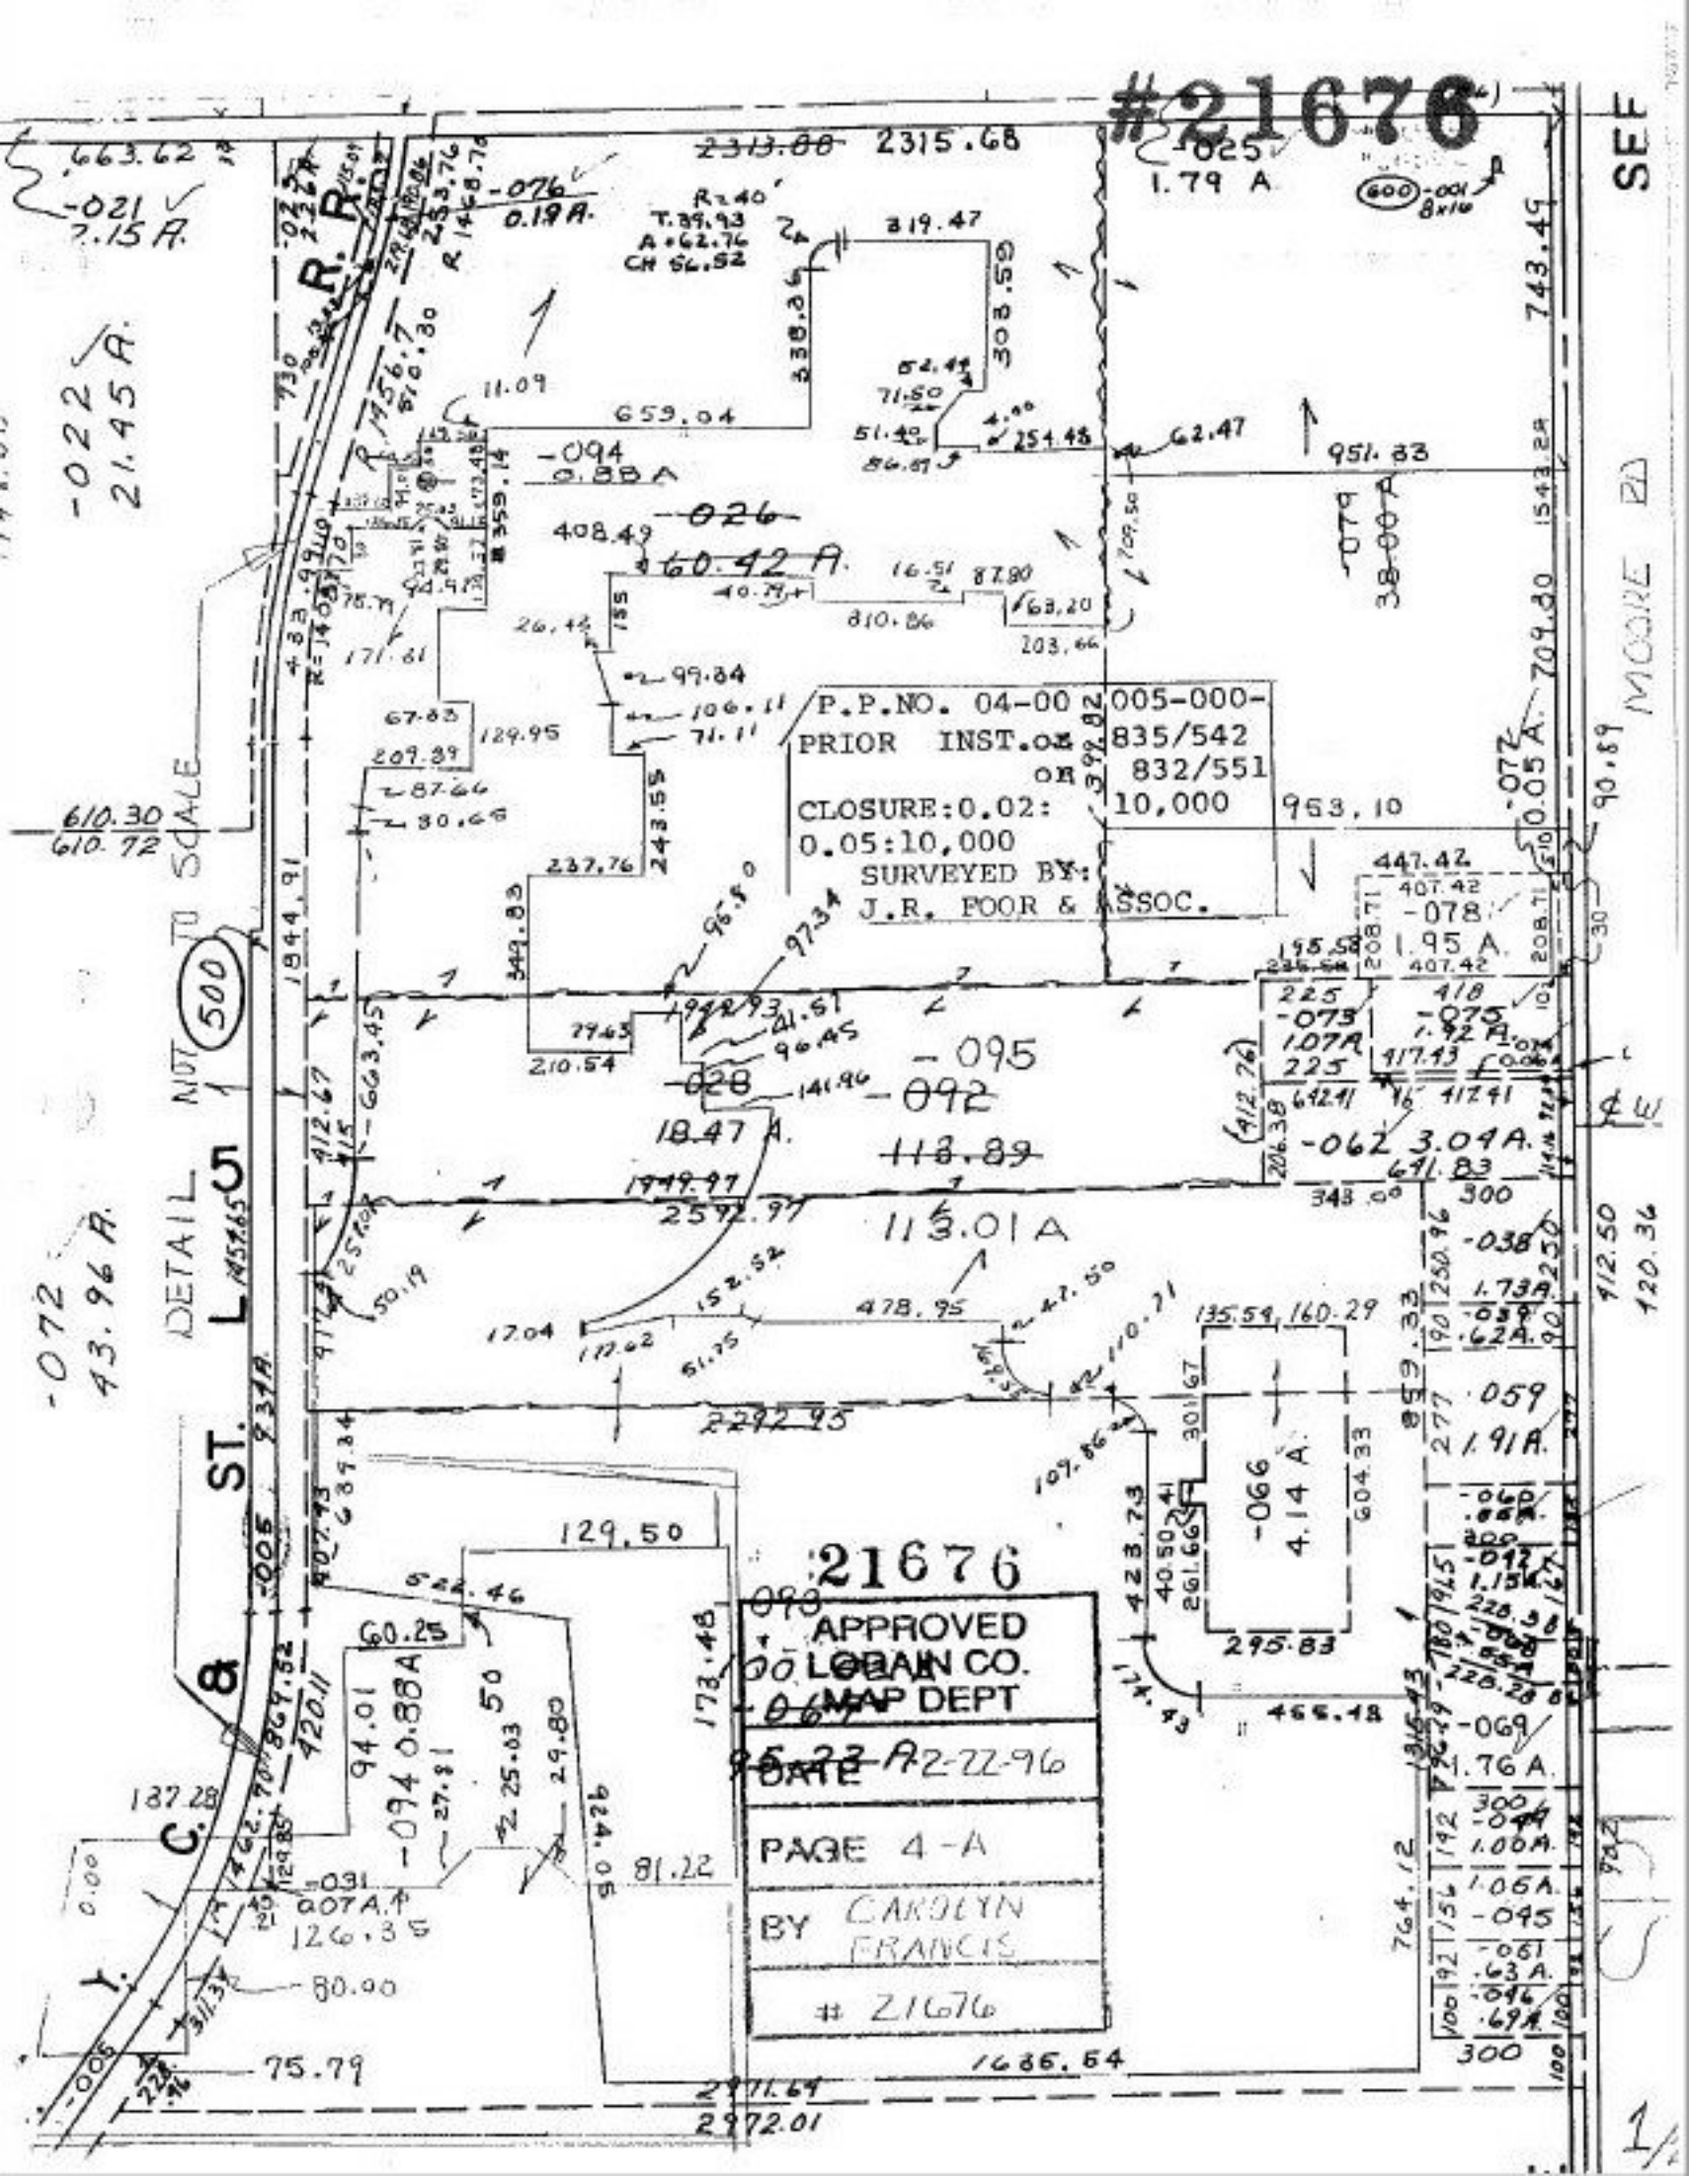
#21676
P.P.NO. 04-00 005-000-
PRIOR INST.ON 835/542
ON 832/551
CLOSURE:0.02: 10,000
0.05:10,000
SURVEYED BY:
J.R. POOR & ASSOC.
APPROVED
LORAIN CO.
MAP DEPT
DATE 2-22-96
PAGE 4-A
BY CAROLYN FRANCIS
21676
DETAIL NOT TO SCALE
C. & L. ST.
R.R.
MOORE RD
SEE