#21679

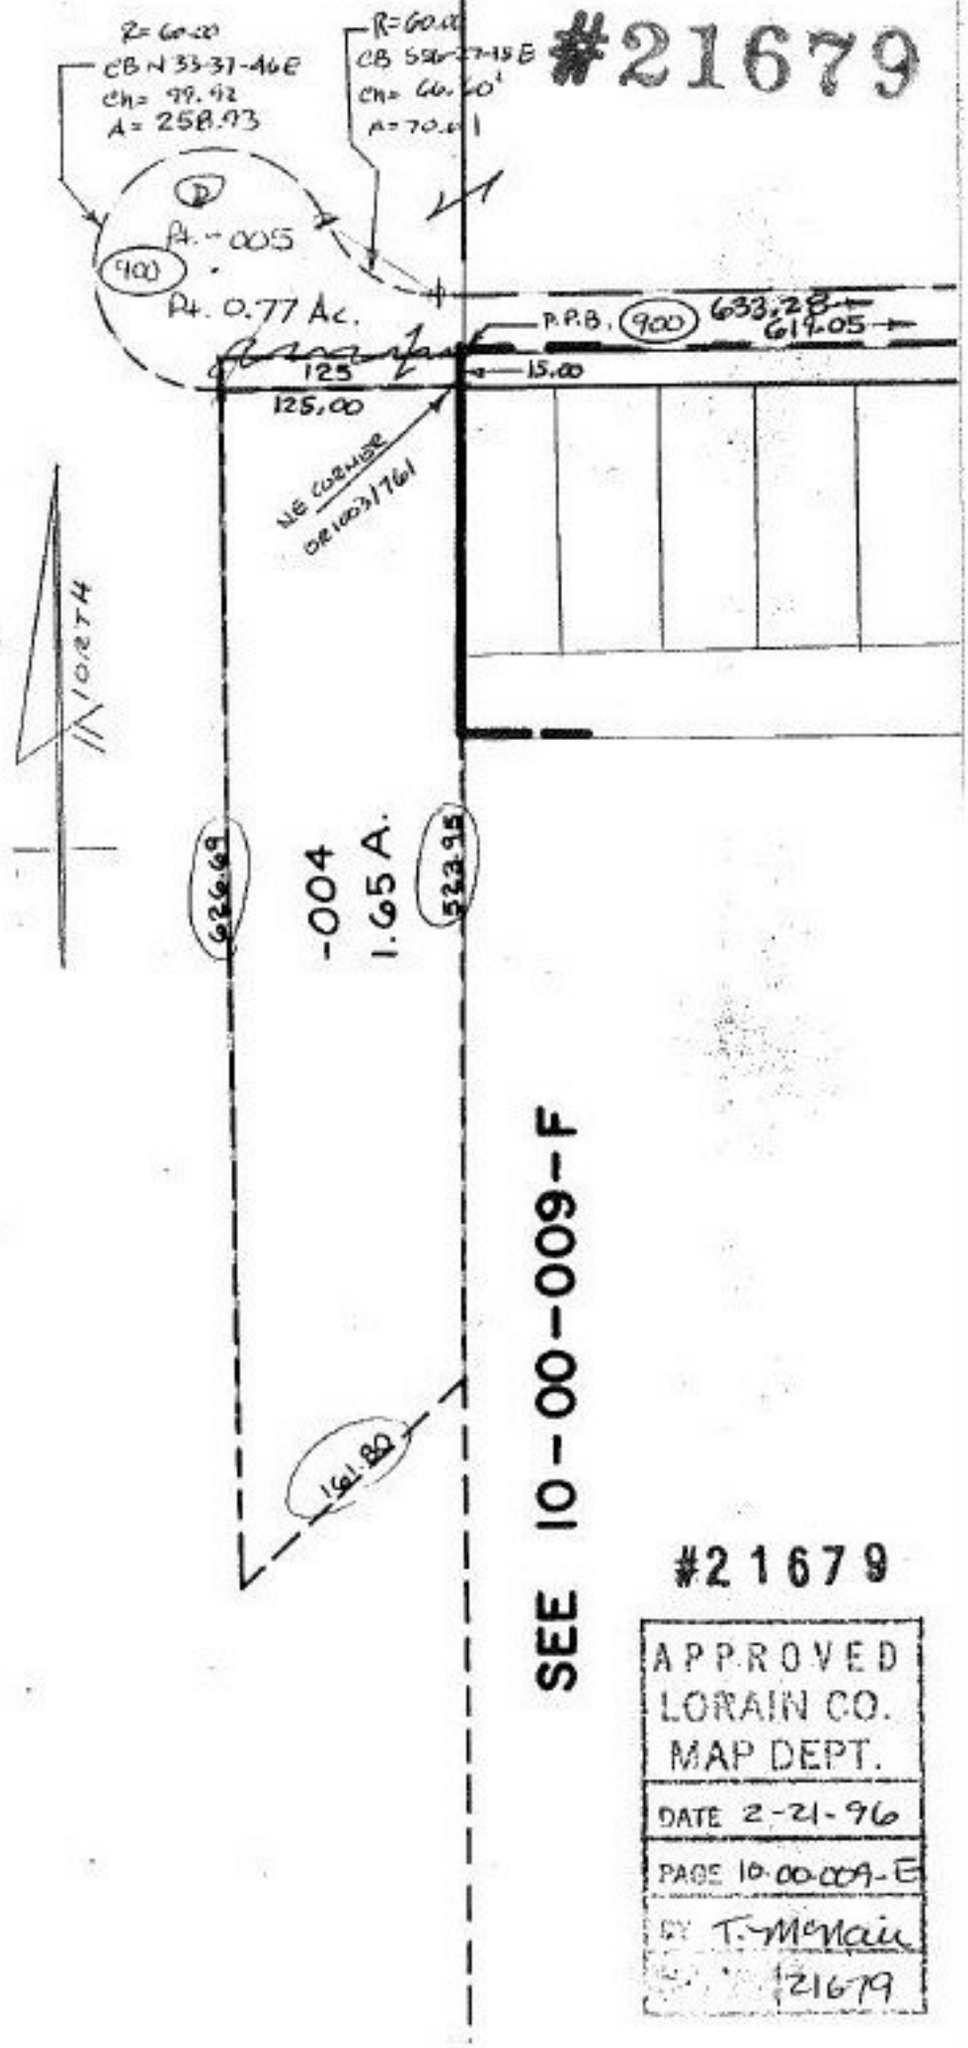

Pt. ~~-001~~

Pt. ~~75.79 Ac.~~

L.N.B FOR VIRGINIA R. PARKER
OR 836/308

10-00-009 - 118 -

REM.

Pt. -006

Pt. 75.02 A.

#21679

APPROVED
LORAIN CO.
MAP DEPT.

DATE 2-21-96

PAGE 10-00-009-E

BY T. McNair

21679