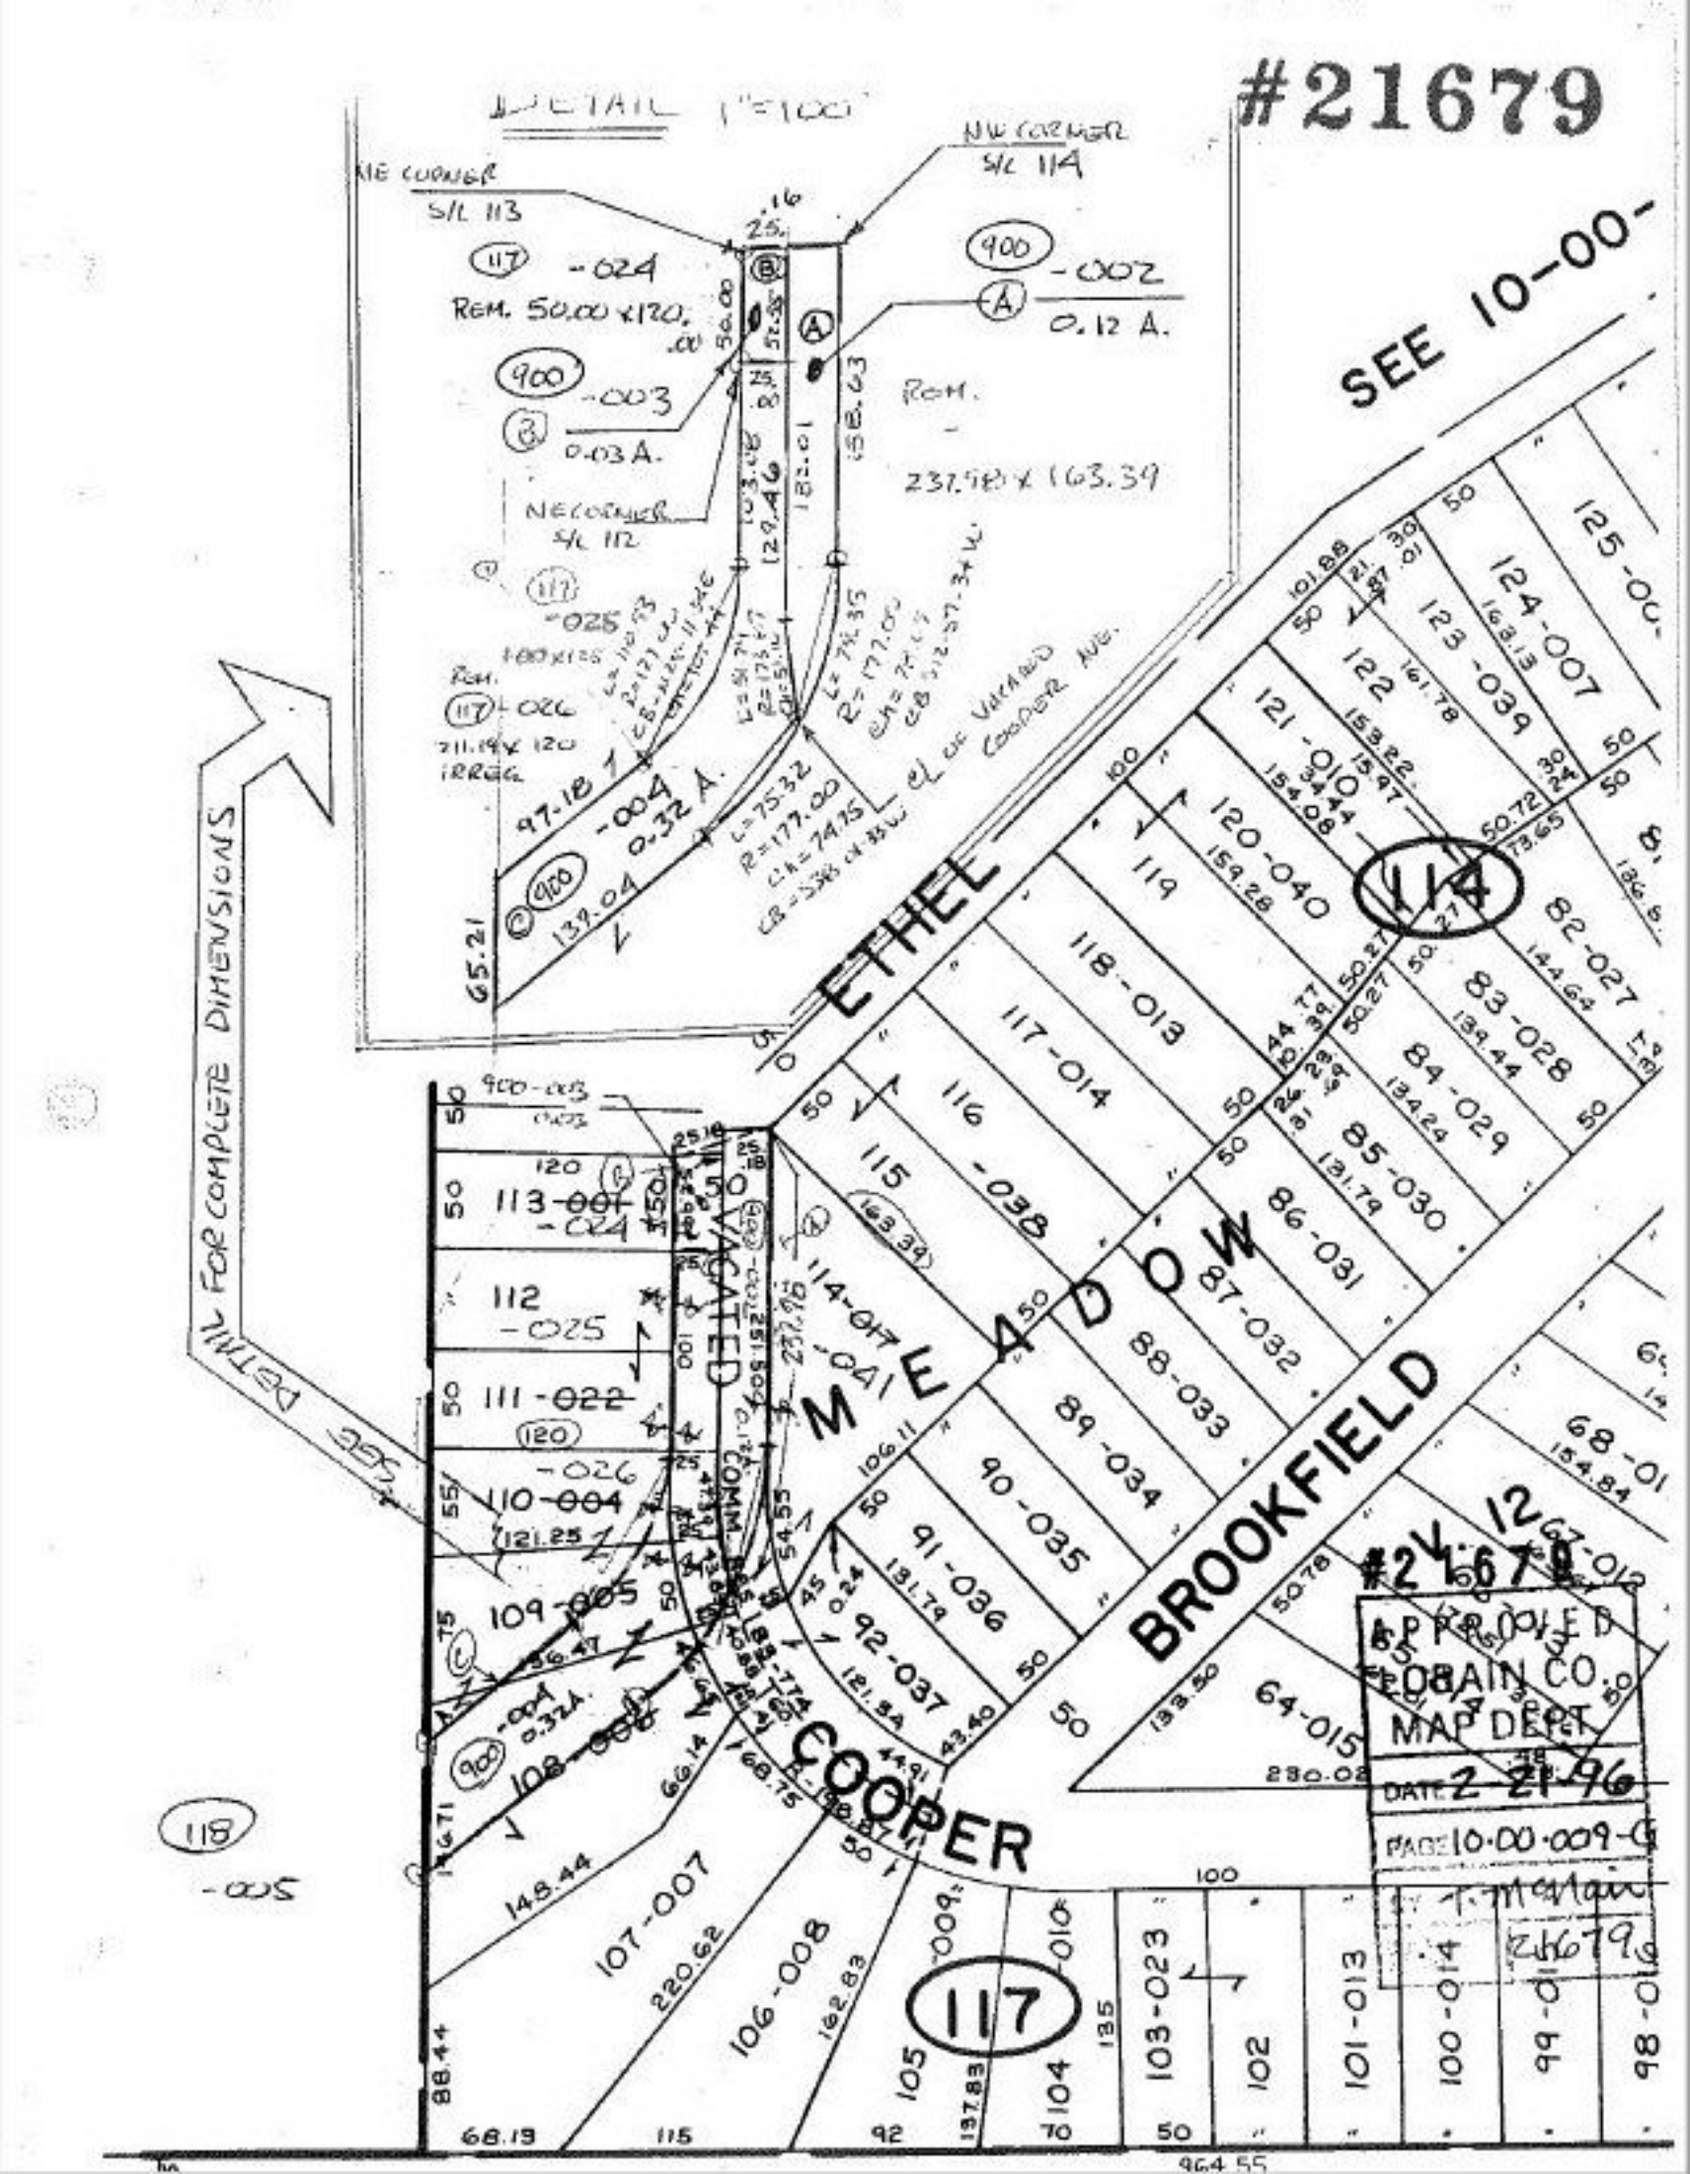
#21679
DETAIL 1"=100'
NE CORNER S/L 113
NW CORNER S/L 114
117 -024
REM. 50.00 x 120.
900 -002
0.12 A.
900 -003
0.03 A.
REM.
237.98 x 163.39
NE CORNER S/L 112
117 -025
REM.
117 -026
211.19 x 120
IRREG.
97-18
-004
0.32 A.
900
139.04
65.21
SEE 10-00-
ETHEL
MEADOW
BROOKFIELD
COOPER
VACATED
114
117
118
-005
SEE DETAIL FOR COMPLETE DIMENSIONS
113 -001
-024
112
-025
111 -022
120
-026
110 -004
121.25
109 -005
108 -006
107-007
106-008
105
104
103-023
102
101-013
100-014
99-01
98-01
115
116
-038
117-014
118-013
119
120-040
121-010
122
123-039
124-007
125-00
82-027
83-028
84-029
85-030
86-031
87-032
88-033
89-034
90-035
91-036
92-037
68-01
67-012
64-015
#21679
APPROVED
LORAIN CO.
MAP DEPT.
DATE 2-21-96
PAGE 10-00-009-G
T. McMain
21679