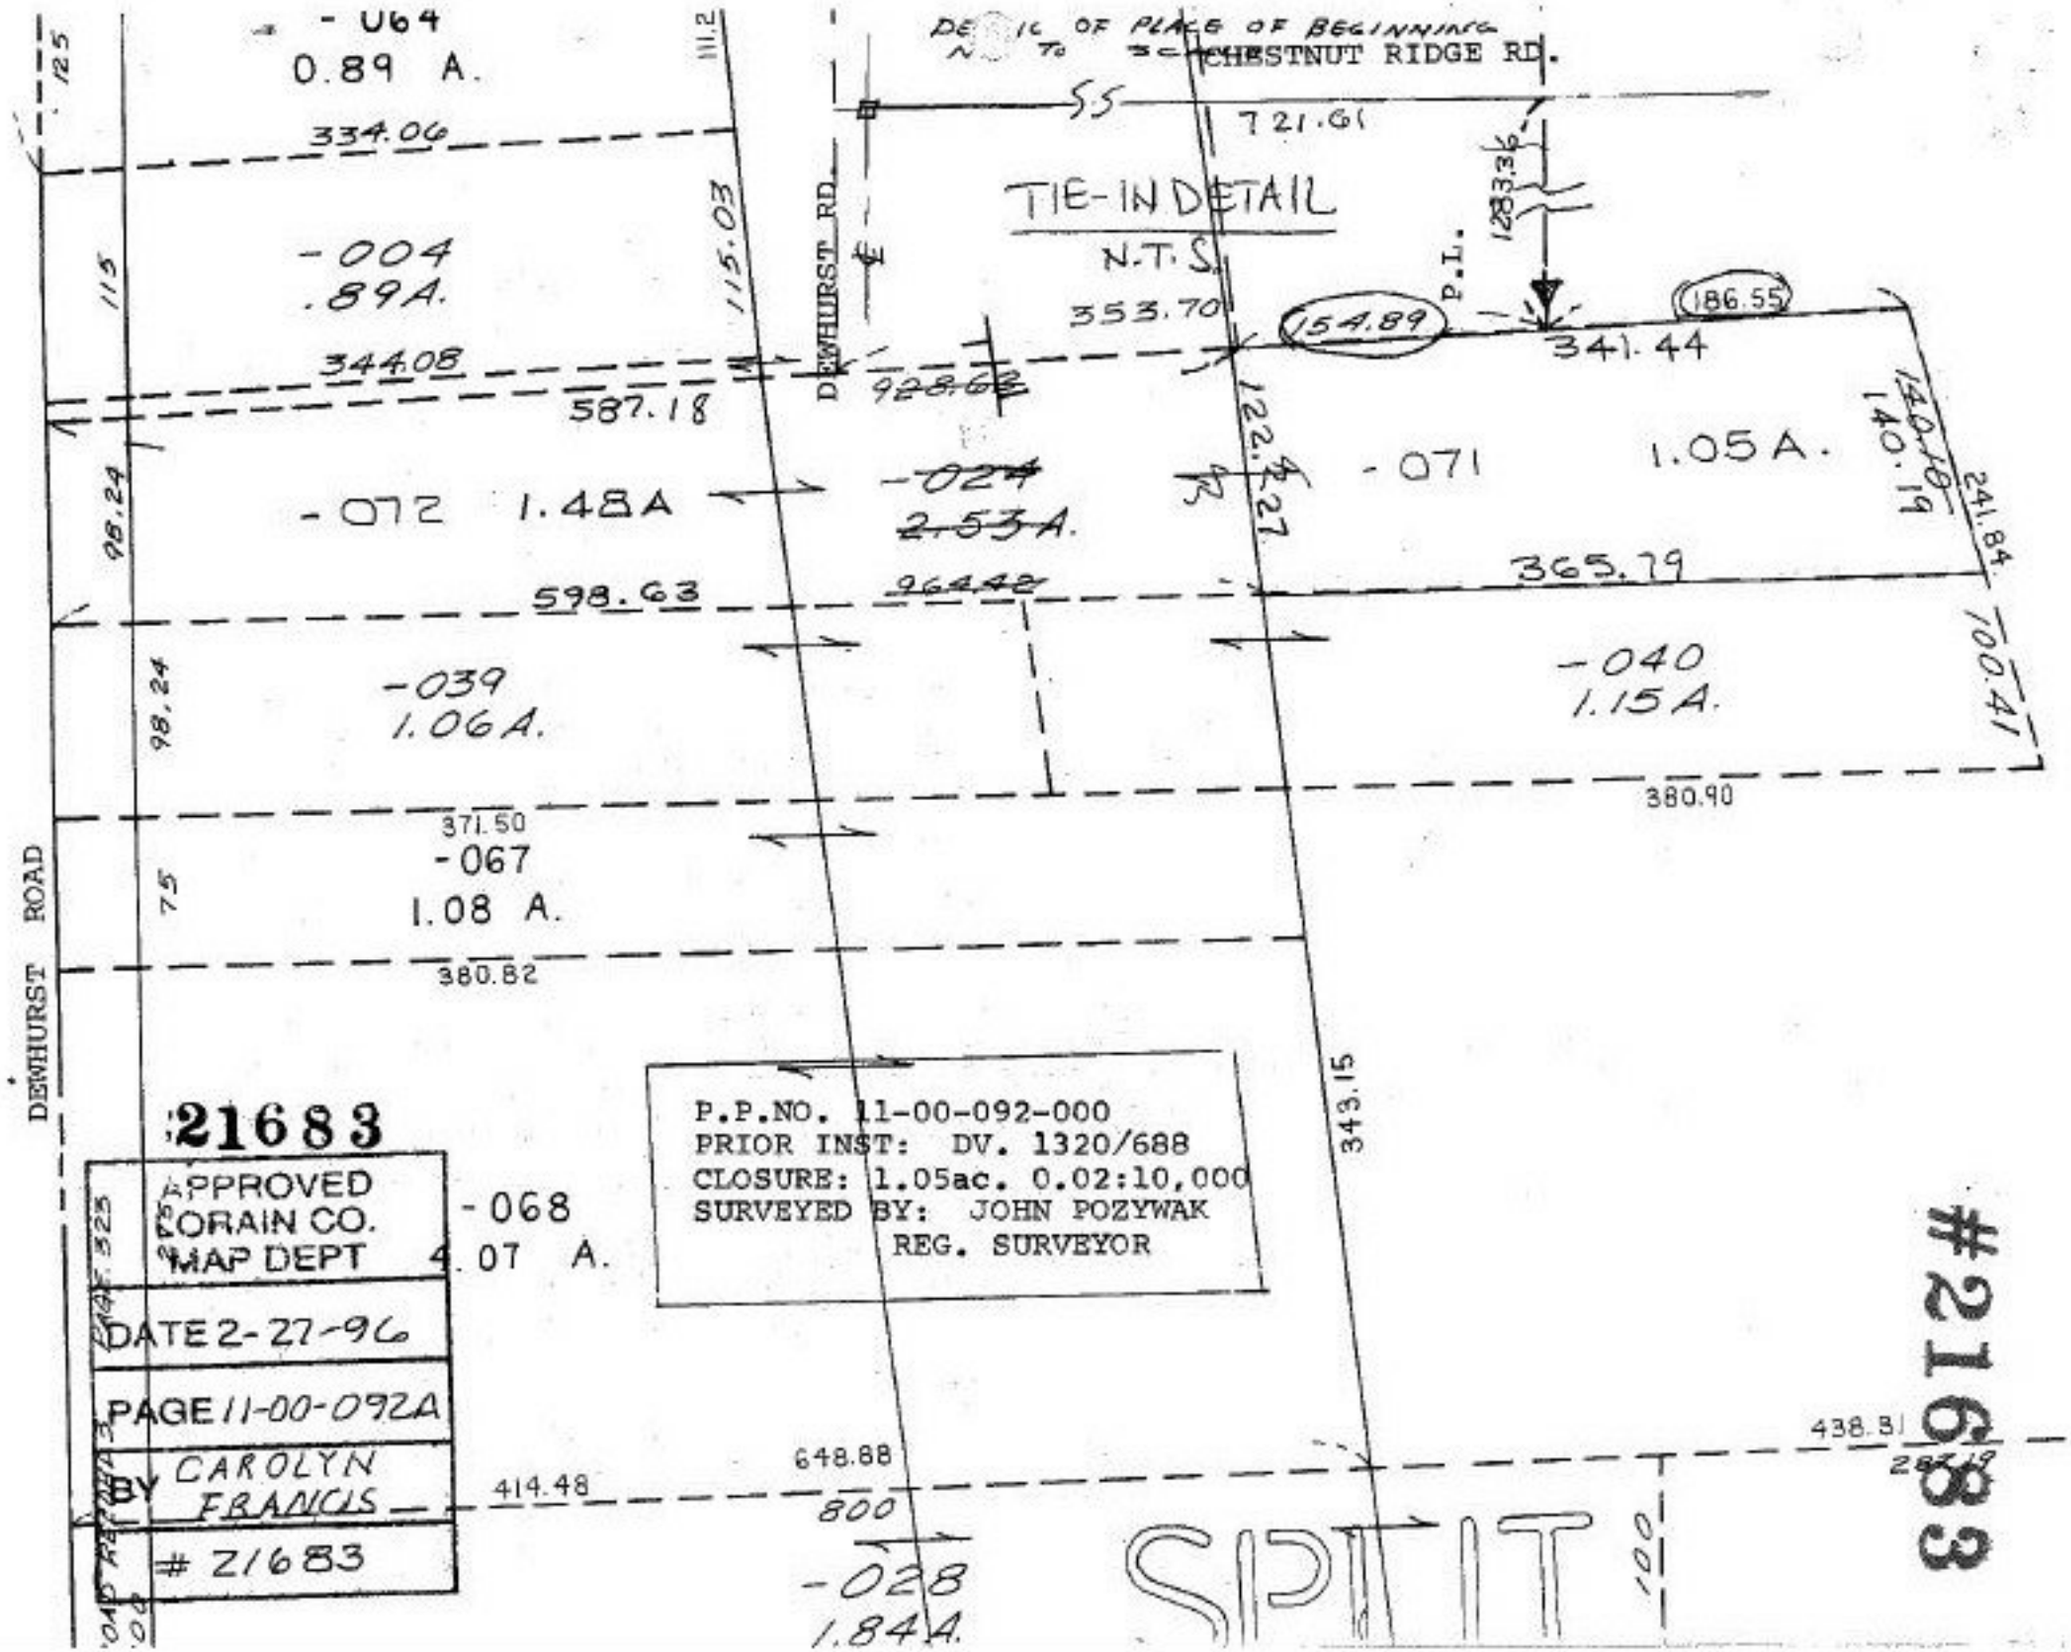

21683

APPROVED
LORAIN CO.
MAP DEPT

DATE 2-27-96

PAGE 11-00-092A

BY CAROLYN FRANCIS

21683

P.P.NO. 11-00-092-000
PRIOR INST: DV. 1320/688
CLOSURE: 1.05ac. 0.02:10,000
SURVEYED BY: JOHN POZYWAK
REG. SURVEYOR

#21683