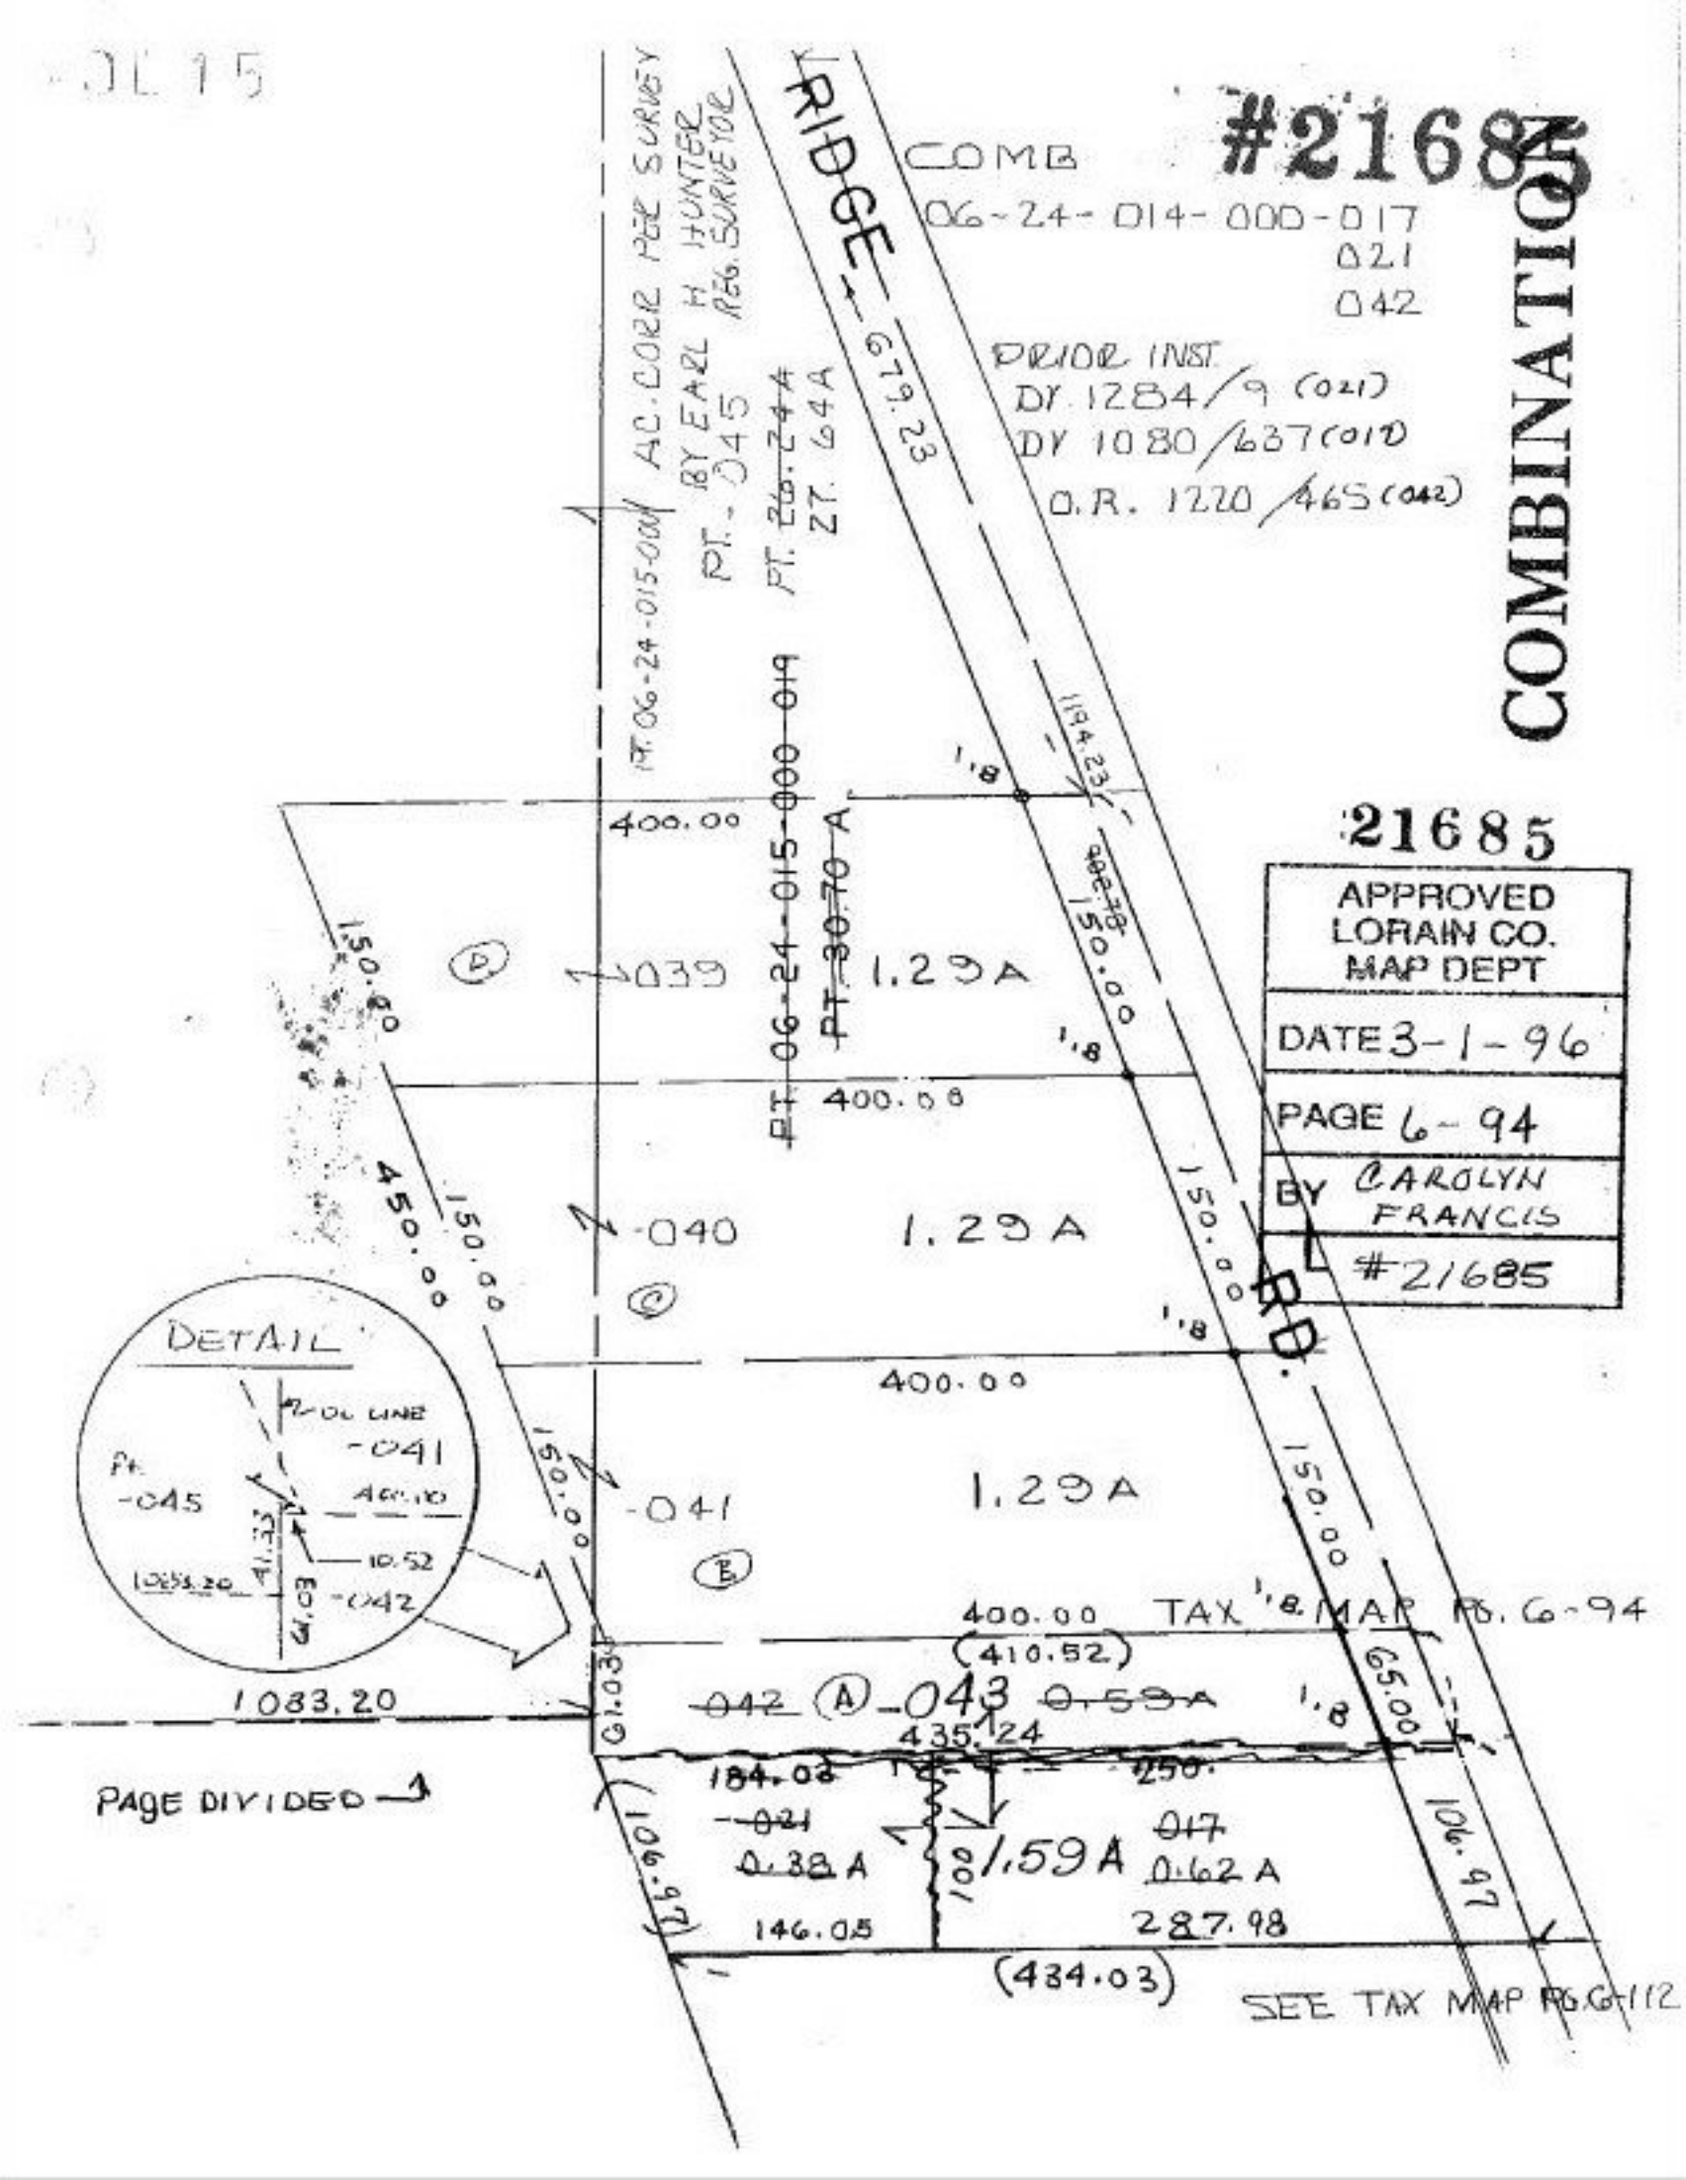

#21685
COMBINATION
COMB
06-24-014-000-017
021
042
PRIOR INST.
DY 1284/9 (021)
DY 1080/637 (017)
O.R. 1220/465 (042)
RIDGE
679.23
AC. CORR PER SURVEY
BY EARL H. HUNTER
REG. SURVEYOR
PT. 045
PT. 06-24-015-000
PT. 26.24A
ZT. 64A
PT. 06-24-015-000-019
PT. 30.70 A
1194.23
1.8
400.00
150.00
-039
1.29A
-040
1.29A
-041
1.29A
450.00
RD.
DETAIL
-041
-045
-042
10.52
1083.20
TAX MAP PG. 6-94
(410.52)
-042
-043
0.59A
435.24
1083.20
61.03
65.00
PAGE DIVIDED
184.03
250.
-021
0.38 A
1.59A
-017
0.62 A
106.97
146.05
287.98
(434.03)
SEE TAX MAP PG. 6-112
21685
APPROVED
LORAIN CO.
MAP DEPT
DATE 3-1-96
PAGE 6-94
BY CAROLYN FRANCIS
#21685