#21686

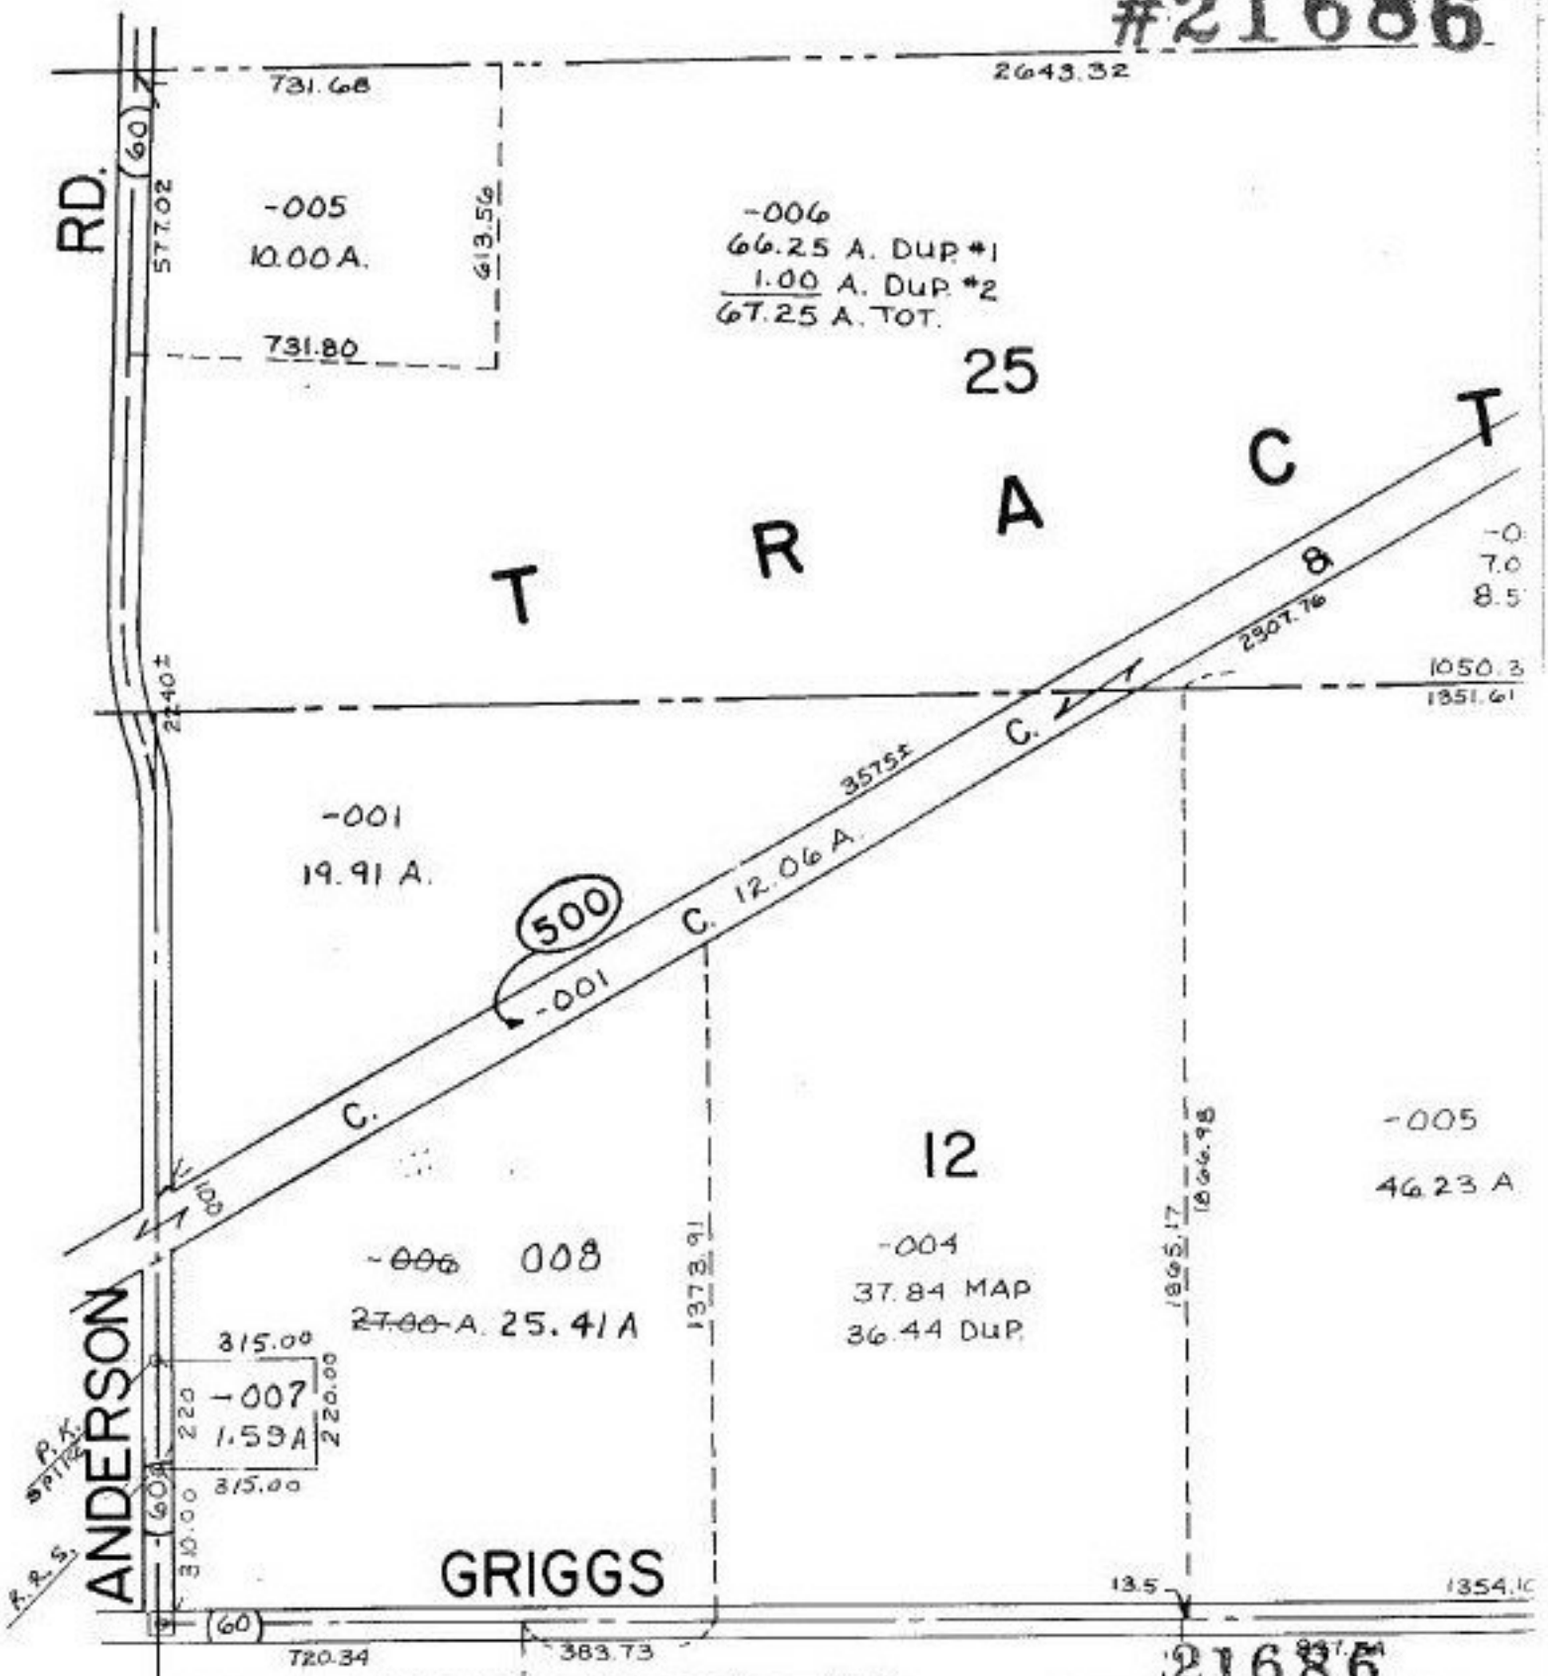

21686

P.P.NO. 20-05-012-000-
PRIOR INST: O.R.68/226
CLOSURE: 1:INF.
SURVEYED BY: LAUNDON, SIMON,
CAHL & ASSOC. ROGER SIMON R.S.

APPROVED
LORAIN CO.
MAP DEPT
DATE 3-1-96
PAGE 20-D
BY CAROLYN FRANCIS