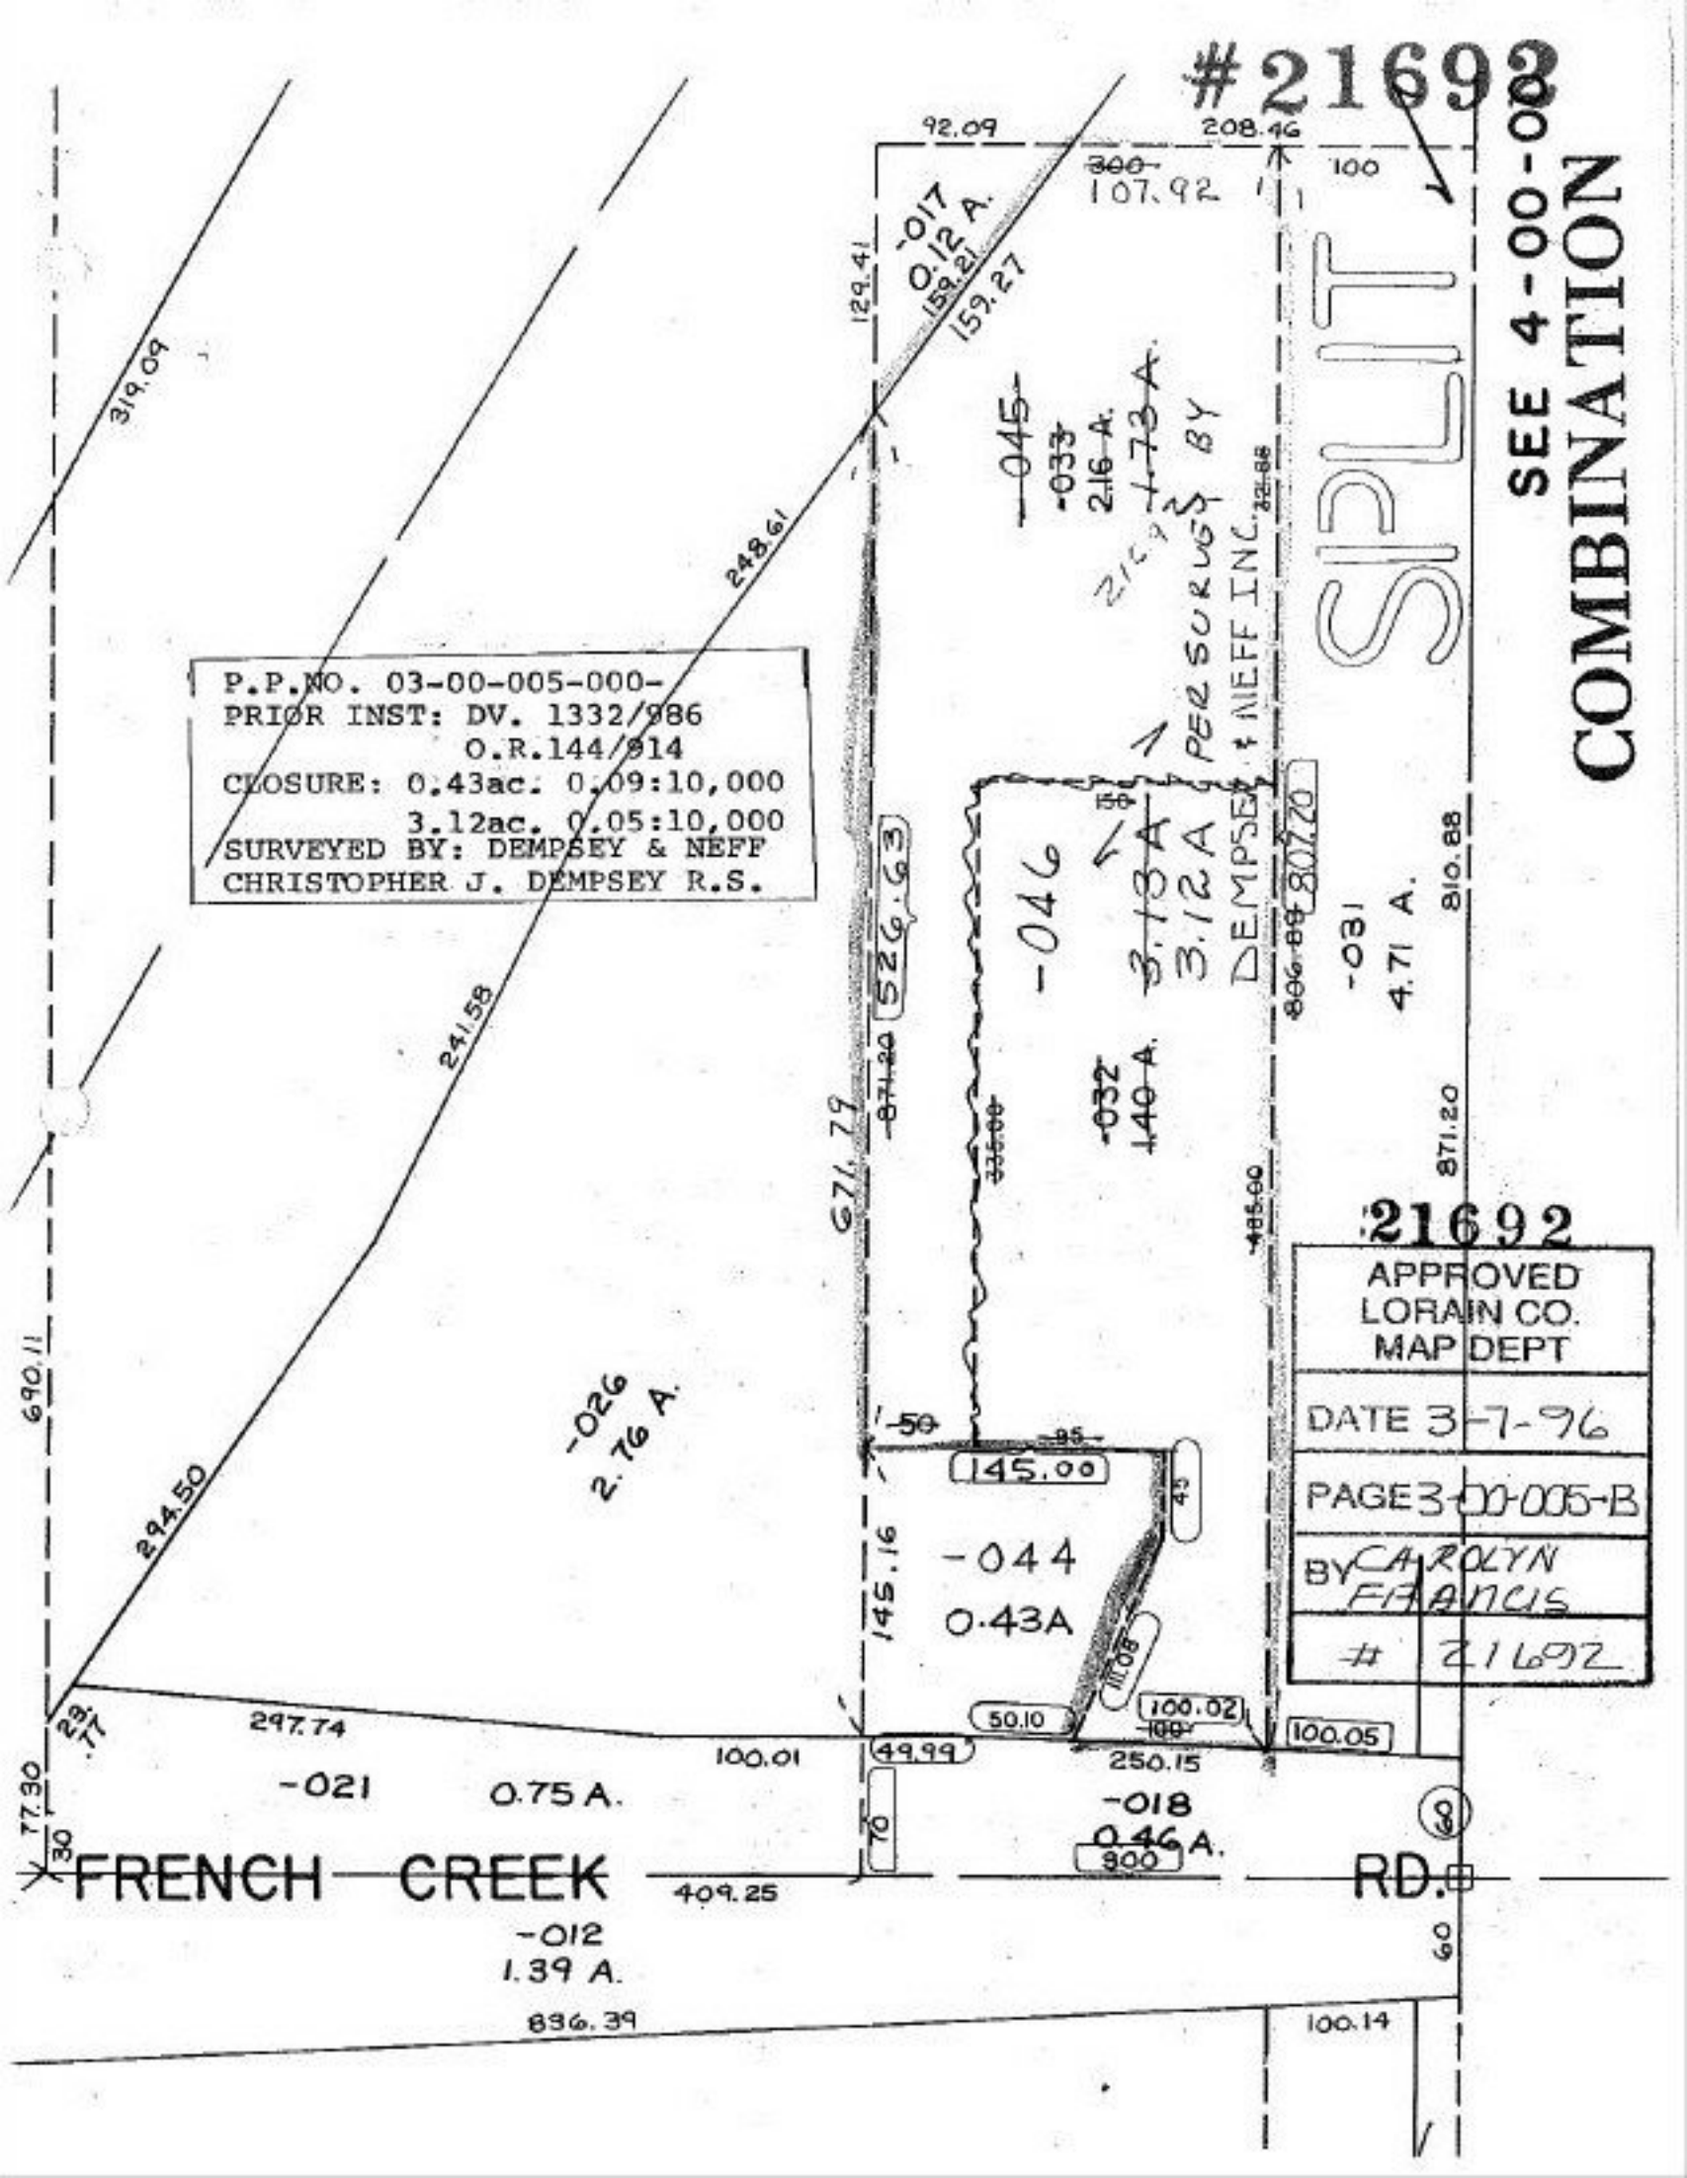
#21692
SEE 4-00-002
COMBINATION
SPLIT
P.P.NO. 03-00-005-000-
PRIOR INST: DV. 1332/986
O.R.144/914
CLOSURE: 0.43ac. 0.09:10,000
3.12ac. 0.05:10,000
SURVEYED BY: DEMPSEY & NEFF
CHRISTOPHER J. DEMPSEY R.S.
DEMPSEY & NEFF INC.
-017
0.12 A.
-045
-033
216 A.
-046
3.13A
3.12A
-032
1.40 A.
-031
4.71 A.
-026
2.76 A.
-044
0.43A
-021
0.75 A.
-018
0.46 A.
-012
1.39 A.
FRENCH CREEK RD.
APPROVED
LORAIN CO.
MAP DEPT
DATE 3-7-96
PAGE 3-00-005-B
BY CAROLYN FRANCIS
21692