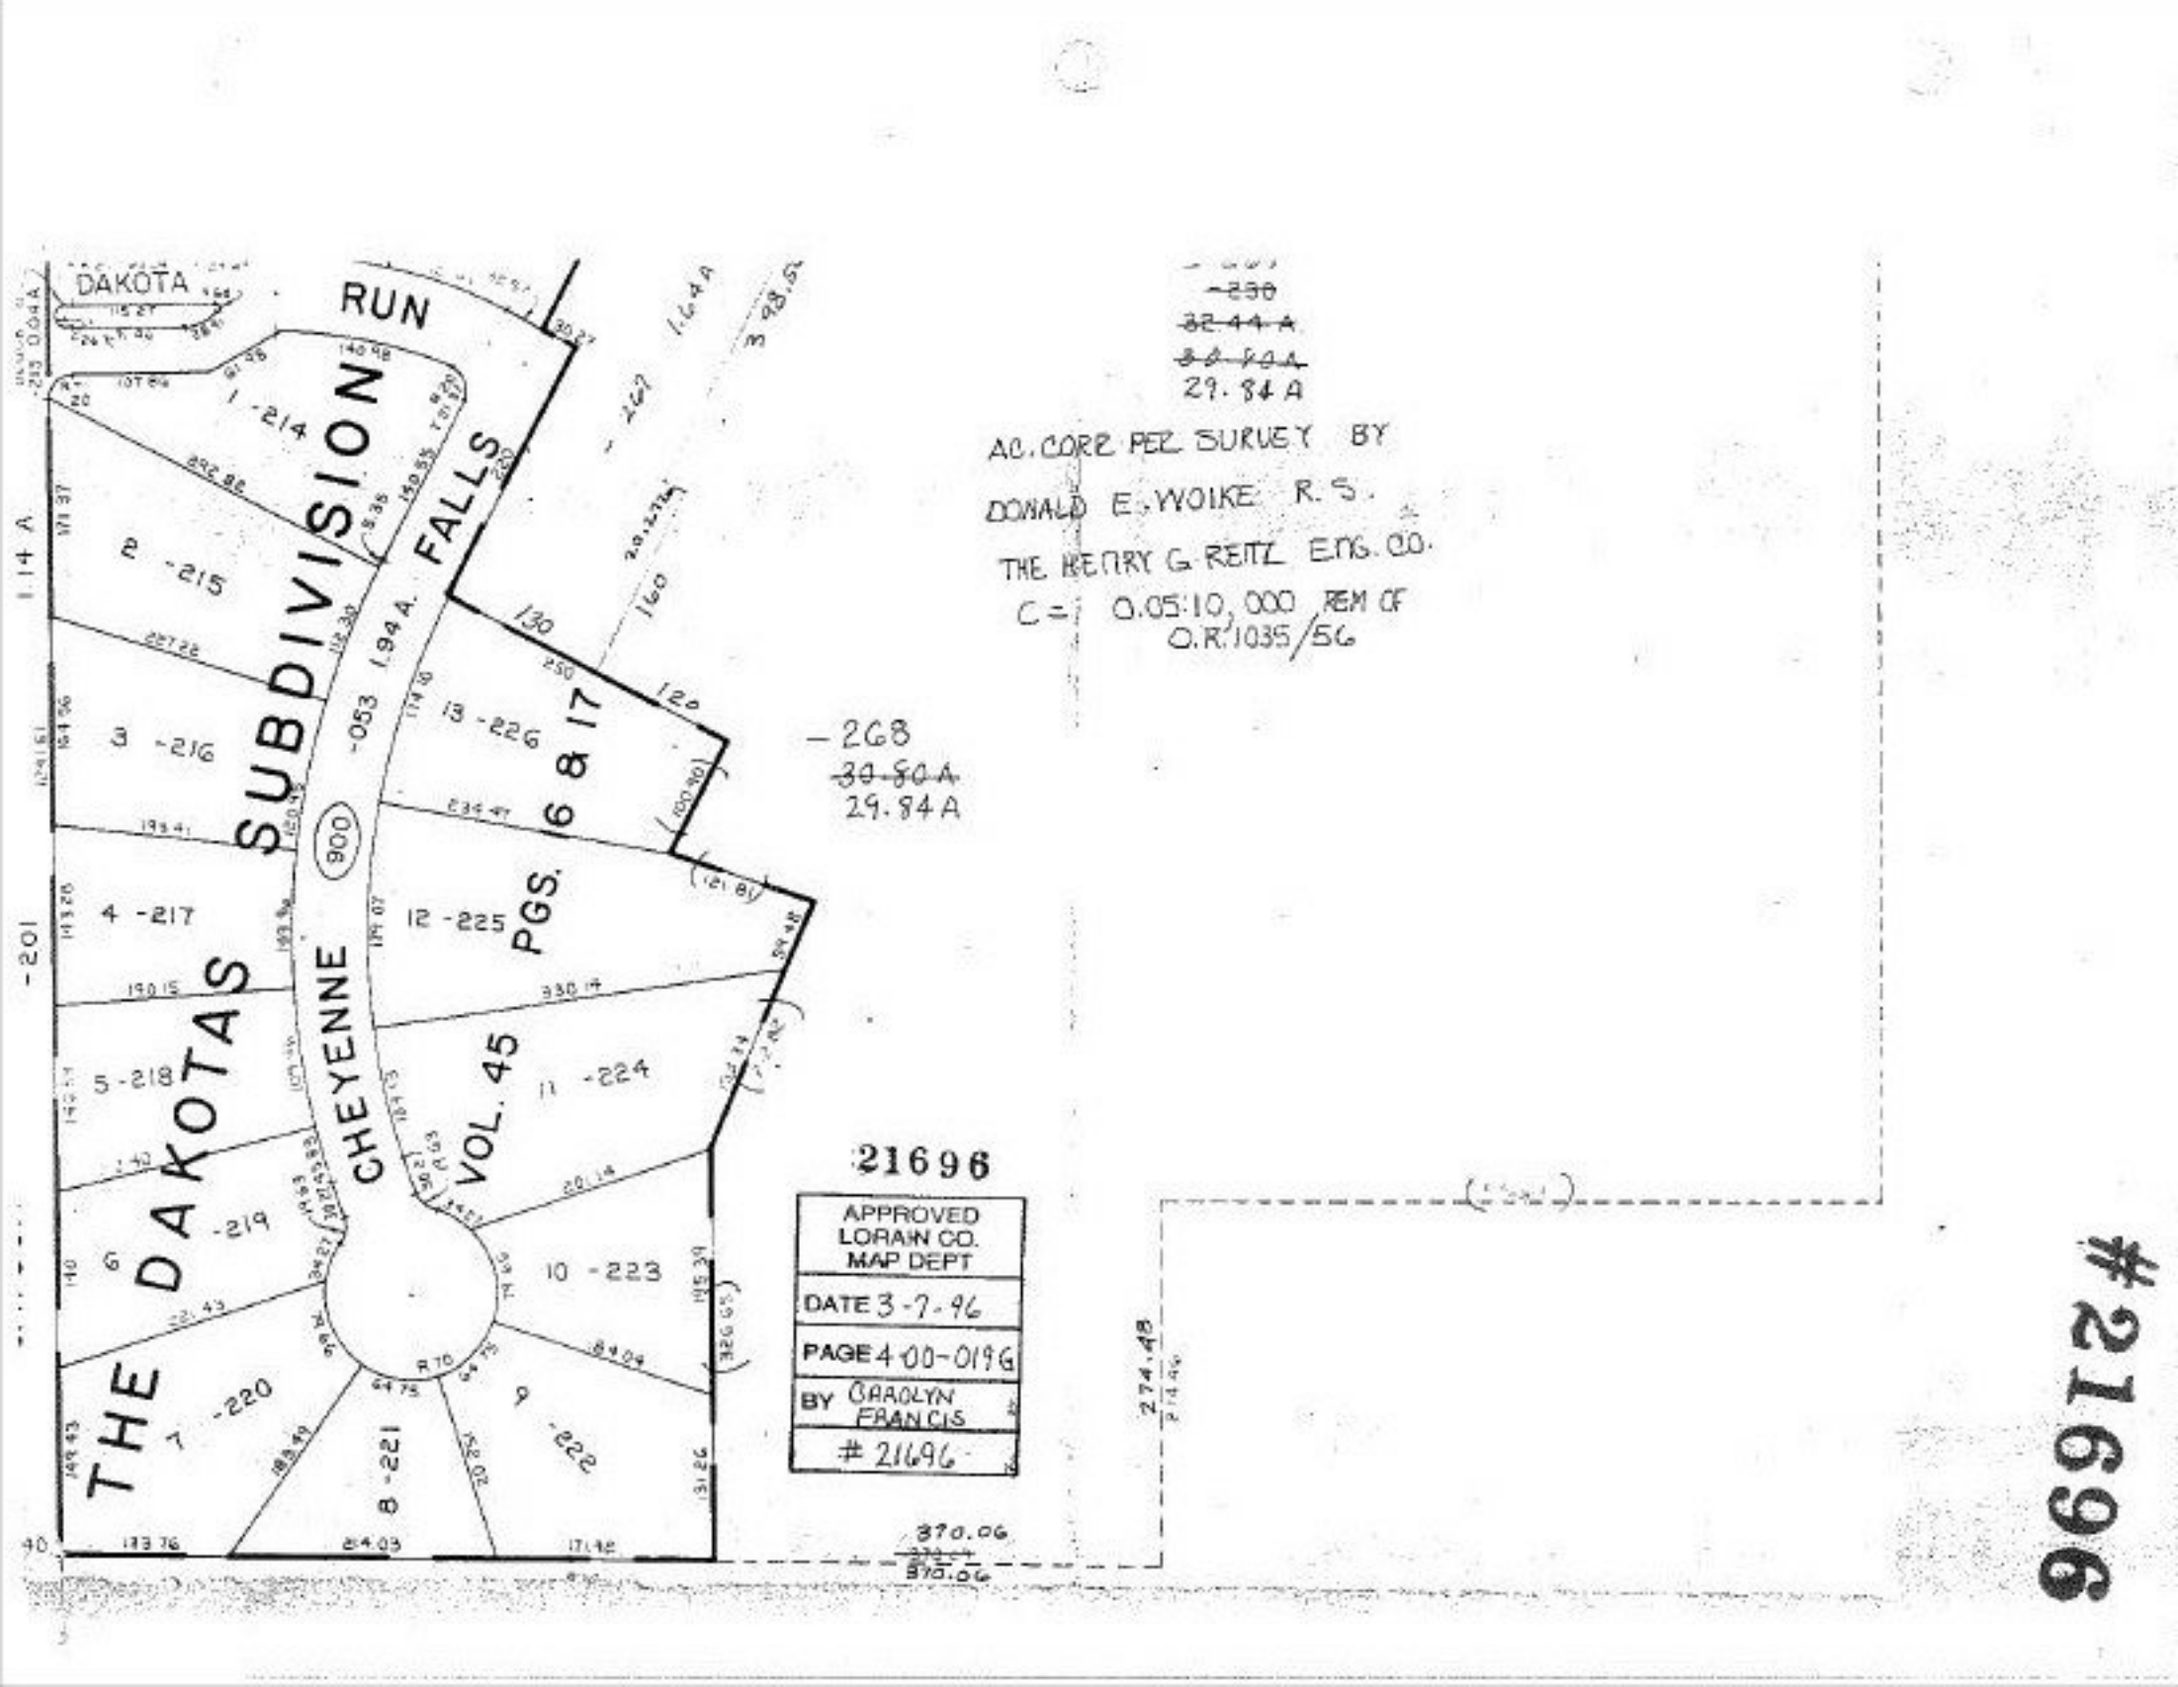
DAKOTA RUN
THE DAKOTAS SUBDIVISION
CHEYENNE FALLS
VOL. 45 PGS. 16 & 17
1 -214
2 -215
3 -216
4 -217
5 -218
6 -219
7 -220
8 -221
9 -222
10 -223
11 -224
12 -225
13 -226
900
-053 1.94 A.
-201
1.14 A
-268
30.80 A
29.84 A
-250
32.44 A
30.90 A
29.84 A
AC. CORR PER SURVEY BY
DONALD E. WOLKE R.S.
THE HENRY G. REITZ ENG. CO.
C= 0.05:10,000 REM OF
O.R. 1035/56
21696
APPROVED
LORAIN CO.
MAP DEPT
DATE 3-7-96
PAGE 400-019G
BY CAROLYN FRANCIS
21696
370.06
370.06
274.48
21696 #