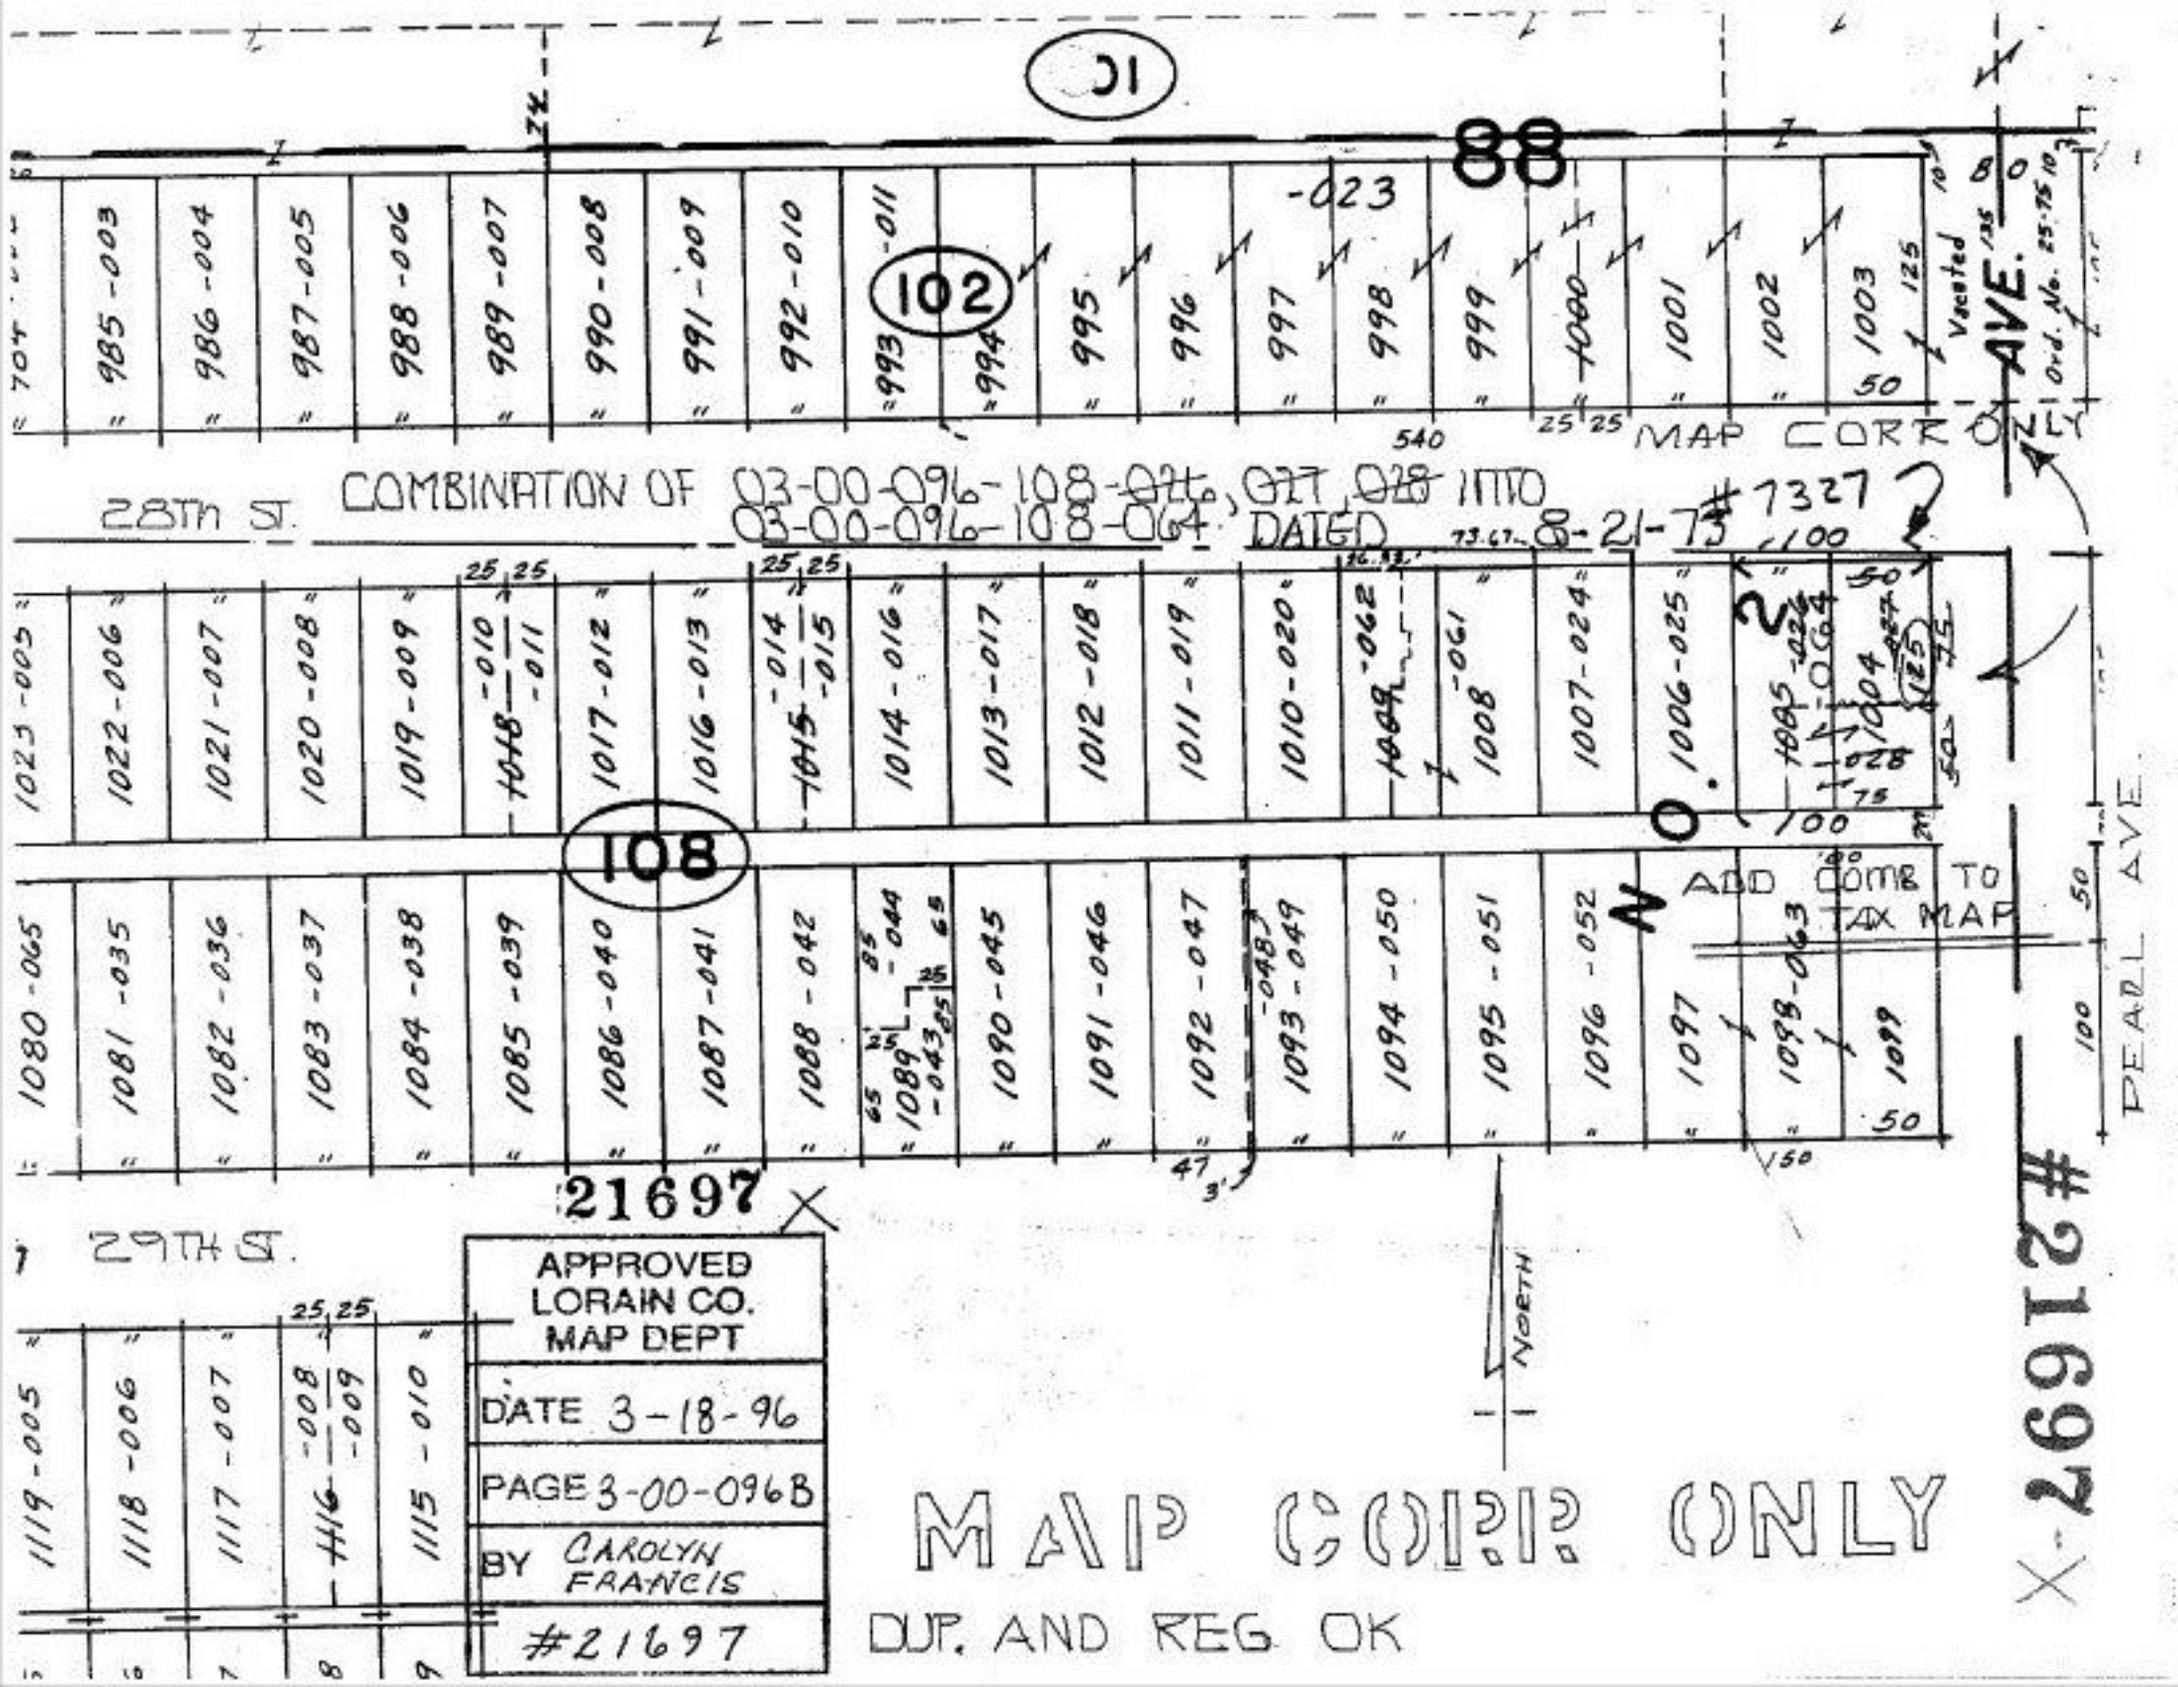

01
88
102
108
28TH ST.
29TH ST.
COMBINATION OF 03-00-096-108-026, 027, 028 INTO 03-00-096-108-064 DATED 8-21-73
#7327
MAP CORR ONLY
ADD COMB TO TAX MAP
Vacated AVE.
Ord. No. 25-75
PEARL AVE.
NORTH
21697
APPROVED LORAIN CO. MAP DEPT
DATE 3-18-96
PAGE 3-00-096B
BY CAROLYN FRANCIS
#21697
MAP CORR ONLY
DUP. AND REG. OK
#21697