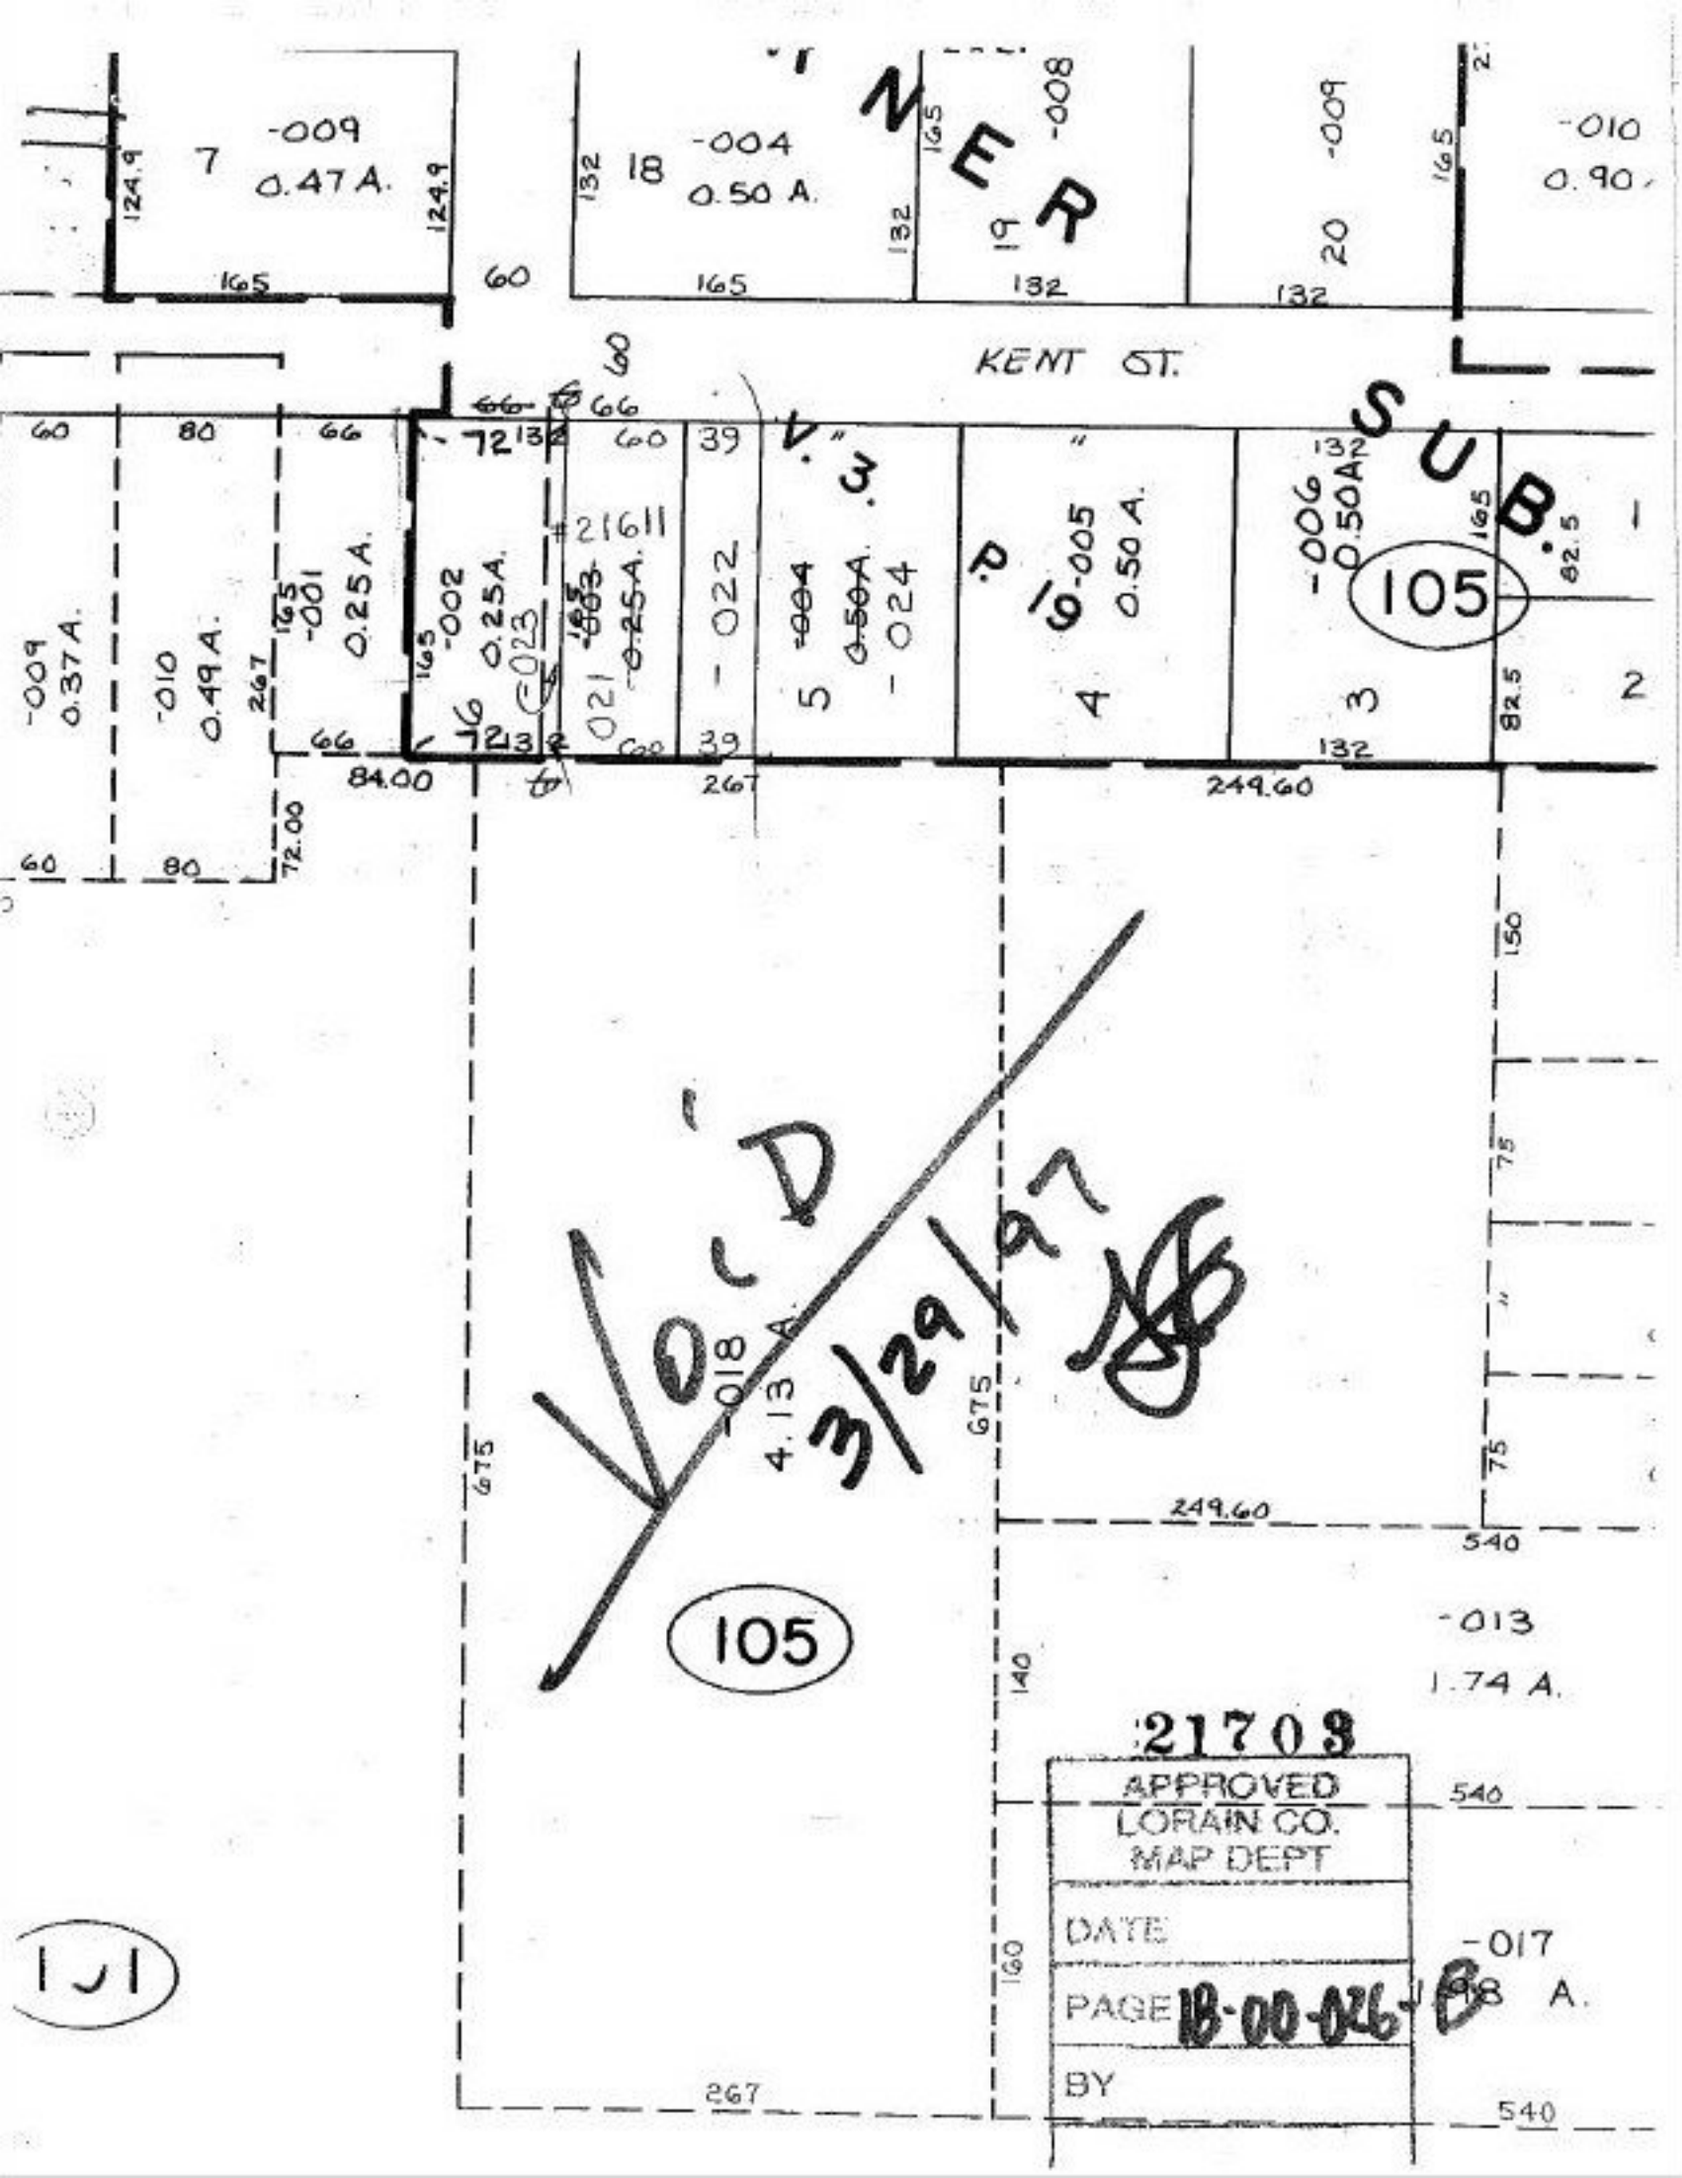
-009
0.47 A.
7
124.9
124.9
165
60
-004
0.50 A.
18
132
165
132
-008
19
165
132
-009
20
165
132
-010
0.90
KENT ST.
60
66
66
66
72
13
60
39
-009
0.37 A.
-010
0.49 A.
267
-001
0.25 A.
165
-002
0.25 A.
165
#21611
-003
-022
-024
5
-004
0.50 A.
4
-005
0.50 A.
-006
0.50 A.
3
105
82.5
2
84.00
72.00
267
249.60
132
82.5
VOID
3/29/97
-018
4.13 A.
675
675
150
75
75
249.60
540
105
-013
1.74 A.
140
21703
APPROVED
LORAIN CO.
MAP DEPT
DATE
PAGE 18-00-026-B
BY
540
160
-017
1.98 A.
267
540
131