#21706

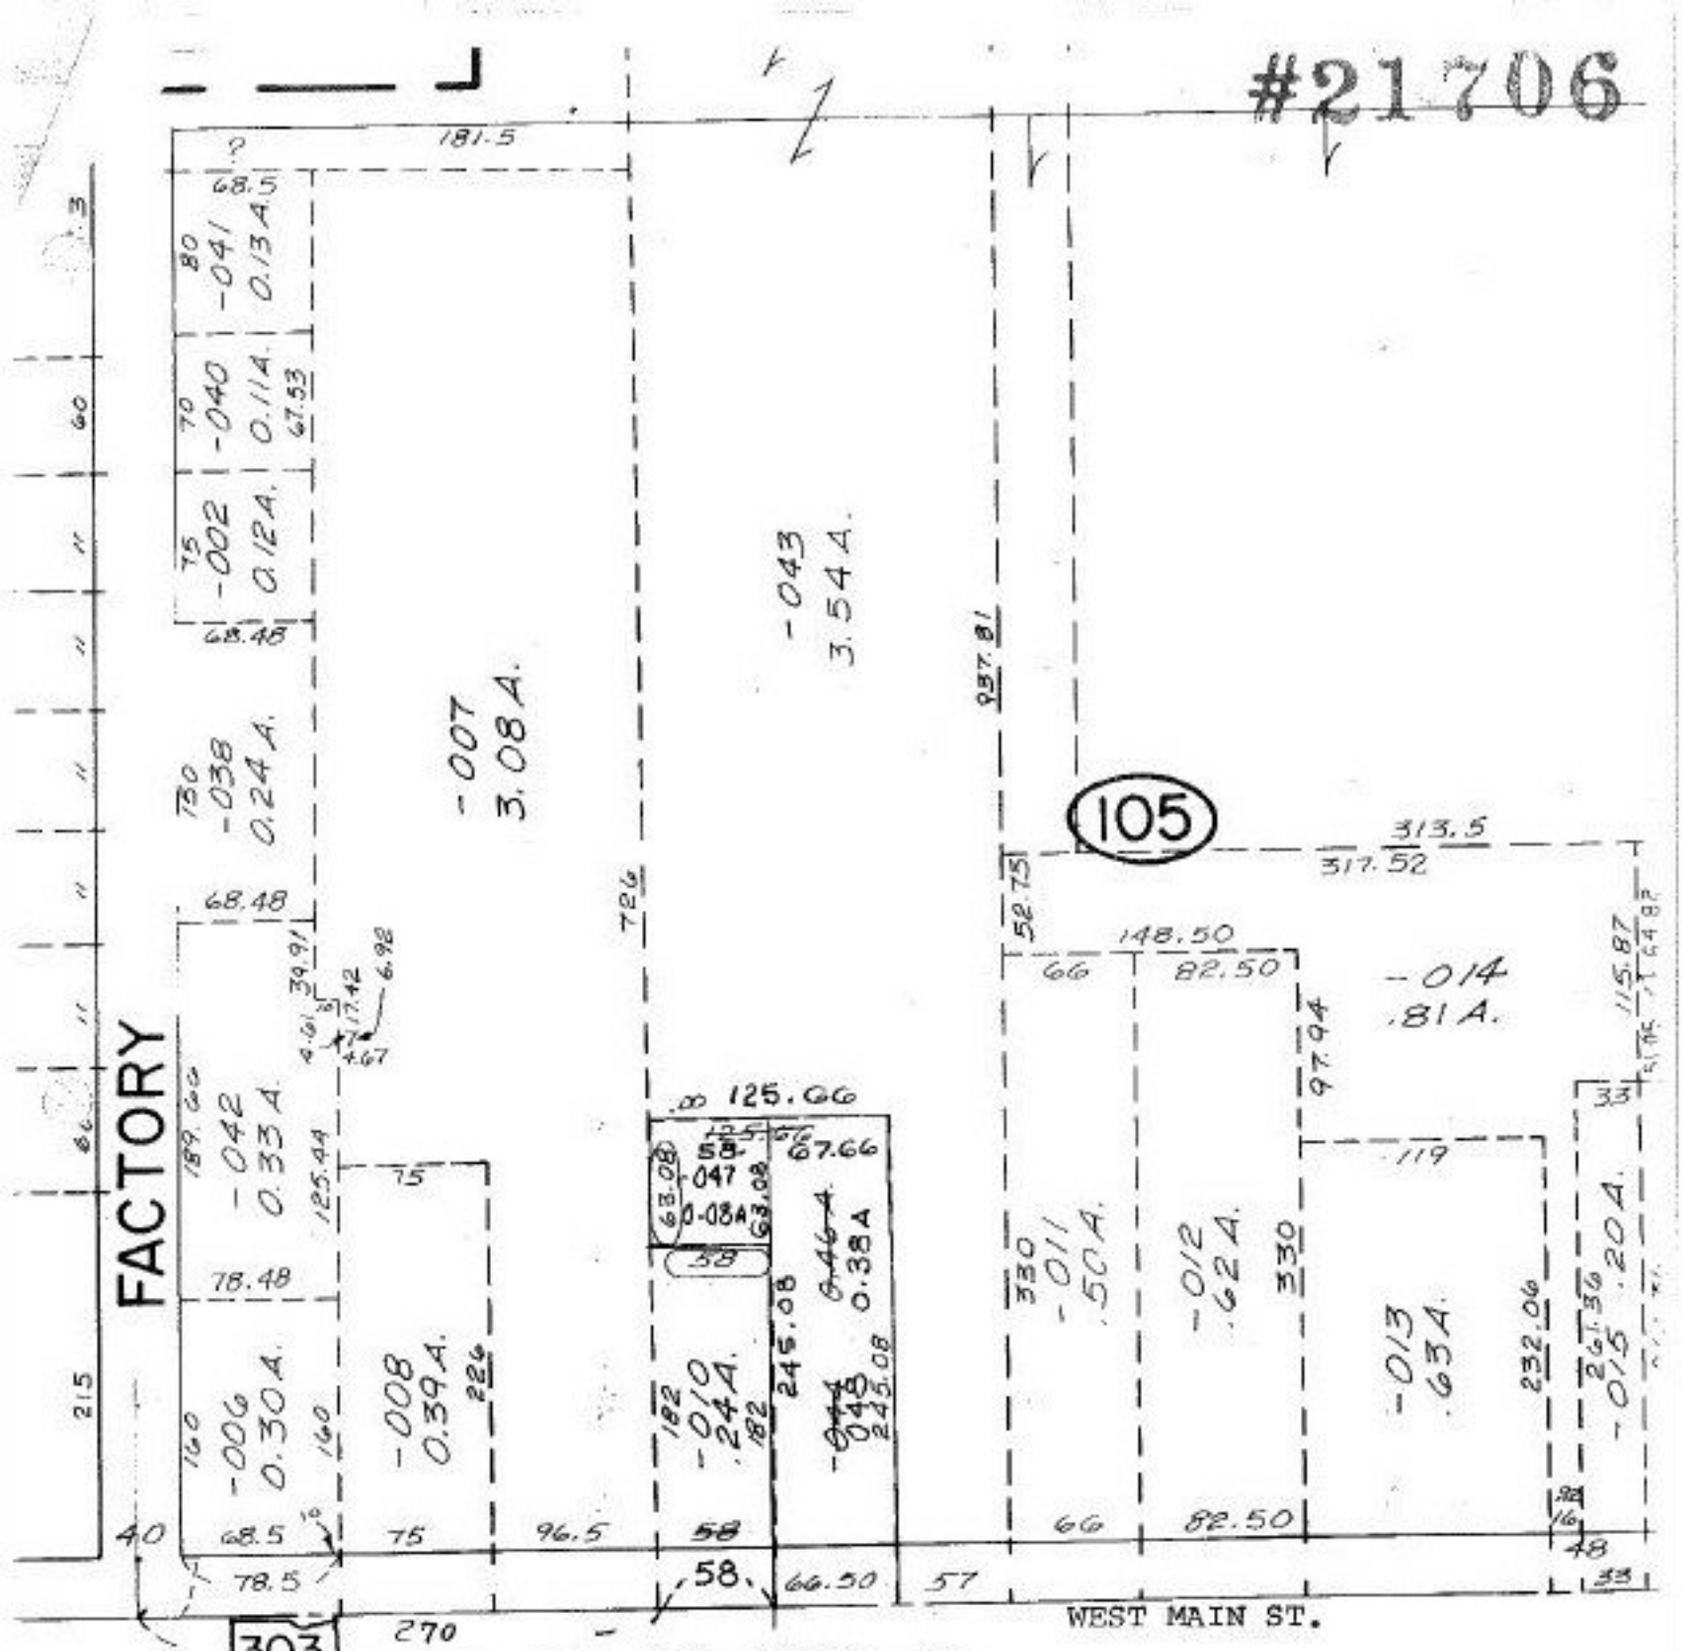

SEE 15-00-056-B

P.P.NO.
p.p.no. 15-00-045-105-

PRIOR INST: O.R. 247/762
CLOSURE: 1:INF.
SURVEYED BY: JOHN POZYWAK
REG. SURVEYOR

200

21706

APPROVED LORAIN CO. MAP DEPT
DATE 3-20-96
PAGE 15-00-045-B
BY CAROLYN FRANCIS
21706