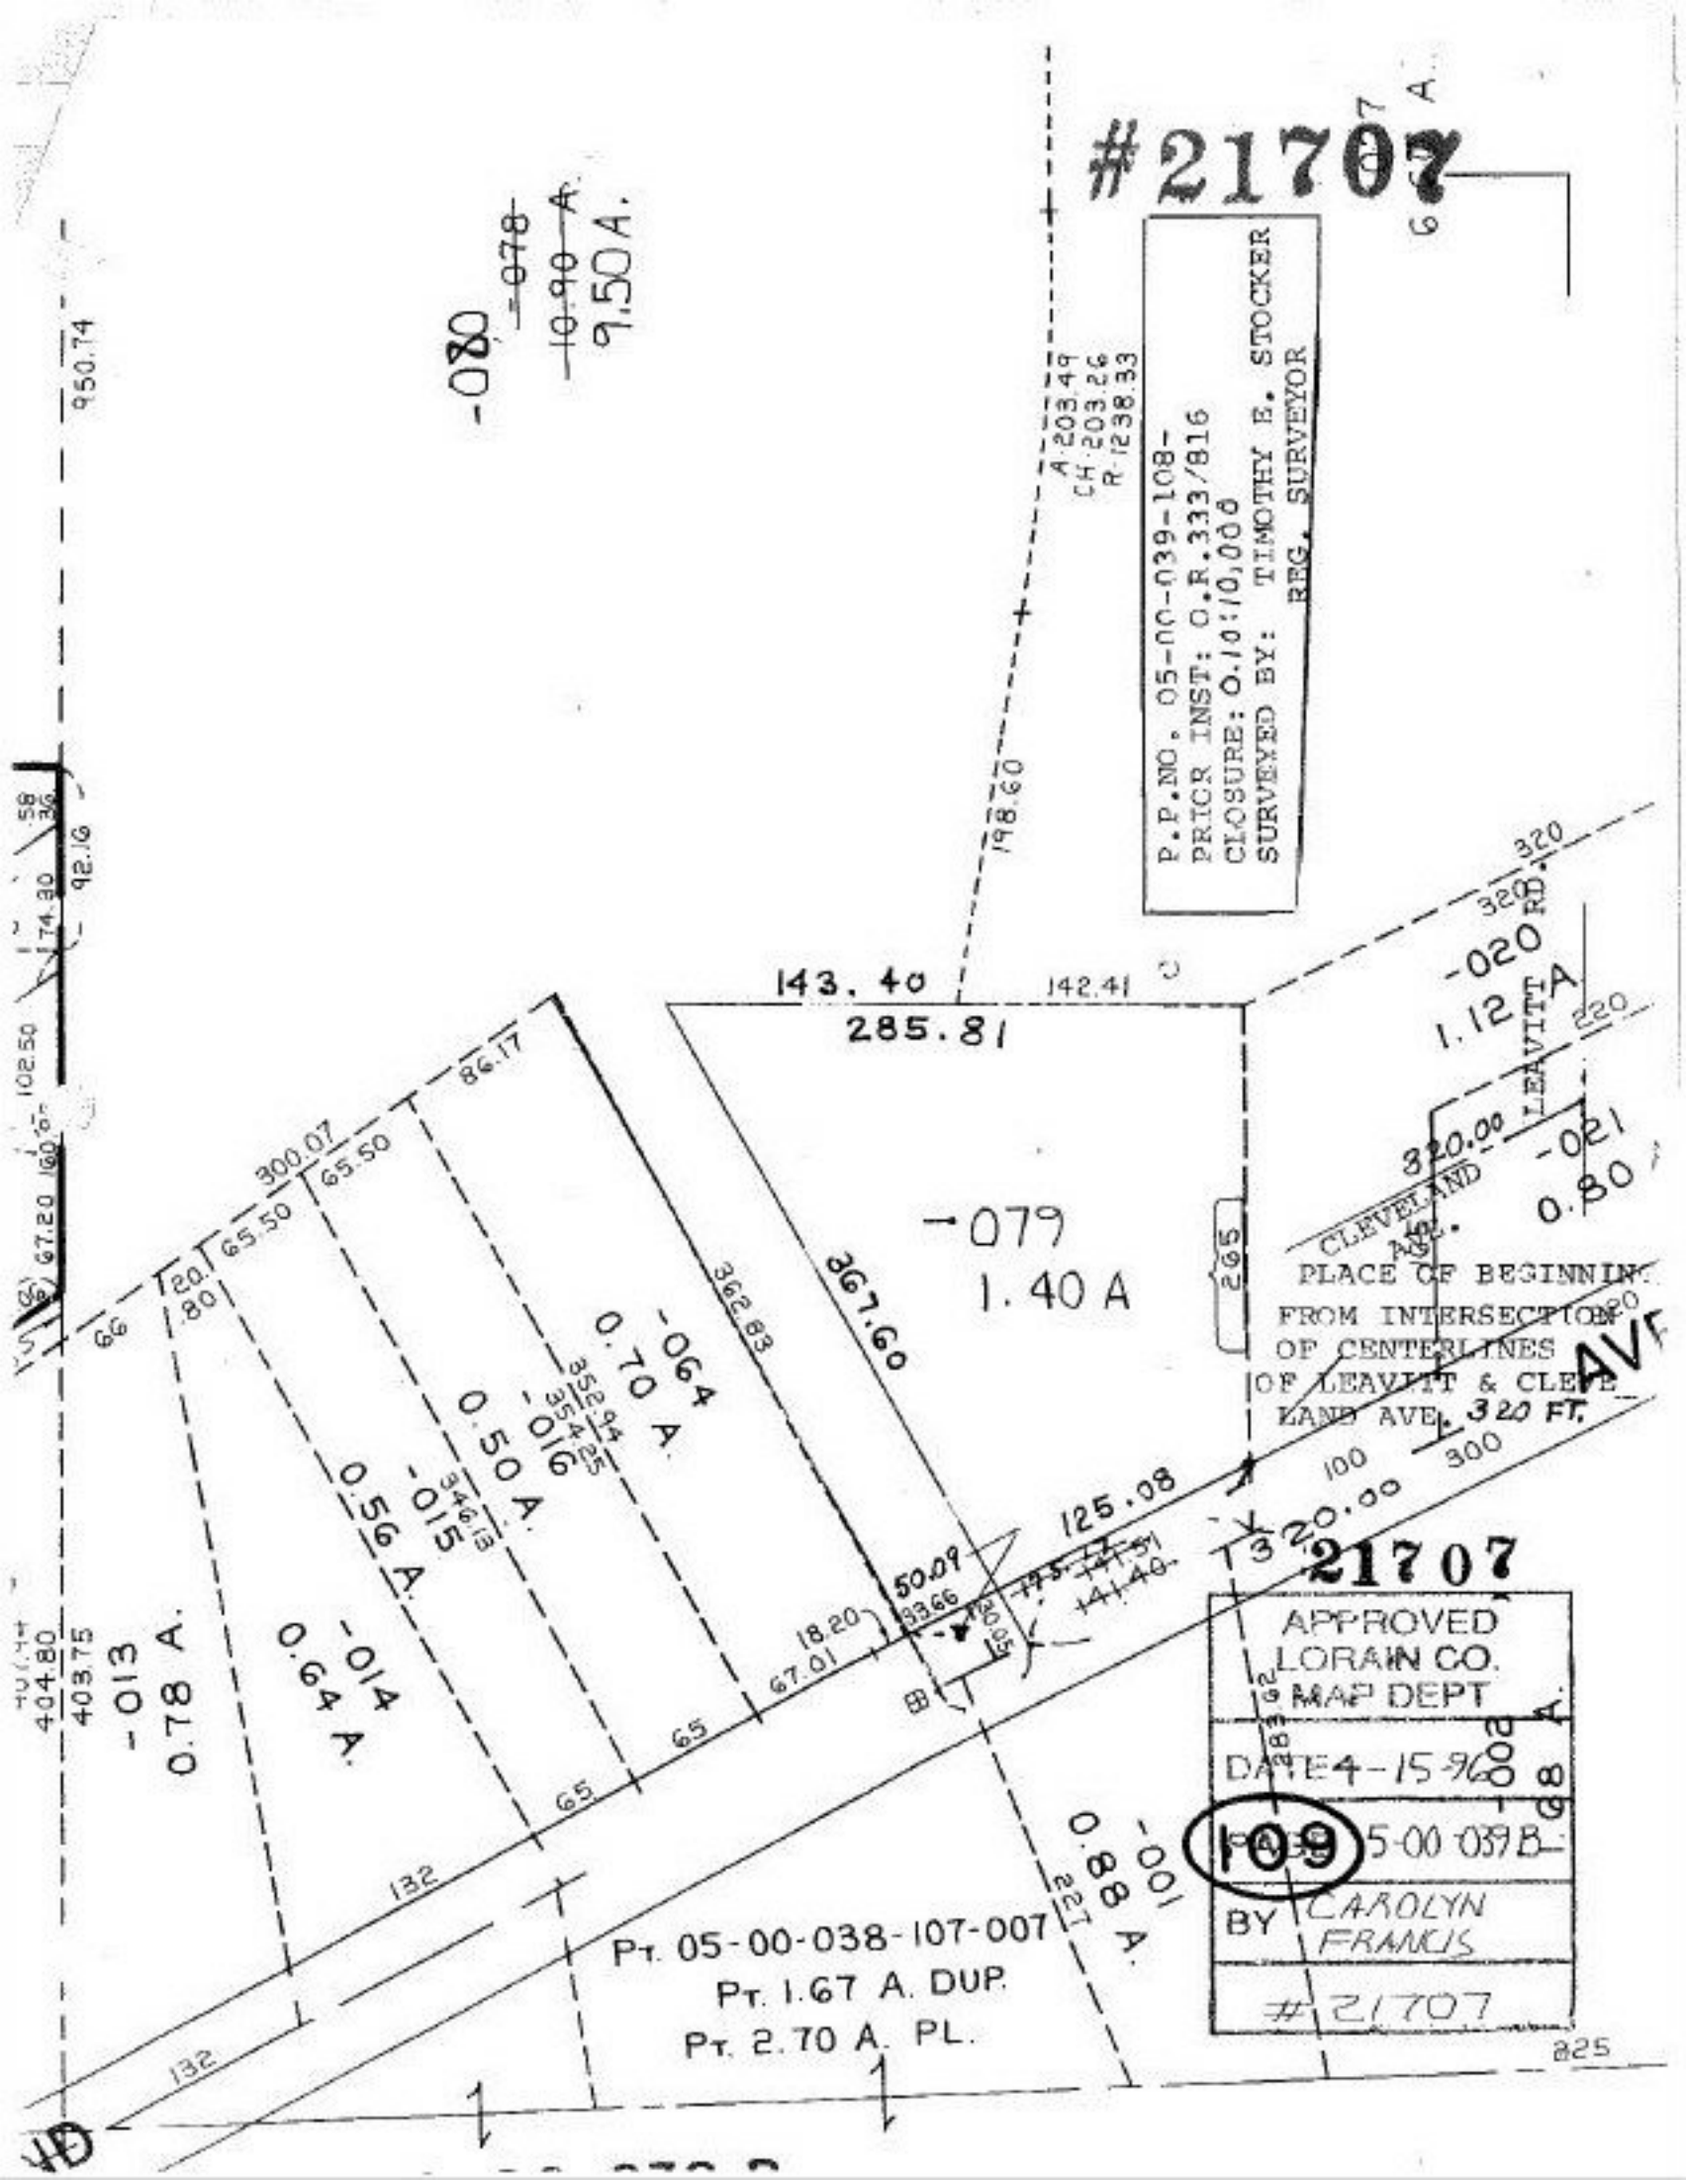
#21707
P.P.NO. 05-00-039-108-
PRIOR INST: O.R.333/816
CLOSURE: 0.10:10,000
SURVEYED BY: TIMOTHY E. STOCKER
REG. SURVEYOR
-080
9.50 A.
-079
1.40 A
-064
0.70 A.
-016
0.50 A.
-015
0.56 A.
-014
0.64 A.
-013
0.78 A.
-020
1.12 A
-021
0.80
-001
0.88 A.
LEAVITT RD.
CLEVELAND AVE.
PLACE OF BEGINNING
FROM INTERSECTION
OF CENTERLINES
OF LEAVITT & CLEVE
LAND AVE. 320 FT.
143.40
285.81
142.41
198.60
367.60
125.08
320.00
PT. 05-00-038-107-007
PT. 1.67 A. DUP.
PT. 2.70 A. PL.
21707
APPROVED
LORAIN CO.
MAP DEPT
DATE 4-15-96
PAGE 5-00-039B
109
BY CAROLYN FRANCIS
#21707