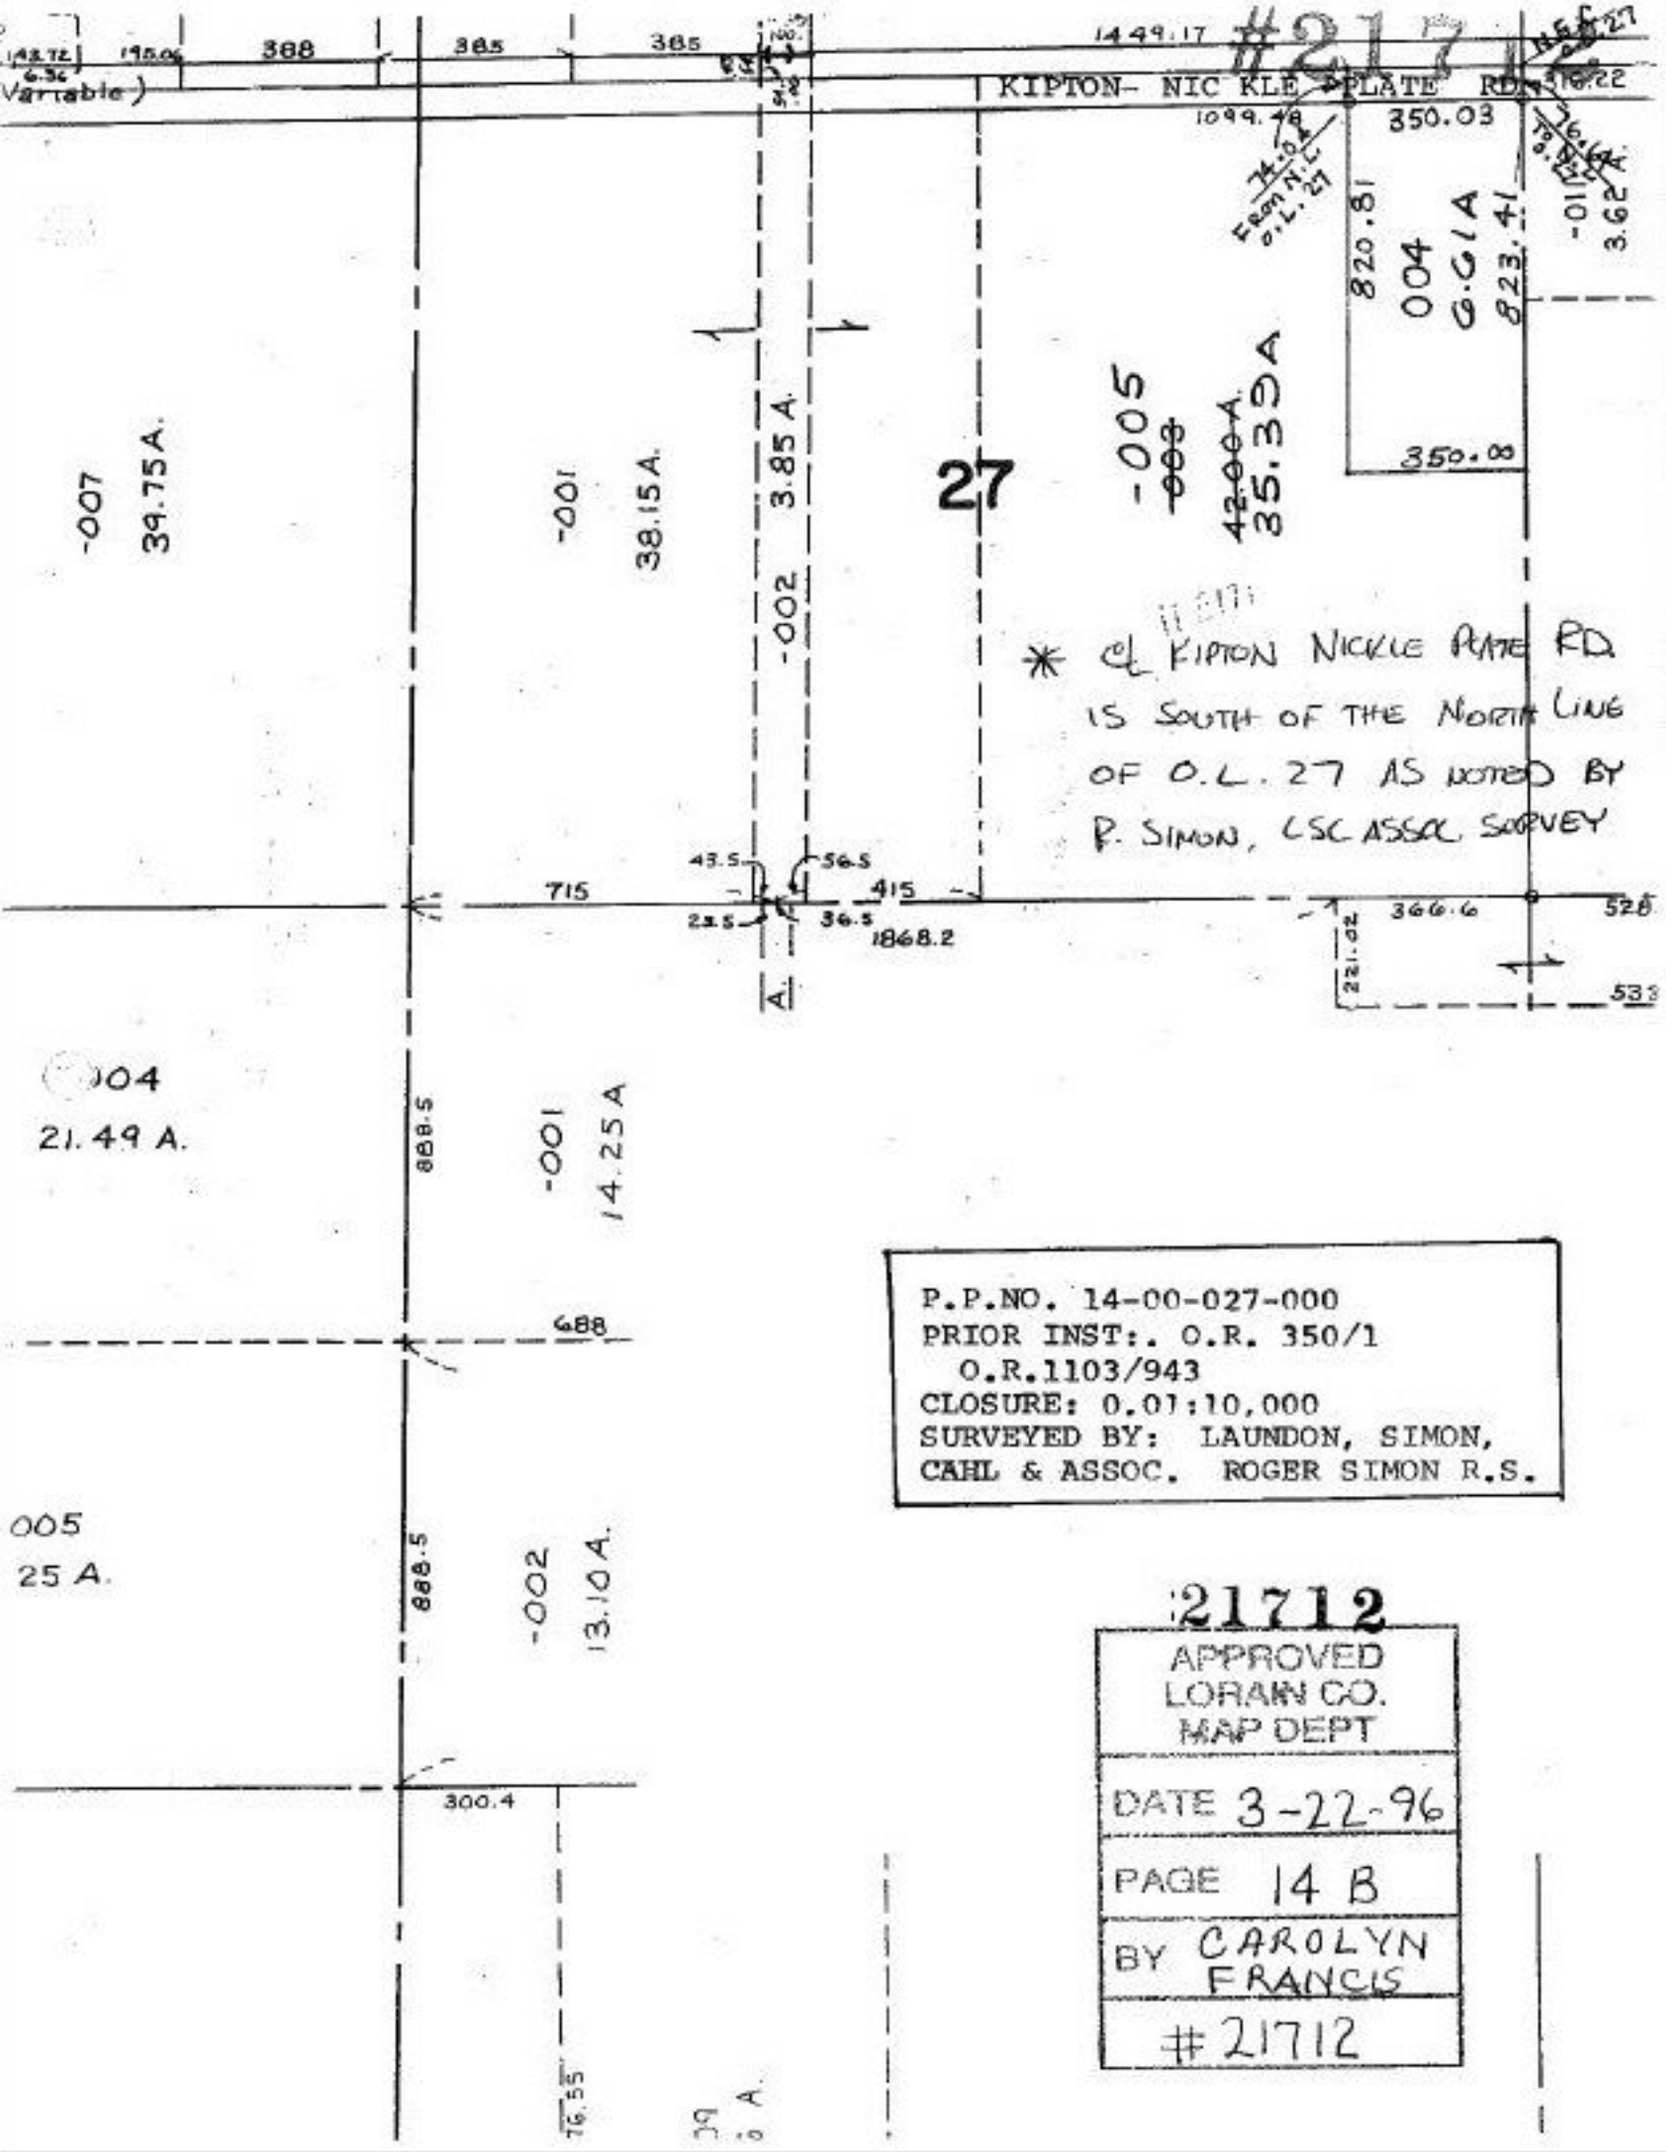
#21712
KIPTON- NIC KLE PLATE RD
1449.17
1099.48
350.03
820.81
004
G.G.I.A
823.41
3.62 A.
-005
-003
42.00 A.
35.39 A.
27
-007
39.75 A.
-001
38.15 A.
-002
3.85 A.
* ℄ KIPTON NICKLE PLATE RD. IS SOUTH OF THE NORTH LINE OF O.L. 27 AS NOTED BY P. SIMON, LSC ASSOC. SURVEY
715
415
1868.2
366.6
528
533
004
21.49 A.
888.5
-001
14.25 A.
688
005
25 A.
888.5
-002
13.10 A.
300.4
P.P.NO. 14-00-027-000
PRIOR INST:. O.R. 350/1
O.R.1103/943
CLOSURE: 0.01:10,000
SURVEYED BY: LAUNDON, SIMON, CAHL & ASSOC. ROGER SIMON R.S.
21712
APPROVED
LORAIN CO.
MAP DEPT
DATE 3-22-96
PAGE 14 B
BY CAROLYN FRANCIS
#21712