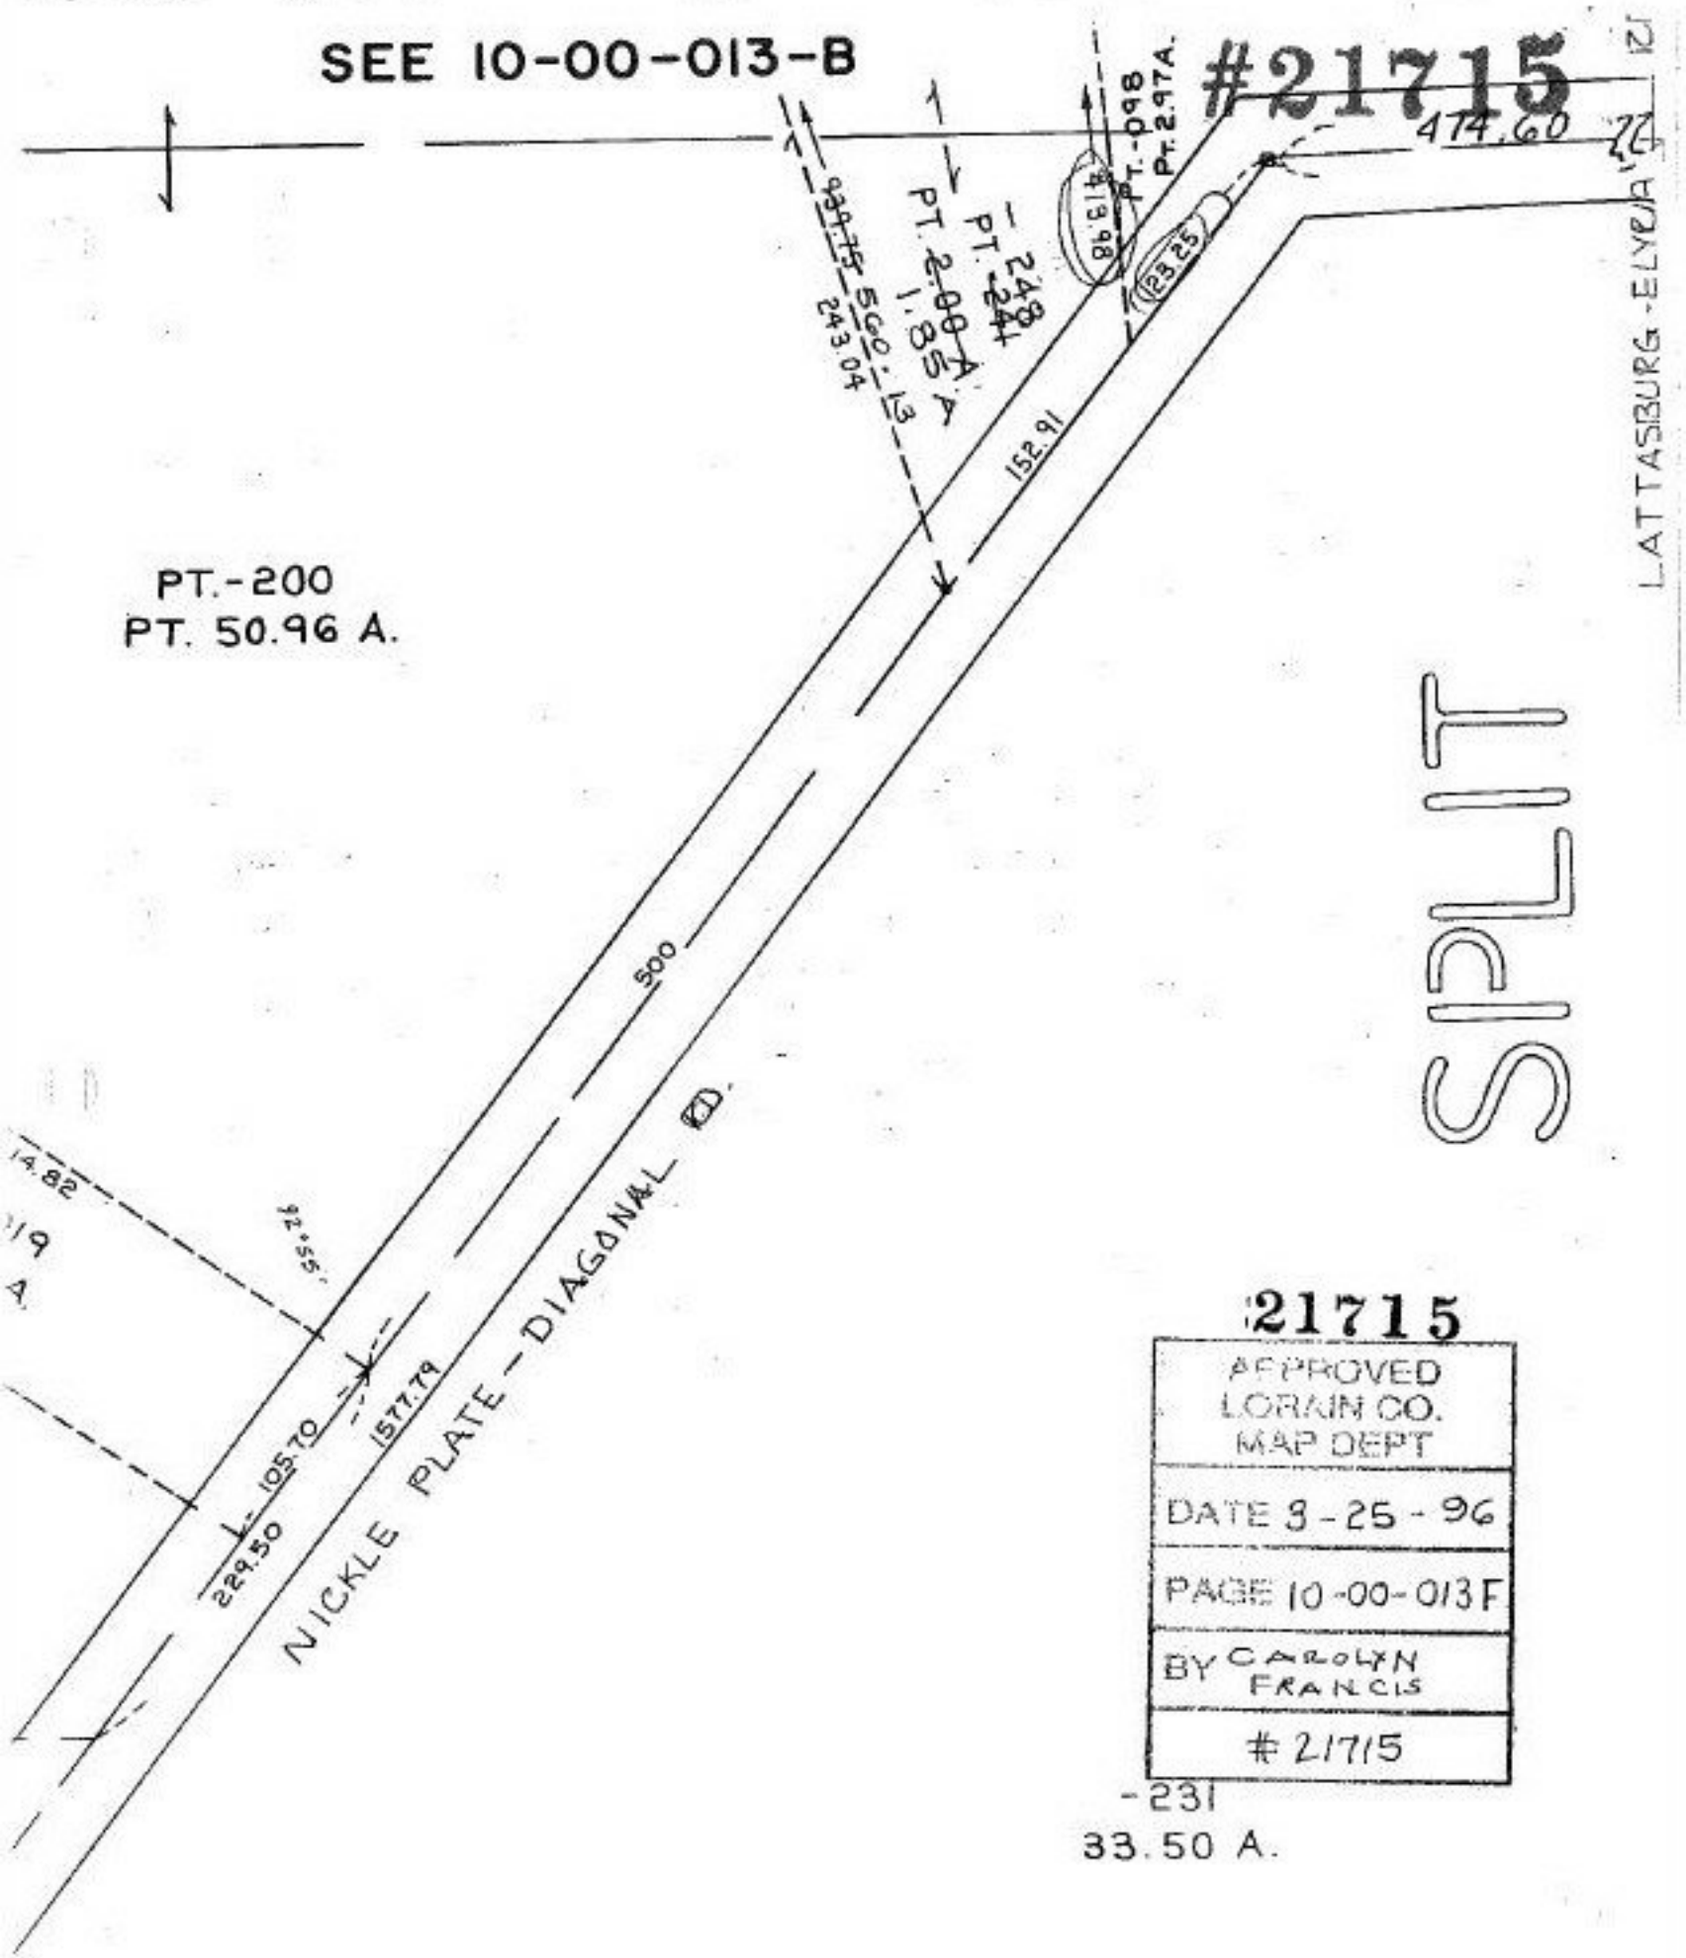

21715

APPROVED LORAIN CO. MAP DEPT
DATE 3-25-96
PAGE 10-00-013F
BY CAROLYN FRANCIS
21715