#21716

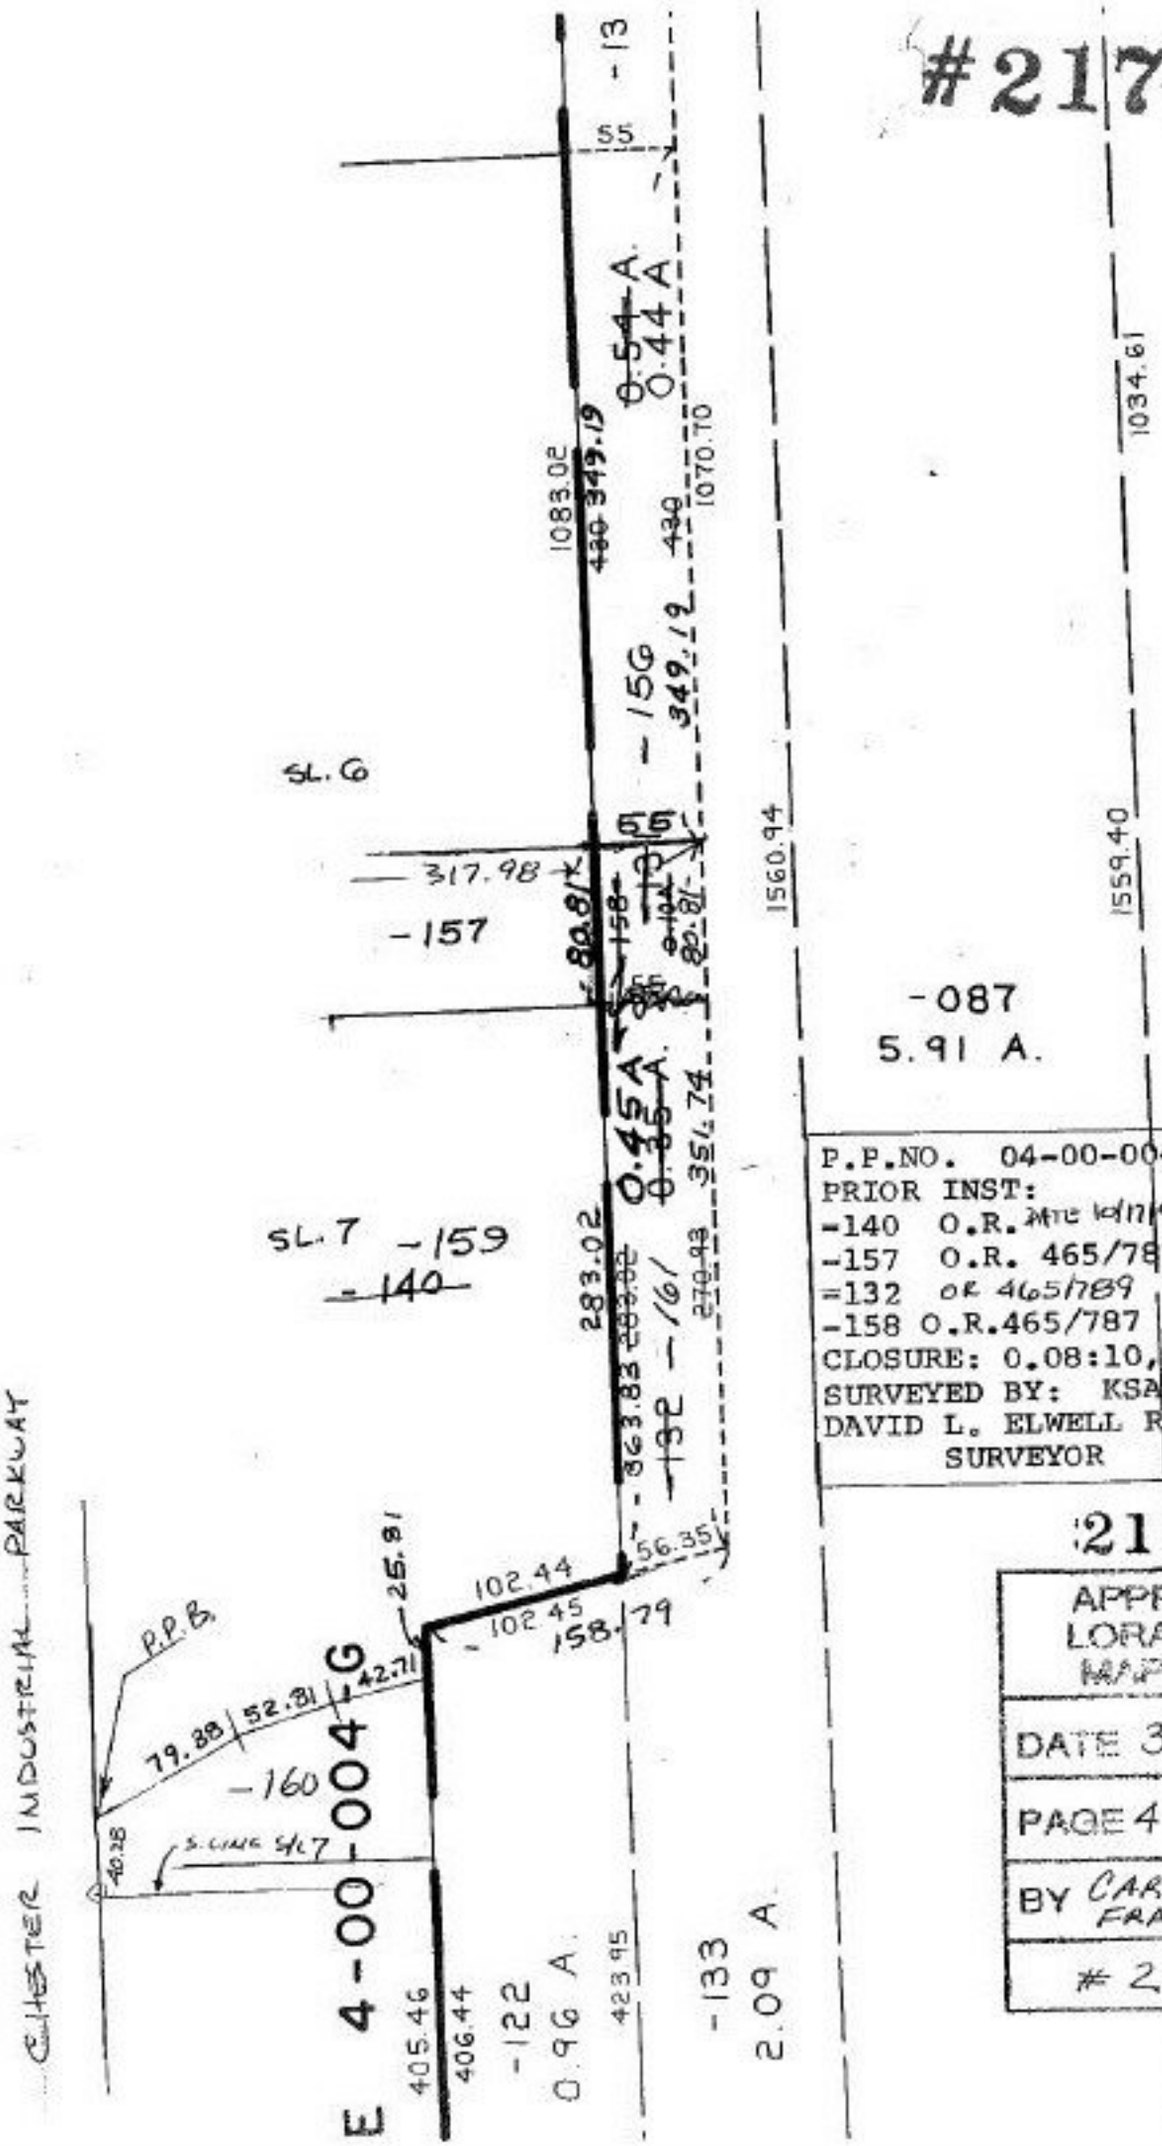

P.P.NO. 04-00-004-102-
PRIOR INST:
-140 O.R. DATE 10/17/91 or PCIT
-157 O.R. 465/787
-132 OR 465/789
-158 O.R.465/787
CLOSURE: 0.08:10,000
SURVEYED BY: KSASSOC.
DAVID L. ELWELL REG.
SURVEYOR

21716

APPROVED
LORAIN CO.
MAP DEPT

DATE 3-26-96

PAGE 4-00-004-H

BY CAROLYN FRANCIS

#21716