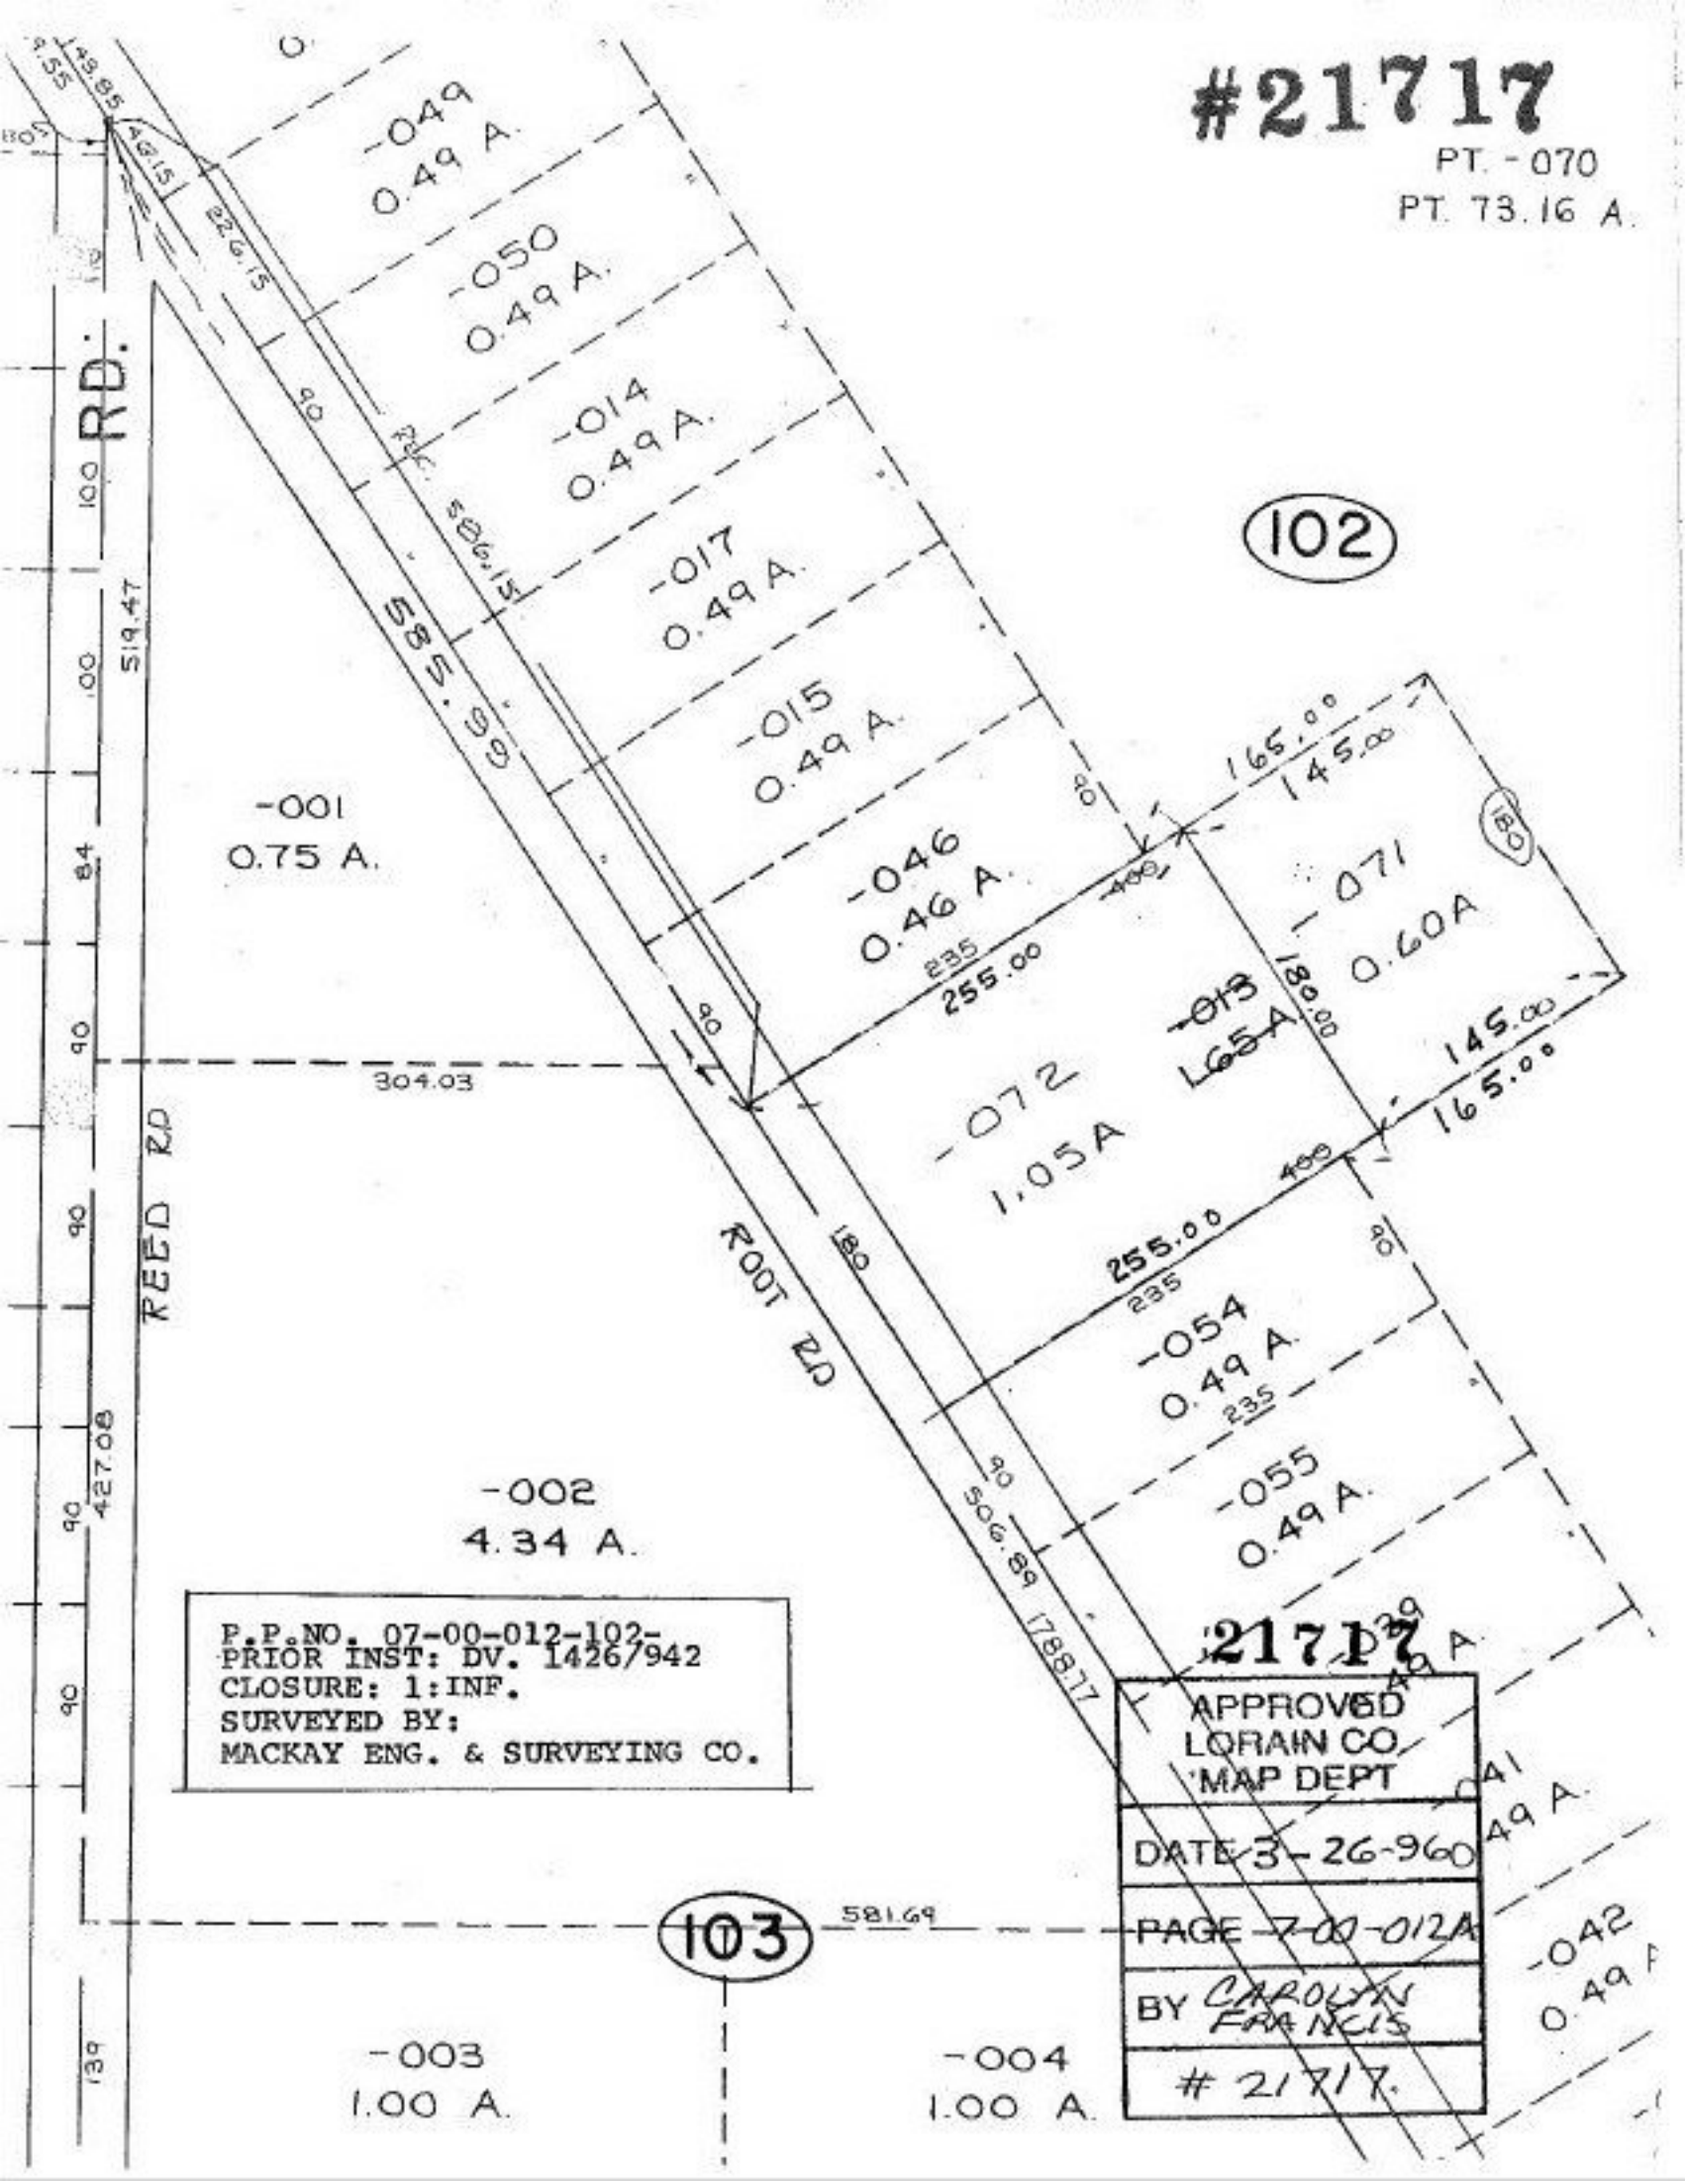
#21717
PT. -070
PT. 73.16 A.
102
103
RD.
REED RD
ROOT RD
-049
0.49 A.
-050
0.49 A.
-014
0.49 A.
-017
0.49 A.
-015
0.49 A.
-046
0.46 A.
-071
0.60A
-013
1.65A
-072
1.05A
-054
0.49 A.
-055
0.49 A.
-001
0.75 A.
-002
4.34 A.
-003
1.00 A.
-004
1.00 A.
-042
0.49 A.
519.47
427.08
304.03
581.69
585.99
586.15
255.00
165.00
145.00
180.00
506.89
1788.77
P.P.NO. 07-00-012-102-
PRIOR INST: DV. 1426/942
CLOSURE: 1:INF.
SURVEYED BY:
MACKAY ENG. & SURVEYING CO.
21717
APPROVED
LORAIN CO.
MAP DEPT
DATE 3-26-96
PAGE 7-00-012A
BY CAROLYN FRANCIS
21717.