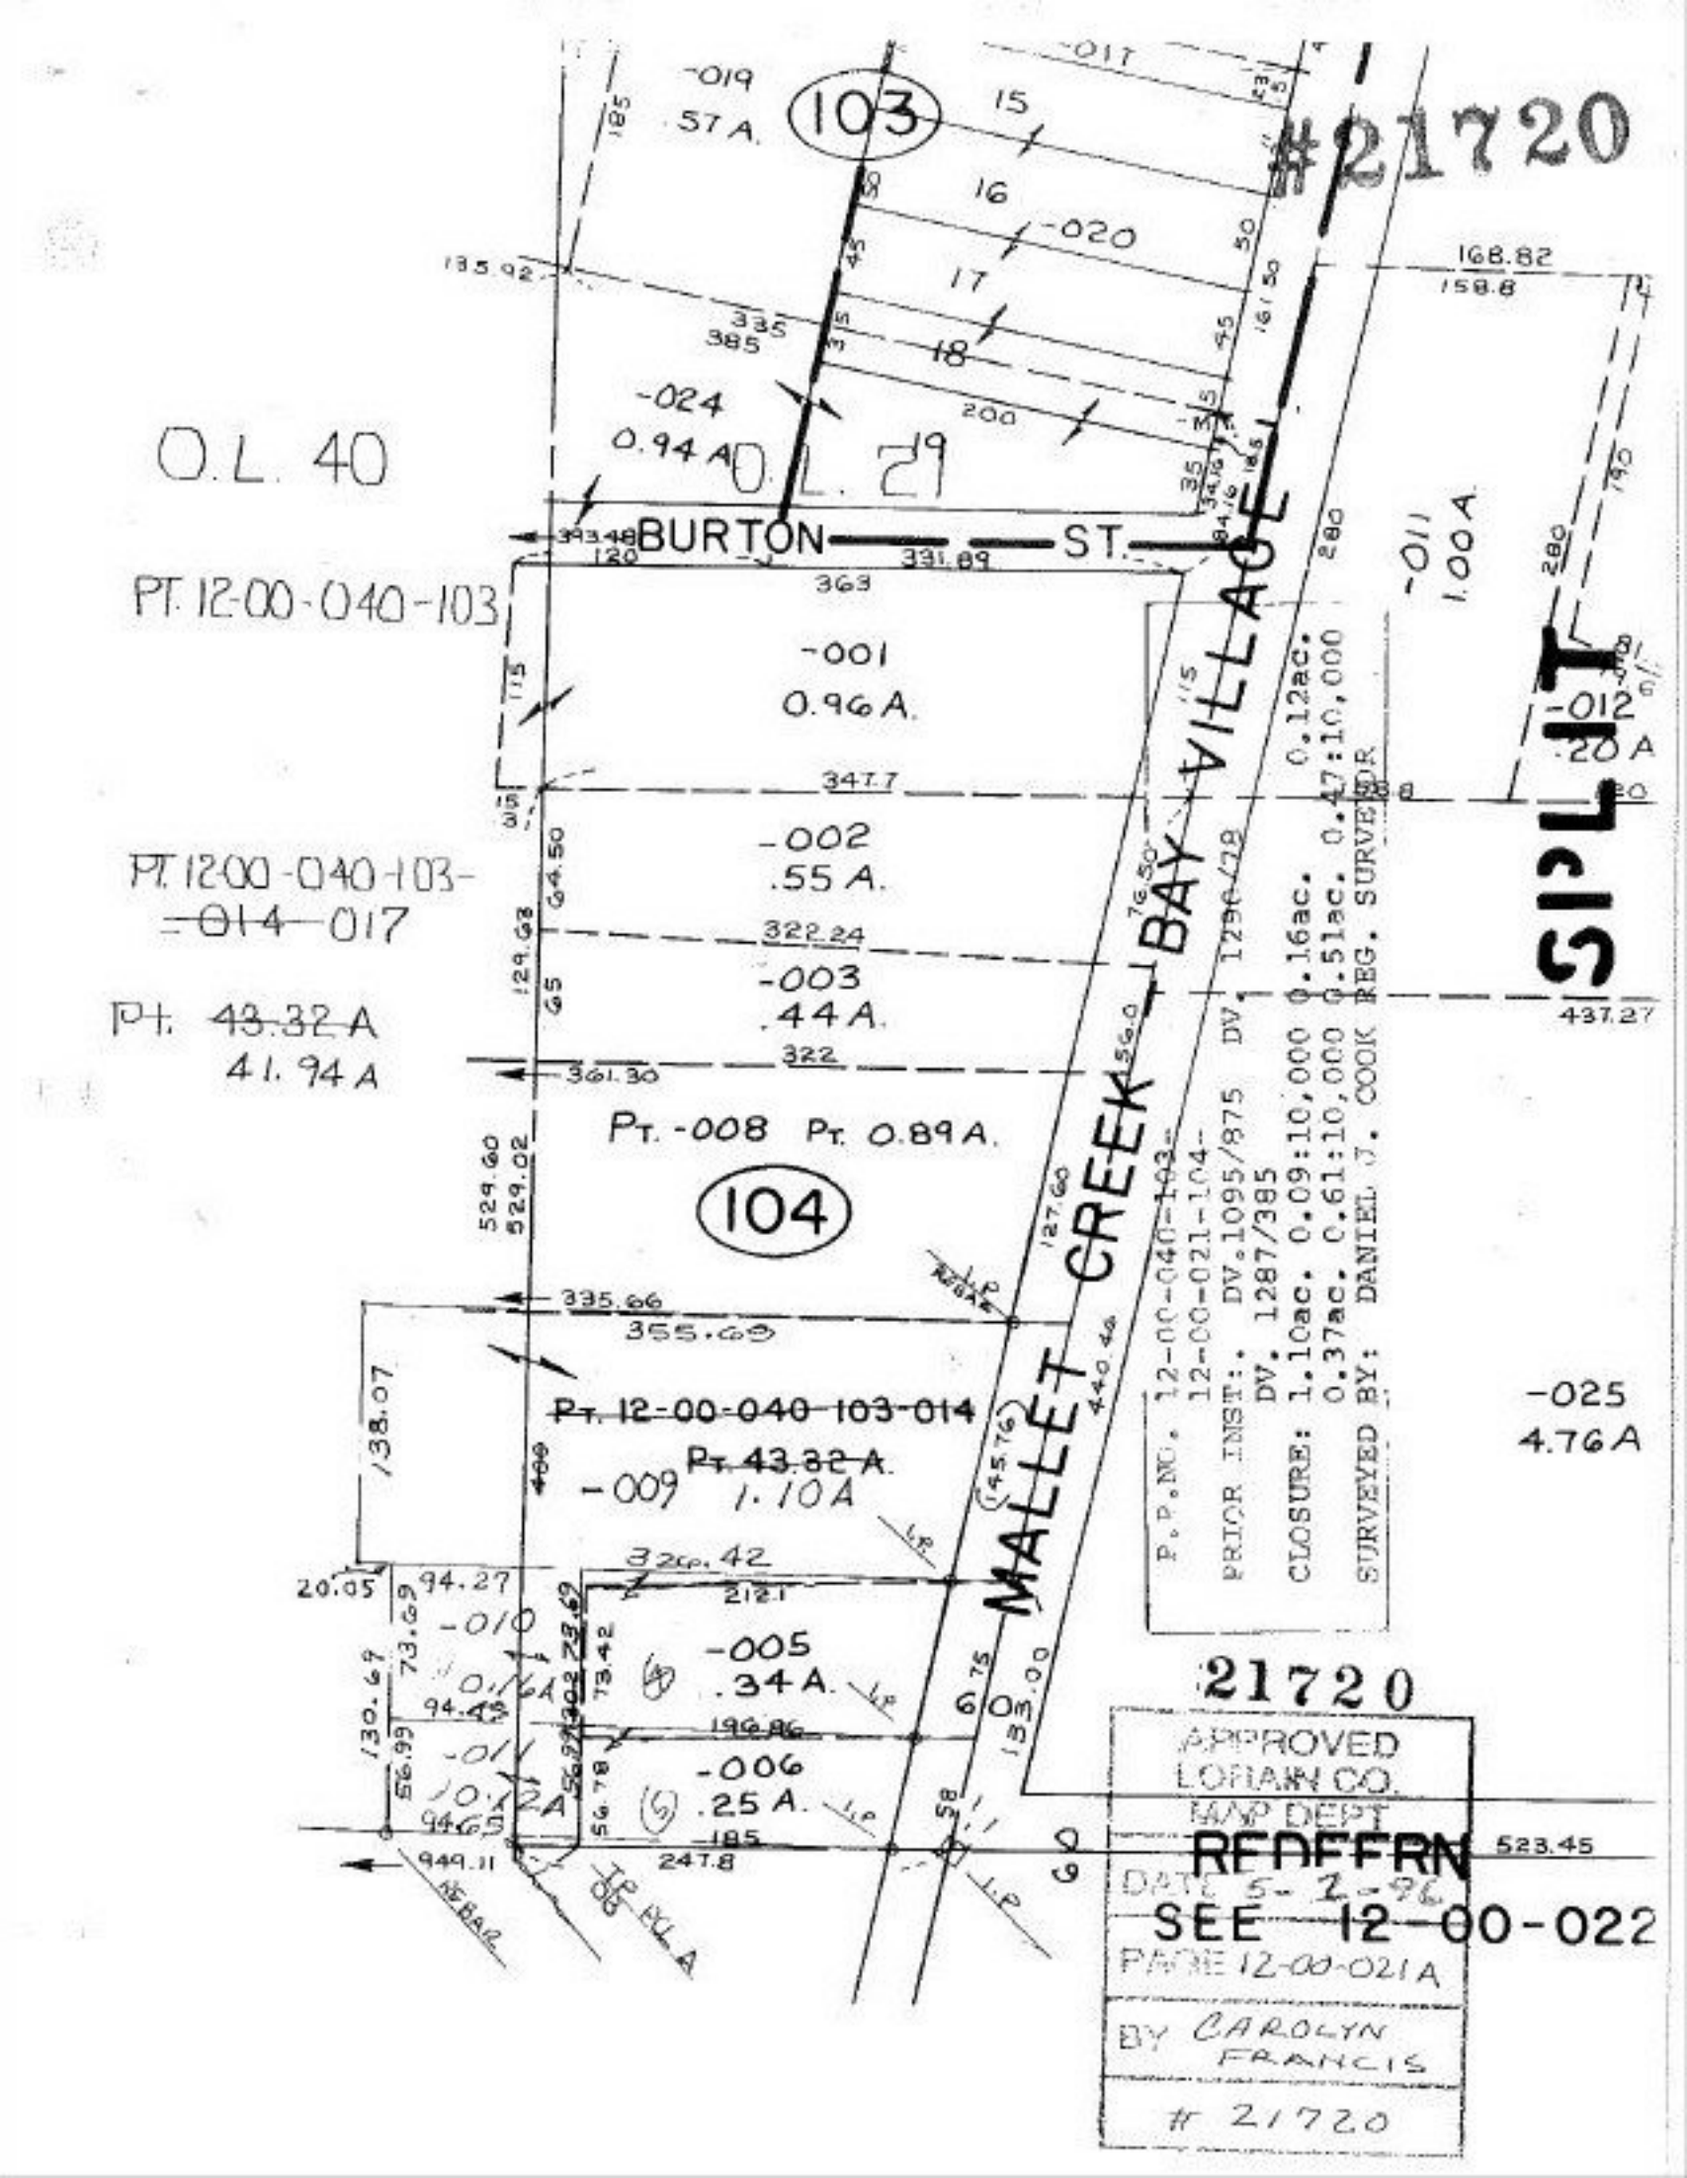
#21720
O.L. 40
O.L. 29
BURTON ST.
MALLET CREEK BAY VILLAGE
103
104
-019
57 A.
-020
0.94 A
-024
PT. 12-00-040-103
-001
0.96 A.
-002
.55 A.
PT. 12-00-040-103-014-017
-003
.44 A.
PT. 43.32 A
41.94 A
PT. -008 PT. 0.89 A.
PT. 12-00-040-103-014
PT. 43.32 A.
-009 1.10 A
-010
0.16 A
-005
.34 A.
-011
1.00 A.
-012
.20 A
-025
4.76 A
-006
.25 A
P.P.NO. 12-00-040-103-
12-00-021-104-
PRIOR INST:. DV. 1095/875 DV. 1296/28
DV. 1287/385
CLOSURE: 1.10ac. 0.09:10,000 0.16ac. 0.12ac.
0.37ac. 0.61:10,000 0.51ac. 0.47:10,000
SURVEYED BY: DANIEL J. COOK REG. SURVEYOR
21720
APPROVED
LORAIN CO.
MAP DEPT
REDFERN
SEE 12-00-022
PAGE 12-00-021A
BY CAROLYN FRANCIS
21720