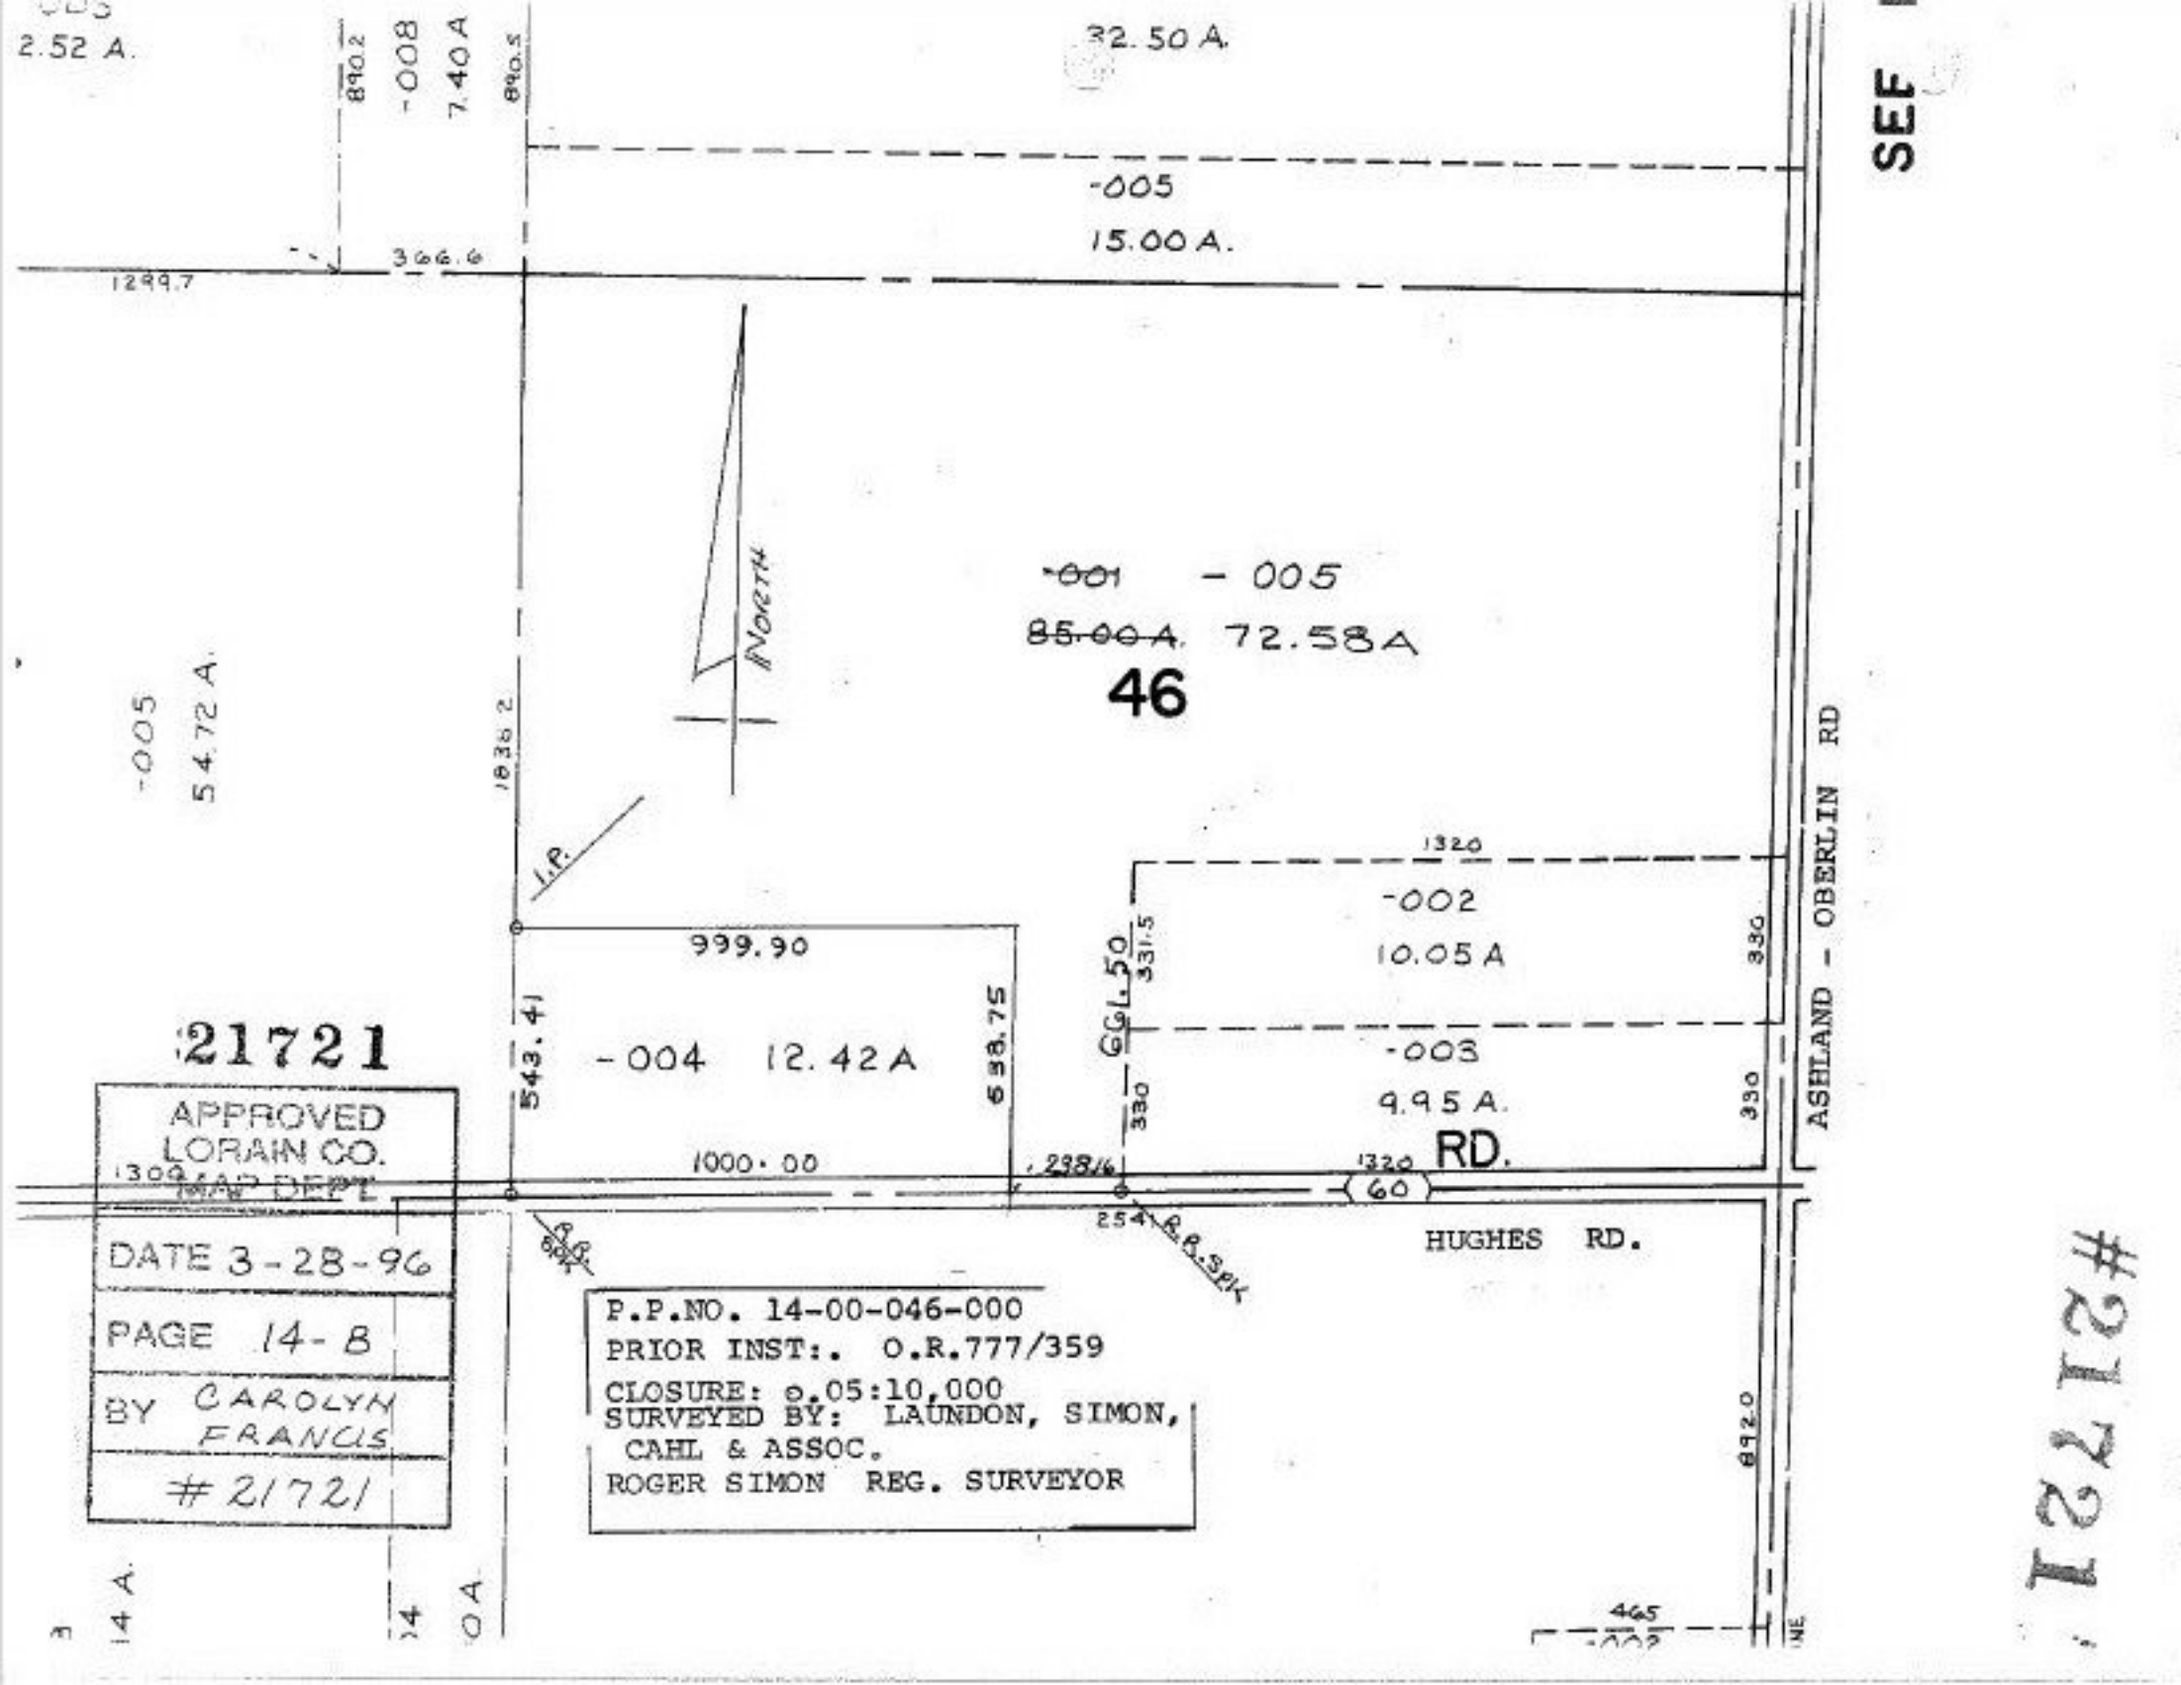

2.52 A.
890.2
-008
7.40 A
890.5
32.50 A.
SEE
-005
15.00 A.
366.6
1299.7
NORTH
~~-001~~ - 005
~~85.00 A.~~ 72.58 A
46
-005
54.72 A.
1836.2
I.P.
1320
-002
10.05 A
999.90
331.5
GGL.50
330
-003
9.95 A.
543.41
-004 12.42 A
638.75
330
330
ASHLAND - OBERLIN RD
21721
APPROVED
LORAIN CO.
MAP DEPT
1000.00
1320
RD.
60
254
R.R. SPK
HUGHES RD.
DATE 3-28-96
PAGE 14-B
BY CAROLYN FRANCIS
#21721
P.P.NO. 14-00-046-000
PRIOR INST:. O.R.777/359
CLOSURE: 0.05:10,000
SURVEYED BY: LAUNDON, SIMON, CAHL & ASSOC.
ROGER SIMON REG. SURVEYOR
892.0
465

#21721