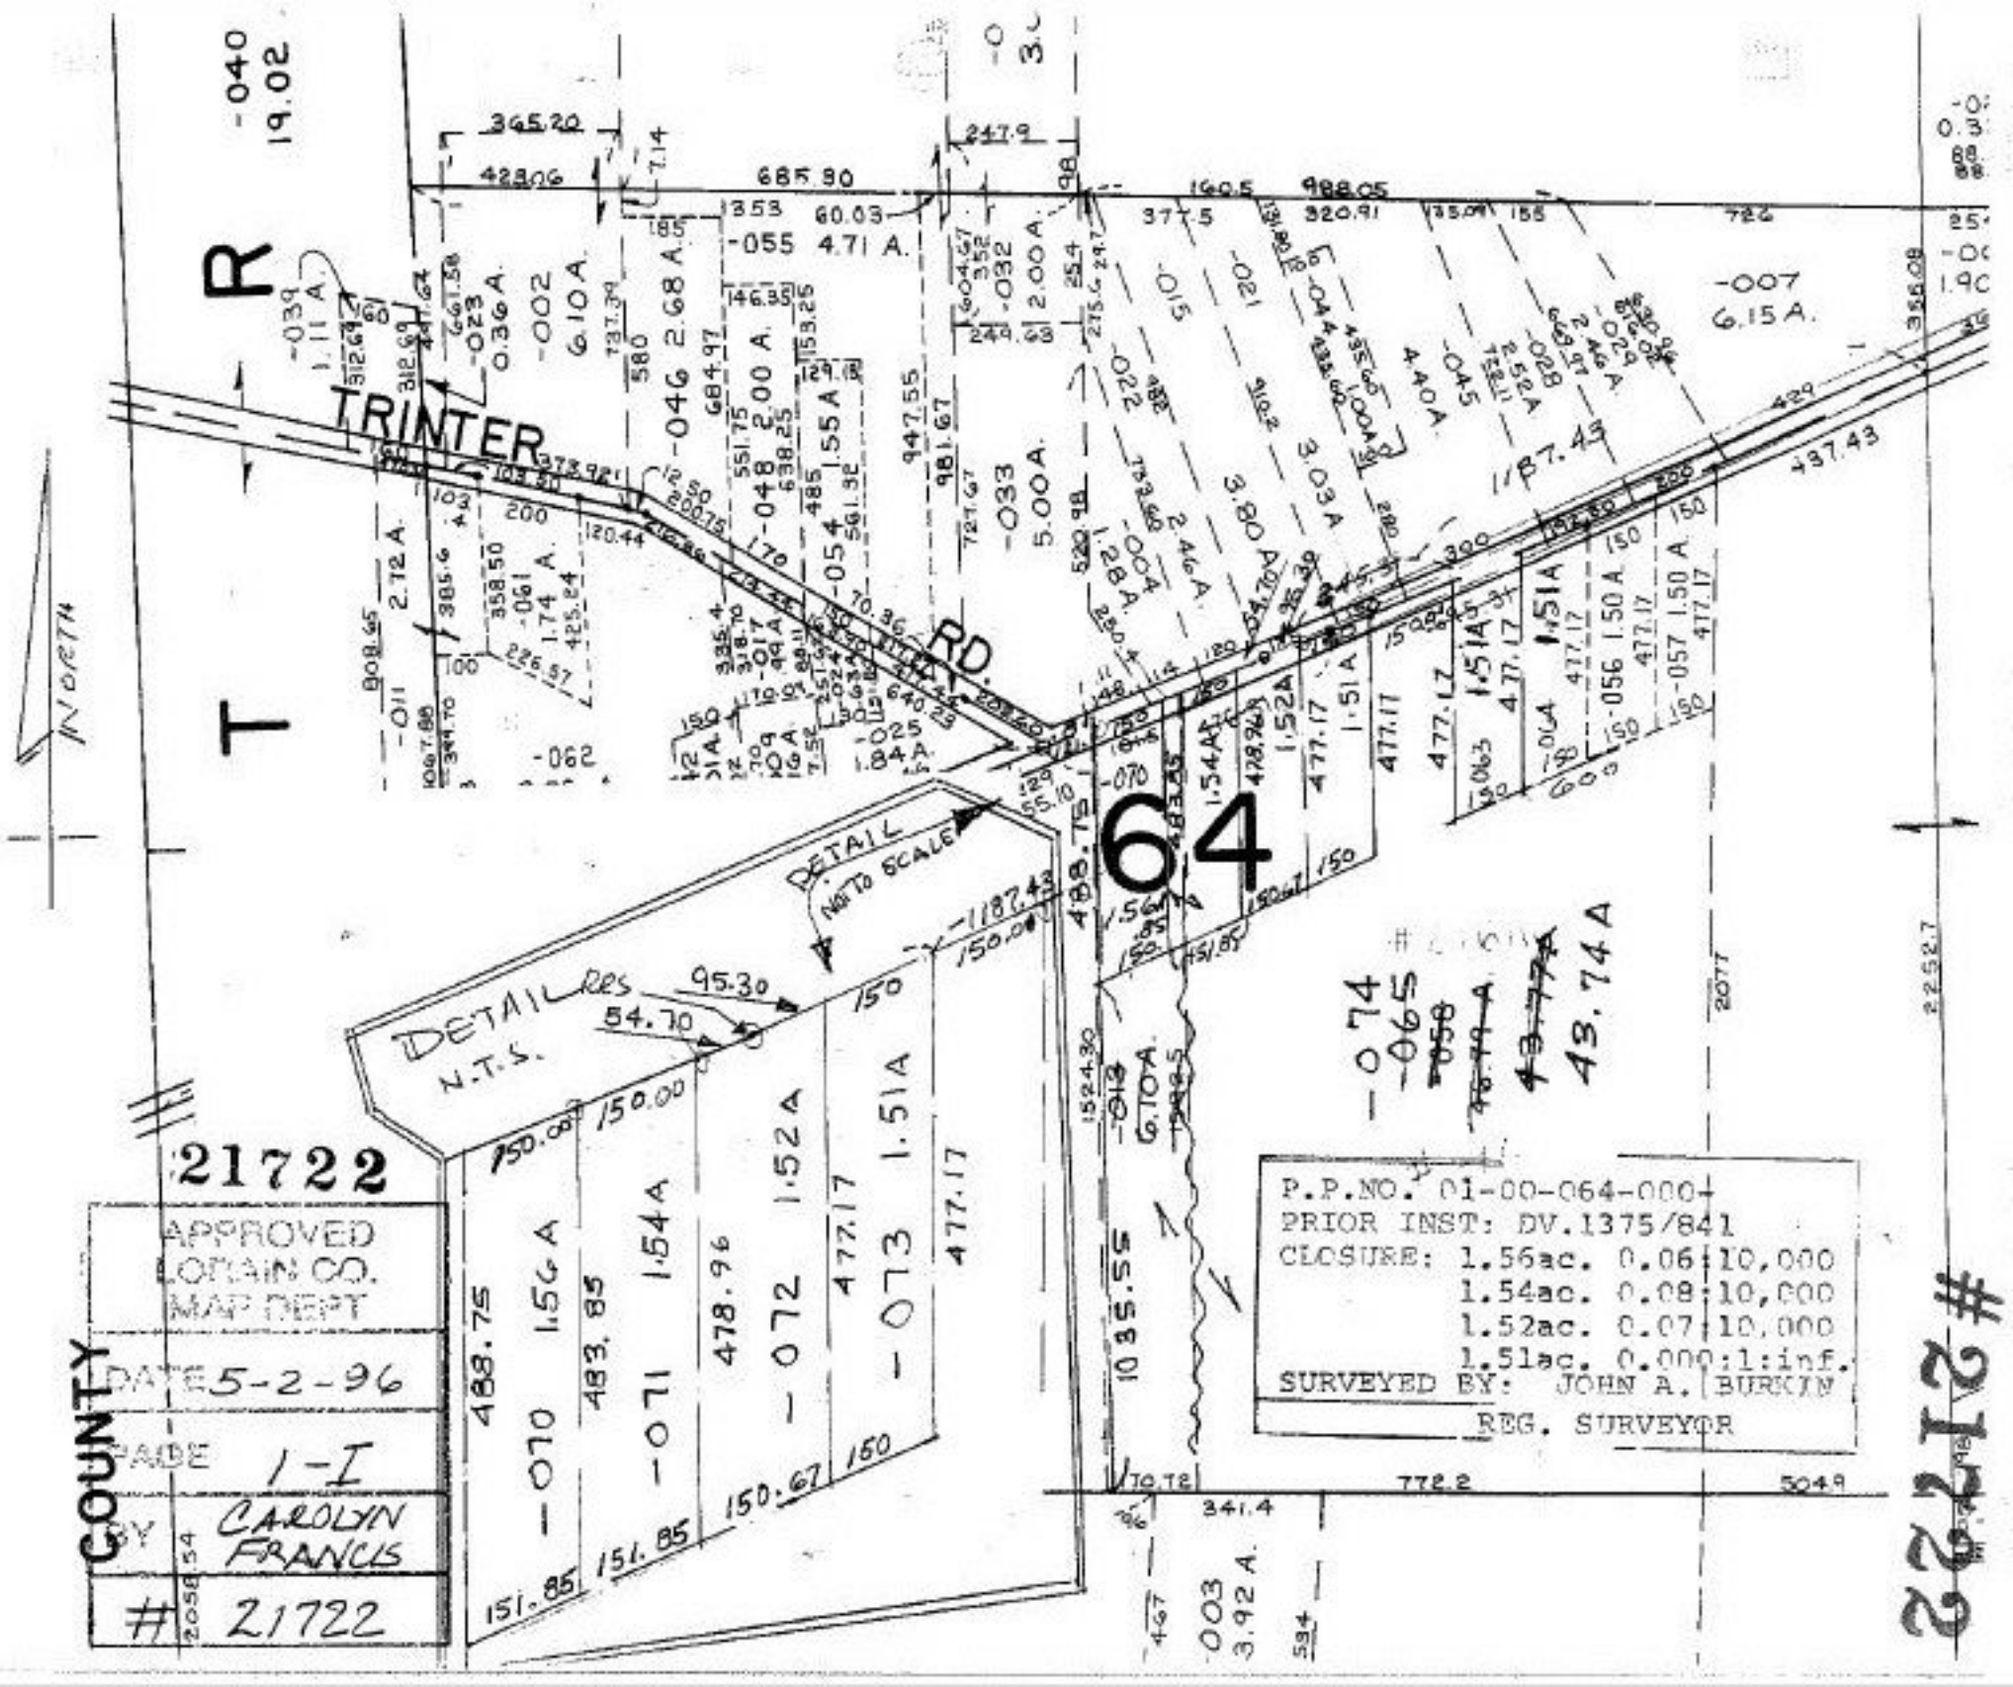
TRINTER RD.
64
DETAIL
NOT TO SCALE
DETAIL
N.T.S.
P.P.NO. 01-00-064-000+
PRIOR INST: DV.1375/841
CLOSURE: 1.56ac. 0.06:10,000
1.54ac. 0.08:10,000
1.52ac. 0.07:10,000
1.51ac. 0.000:1:inf.
SURVEYED BY: JOHN A. BURKIN
REG. SURVEYOR
APPROVED
FOR LAIN CO.
MAP DEPT
DATE 5-2-96
PAGE 1-I
BY CAROLYN FRANCIS
21722
COUNTY
21722
22122 #