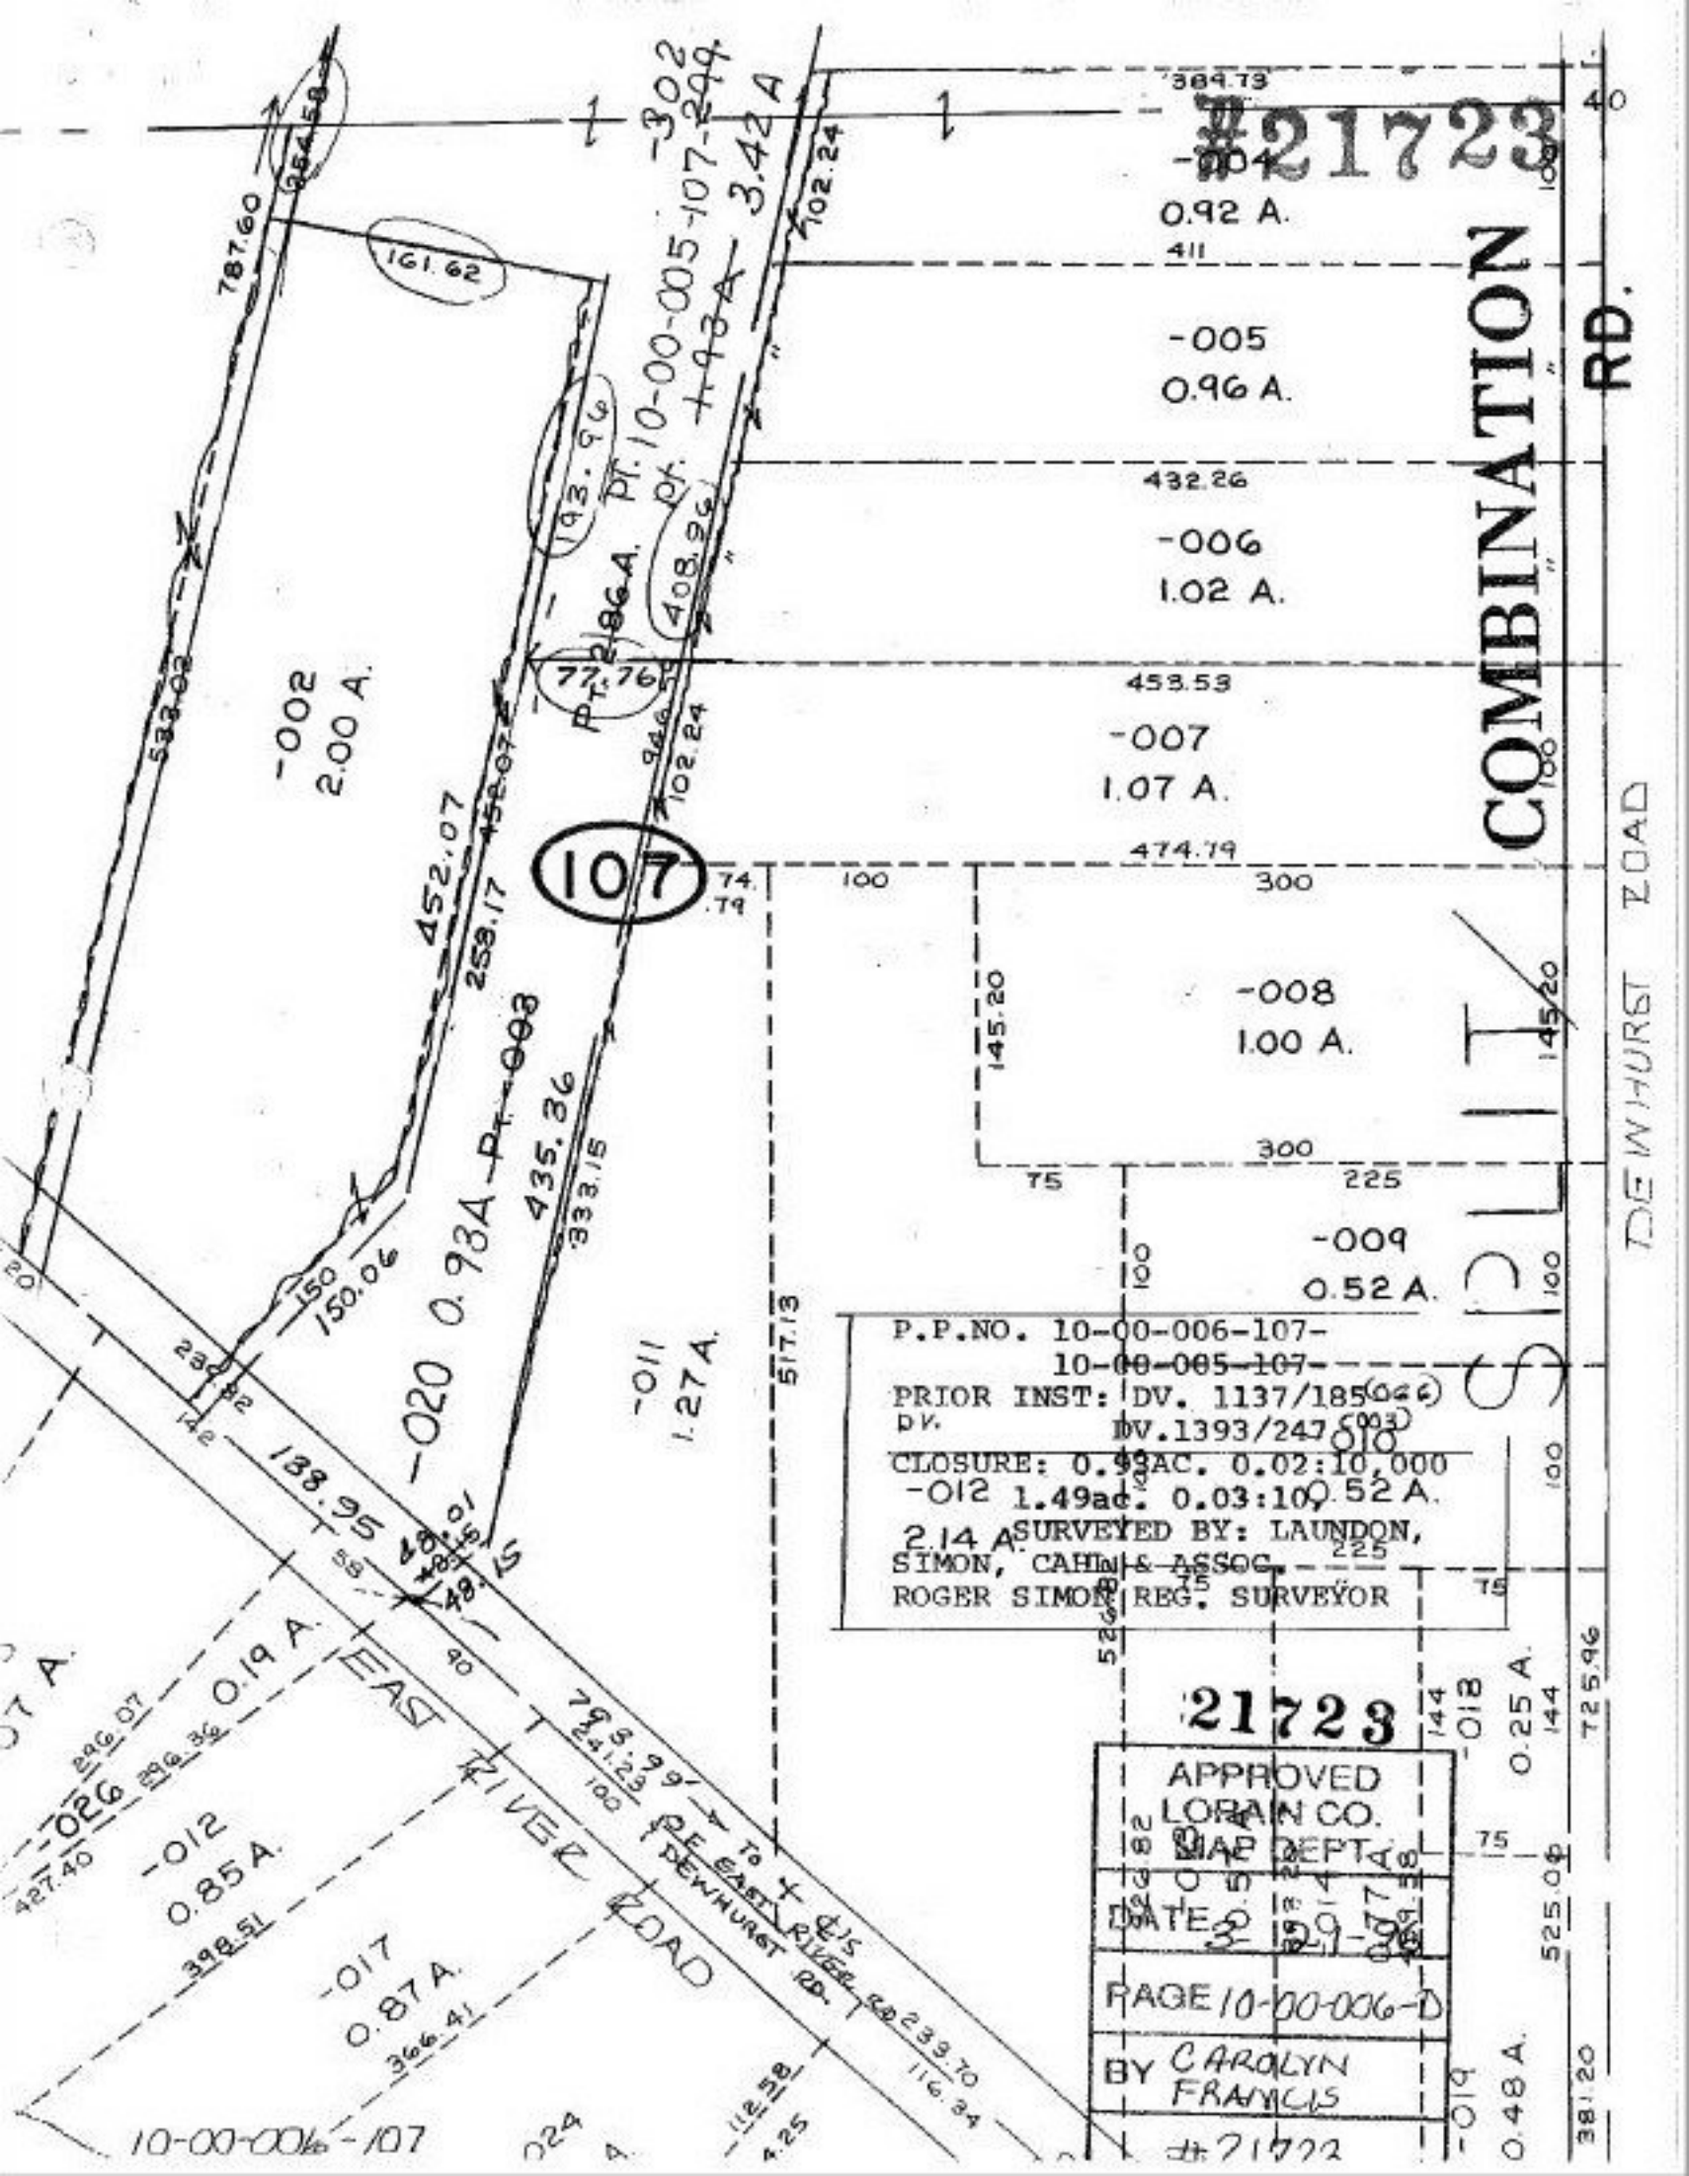
#21723
COMBINATION
RD.
DEWHURST ROAD
EAST RIVER ROAD
107
-002
2.00 A.
-003
0.92 A.
-005
0.96 A.
-006
1.02 A.
-007
1.07 A.
-008
1.00 A.
-009
0.52 A.
-010
0.52 A.
-011
1.27 A.
-012
0.85 A.
-017
0.87 A.
-018
0.25 A.
-019
0.48 A.
-020 0.934A Pt. 008
2.14 A
-026
0.19 A.
Pt. 10-00-005-107-249
3.42A
Pt. 2.86A.
P.P.NO. 10-00-006-107-
10-00-005-107-
PRIOR INST: DV. 1137/185
DV. 1393/247
CLOSURE: 0.93AC. 0.02:10,000
1.49ac. 0.03:10,
SURVEYED BY: LAUNDON, SIMON, CAHILL & ASSOC.
ROGER SIMON, REG. SURVEYOR
#21723
APPROVED
LORAIN CO.
MAP DEPT.
DATE 3-29-99
PAGE 10-00-006-D
BY CAROLYN FRANCIS
#21722
10-00-006-107