#21723-A

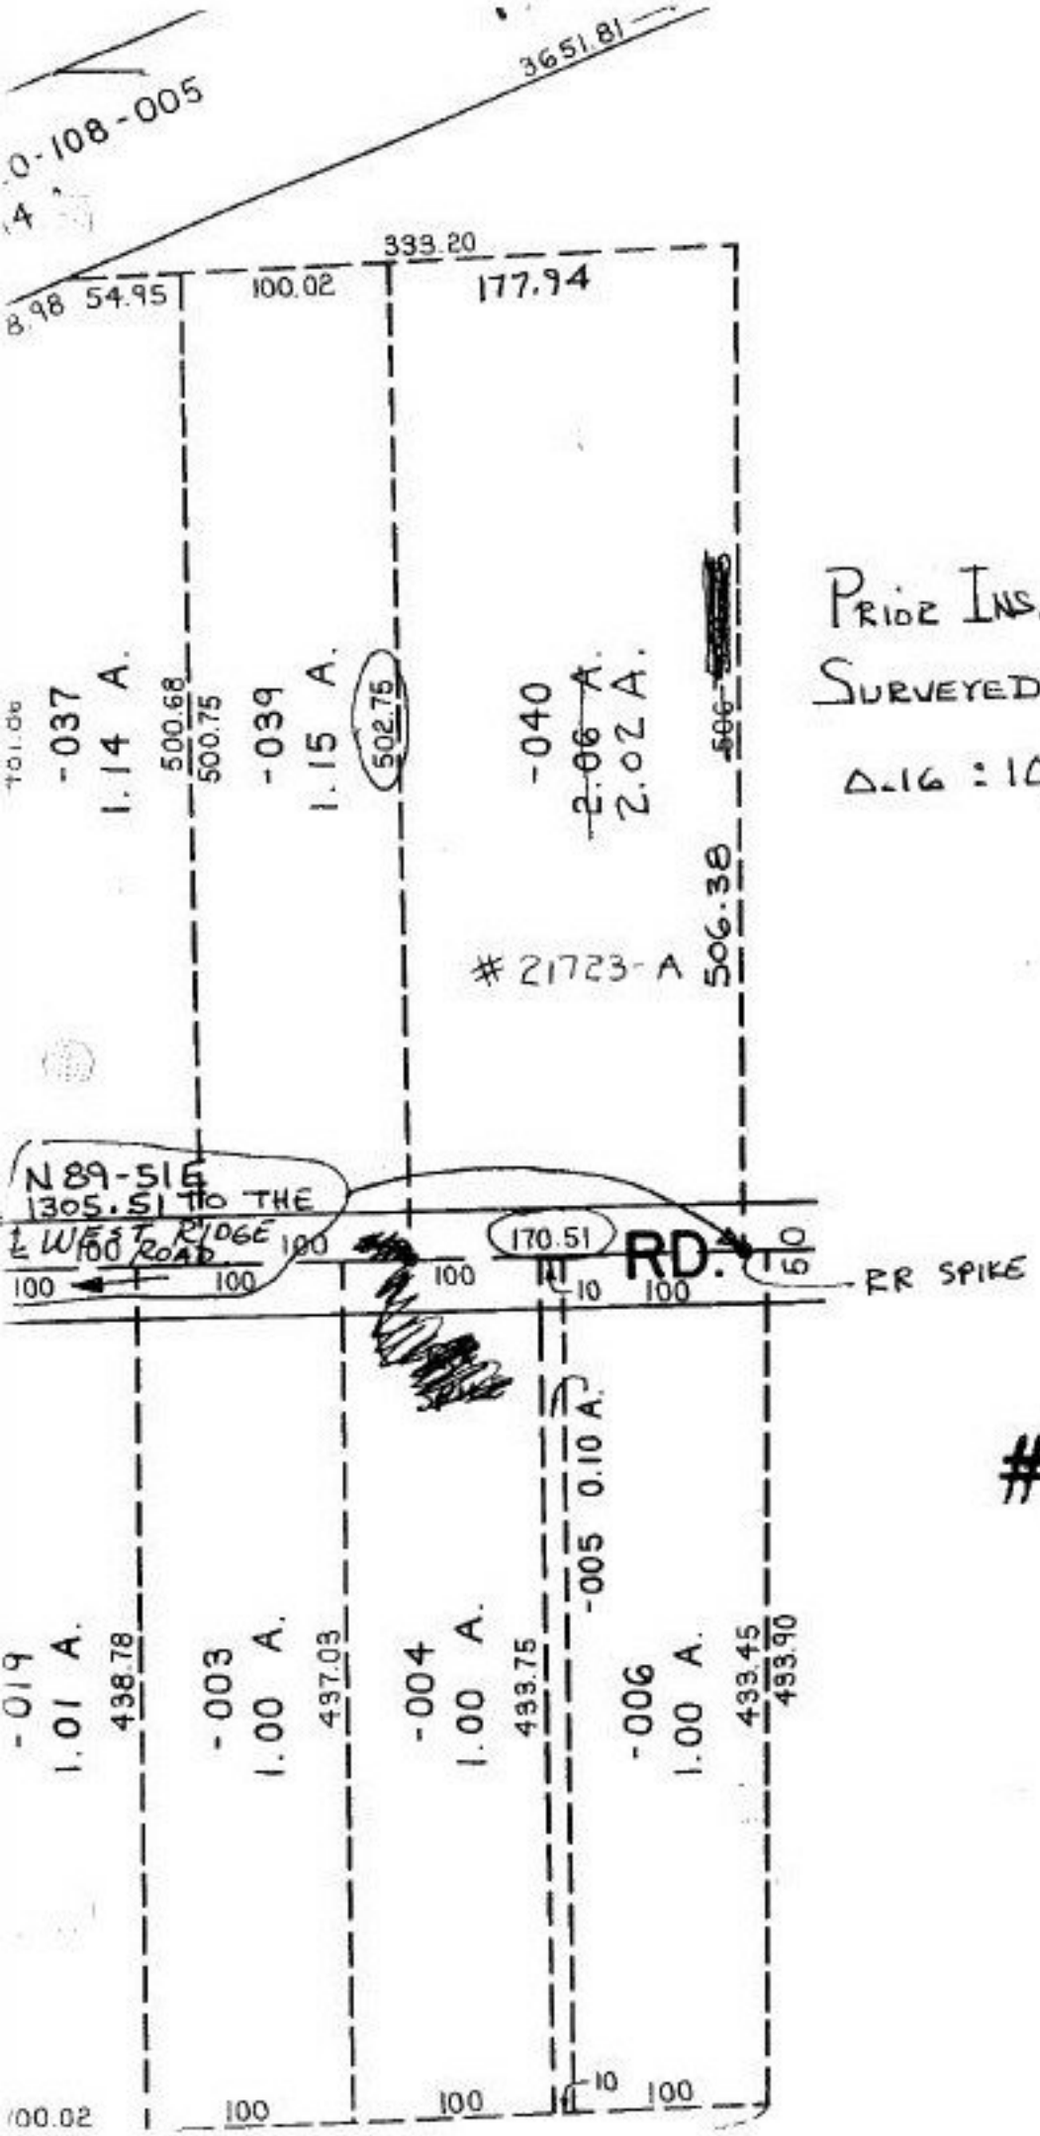

PRIOR INS. 1137/934

SURVEYED BY G.E. PENFOUND

D.16 : 10,000

#21723A

APPROVED
LORAIN CO.
MAP DEPT.
DATE 4-11-96
PAGE 6-19
BY
VOID AFTER 21723A