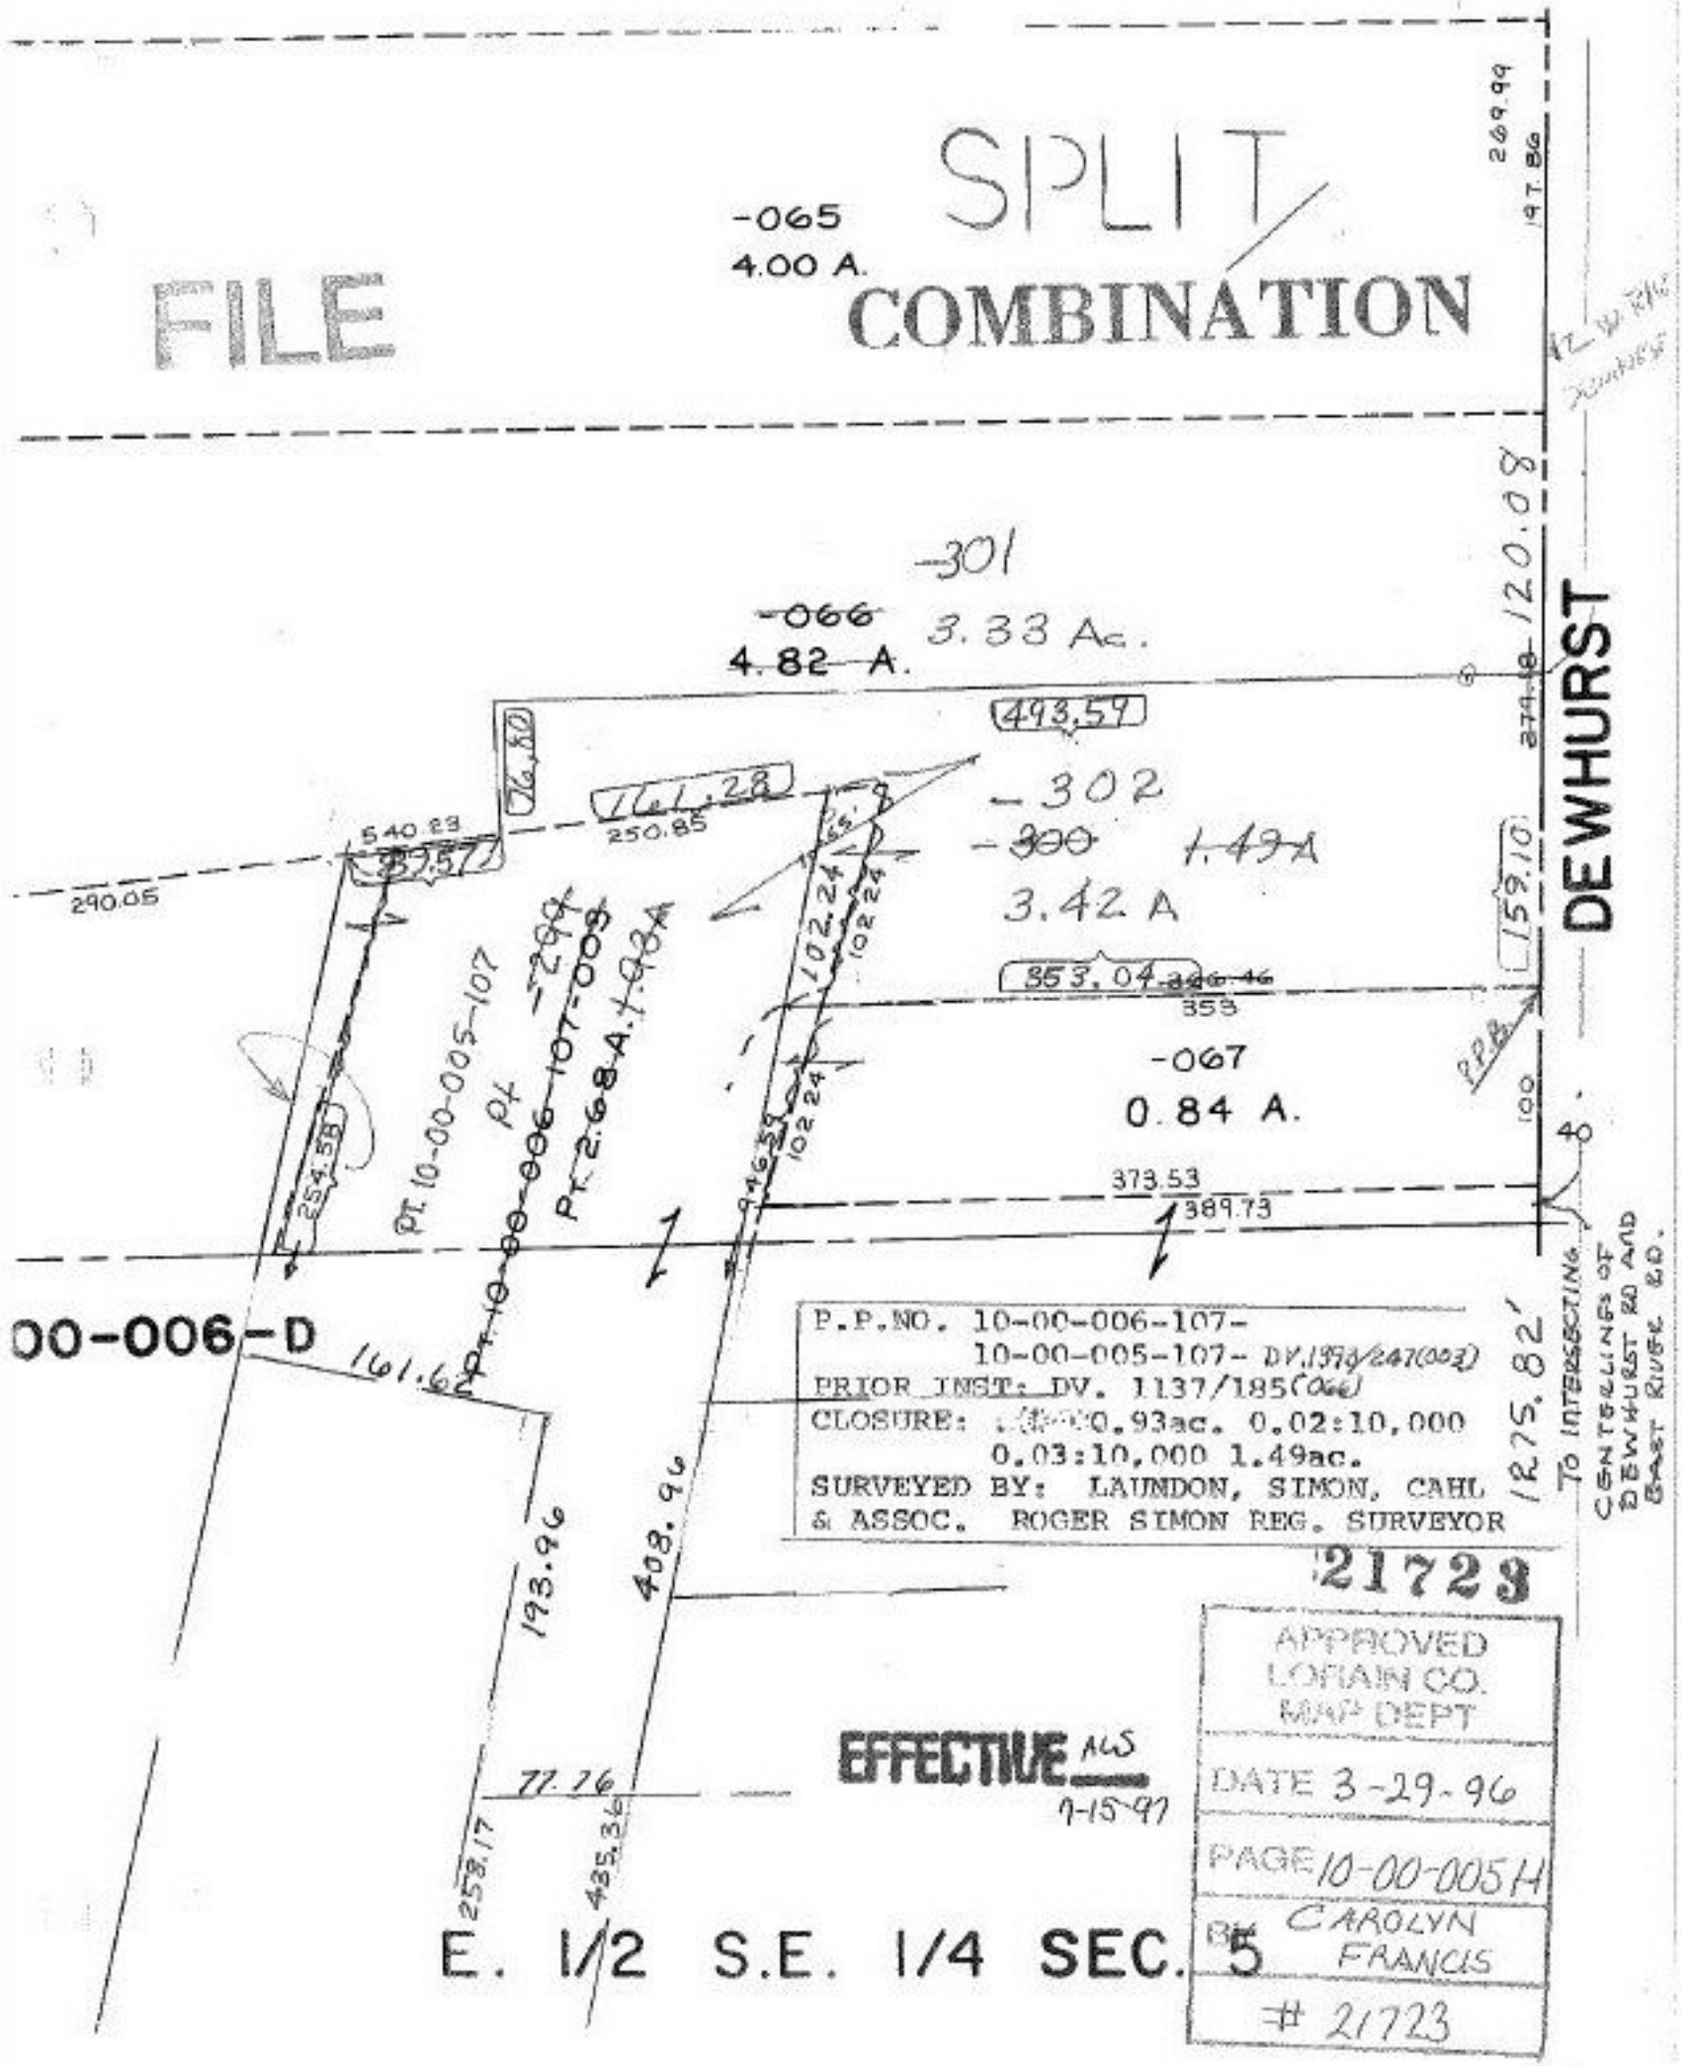

FILE
SPLIT
COMBINATION
-065
4.00 A.
269.99
197.86
-301
-066
4.82 A.
3.33 Ac.
120.08
DEWHURST
493.59
161.28
250.85
540.23
-302
-300
1.49 A
3.42 A
290.05
159.10
353.04
353
-067
0.84 A.
373.53
389.73
100
40
1275.82'
TO INTERSECTING CENTERLINES OF DEWHURST RD AND EAST RIVER RD.
PT. 10-00-005-107
PT. 10-00-006-107-003
PT. 2.68 A.
102.24
254.58
00-006-D
161.62
193.96
408.96
77.76
258.17
435.36
P.P.NO. 10-00-006-107-
10-00-005-107- DV.1398/247(003)
PRIOR INST: DV. 1137/185(066)
CLOSURE: 0.93ac. 0.02:10,000
0.03:10,000 1.49ac.
SURVEYED BY: LAUNDON, SIMON, CAHL & ASSOC. ROGER SIMON REG. SURVEYOR
21723
APPROVED LORAIN CO. MAP DEPT
DATE 3-29-96
PAGE 10-00-005H
BY CAROLYN FRANCIS
21723
EFFECTIVE ALS 7-15-97
E. 1/2 S.E. 1/4 SEC. 5

10-00-005-107-