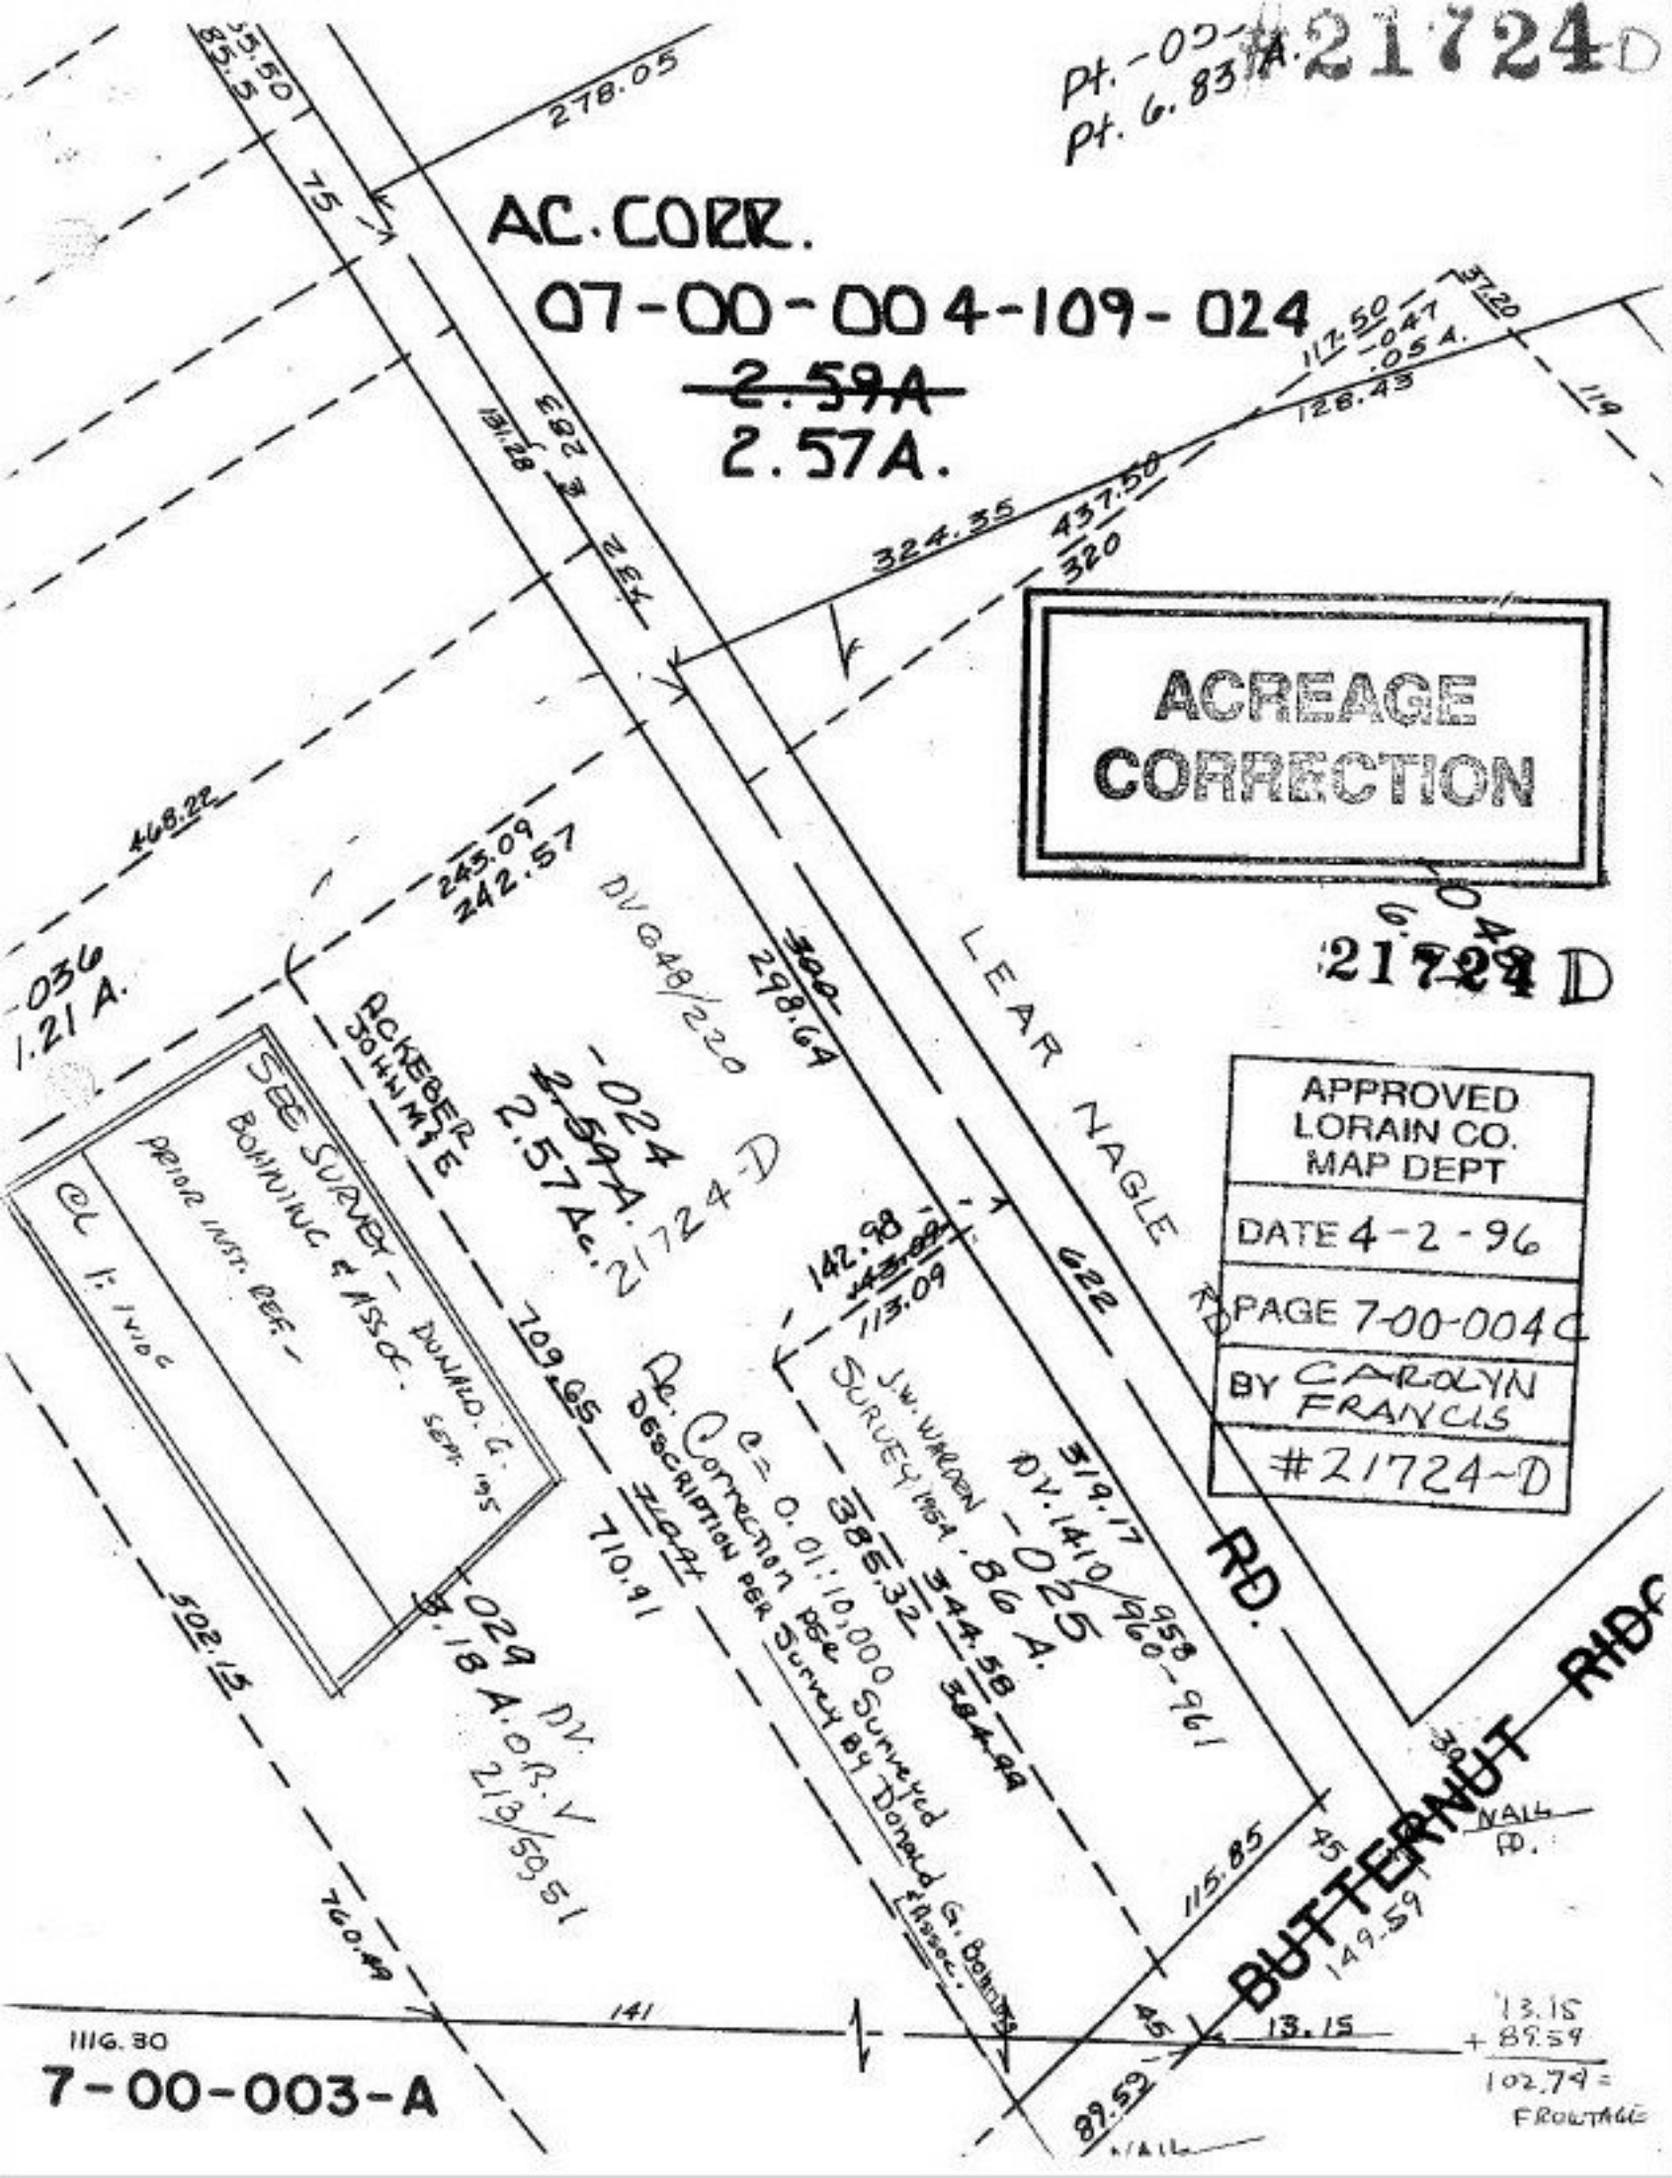

Pt. -05-
Pt. 6.83 A.
#21724 D
AC. CORR.
07-00-004-109-024
~~2.59A~~
2.57A.
ACREAGE CORRECTION
21724 D
APPROVED LORAIN CO. MAP DEPT
DATE 4-2-96
PAGE 7-00-004C
BY CAROLYN FRANCIS
#21724-D
LEAR NAGLE RD.
BUTTERNUT RIDGE RD.
ACKEBER JOHN M & E
SEE SURVEY - DONALD G. BOHNING & ASSOC. SEPT. '95
PRIOR INST. REF.
CL 1: 1 VIDE
DV 648/220
-024
~~2.59A.~~
2.57 Ac.
21724-D
-036
1.21 A.
-029
3.18 A. O.R.V
213/50,51
DV.
Re. Correction Pge Surveyed
DESCRIPTION PER Survey By Donald G. Bohning & Assoc.
C = 0.01:10,000
J.W. WARDEN SURVEY 1954
-025
.86 A.
DV. 1410/960-961
-047
.05 A.
-036
1.21 A.
-049
6.83 A.
278.05
324.35
437.50
320
128.43
117.50
37.20
468.22
243.09
242.57
298.64
142.98
113.09
709.65
710.91
385.32
344.58
319.17
958
622
502.15
760.49
115.85
149.59
141
13.15
89.59
1116.30
7-00-003-A
13.15
+ 89.59
102.74 =
FRONTAGE
NAIL