PRIOR DEED DV. 152/521
REF. DEED #

AC. CORR.
TO 07-00-021-101-022
AC. CHANGE PER O.R. 1231/876
SHERIFFS DEED

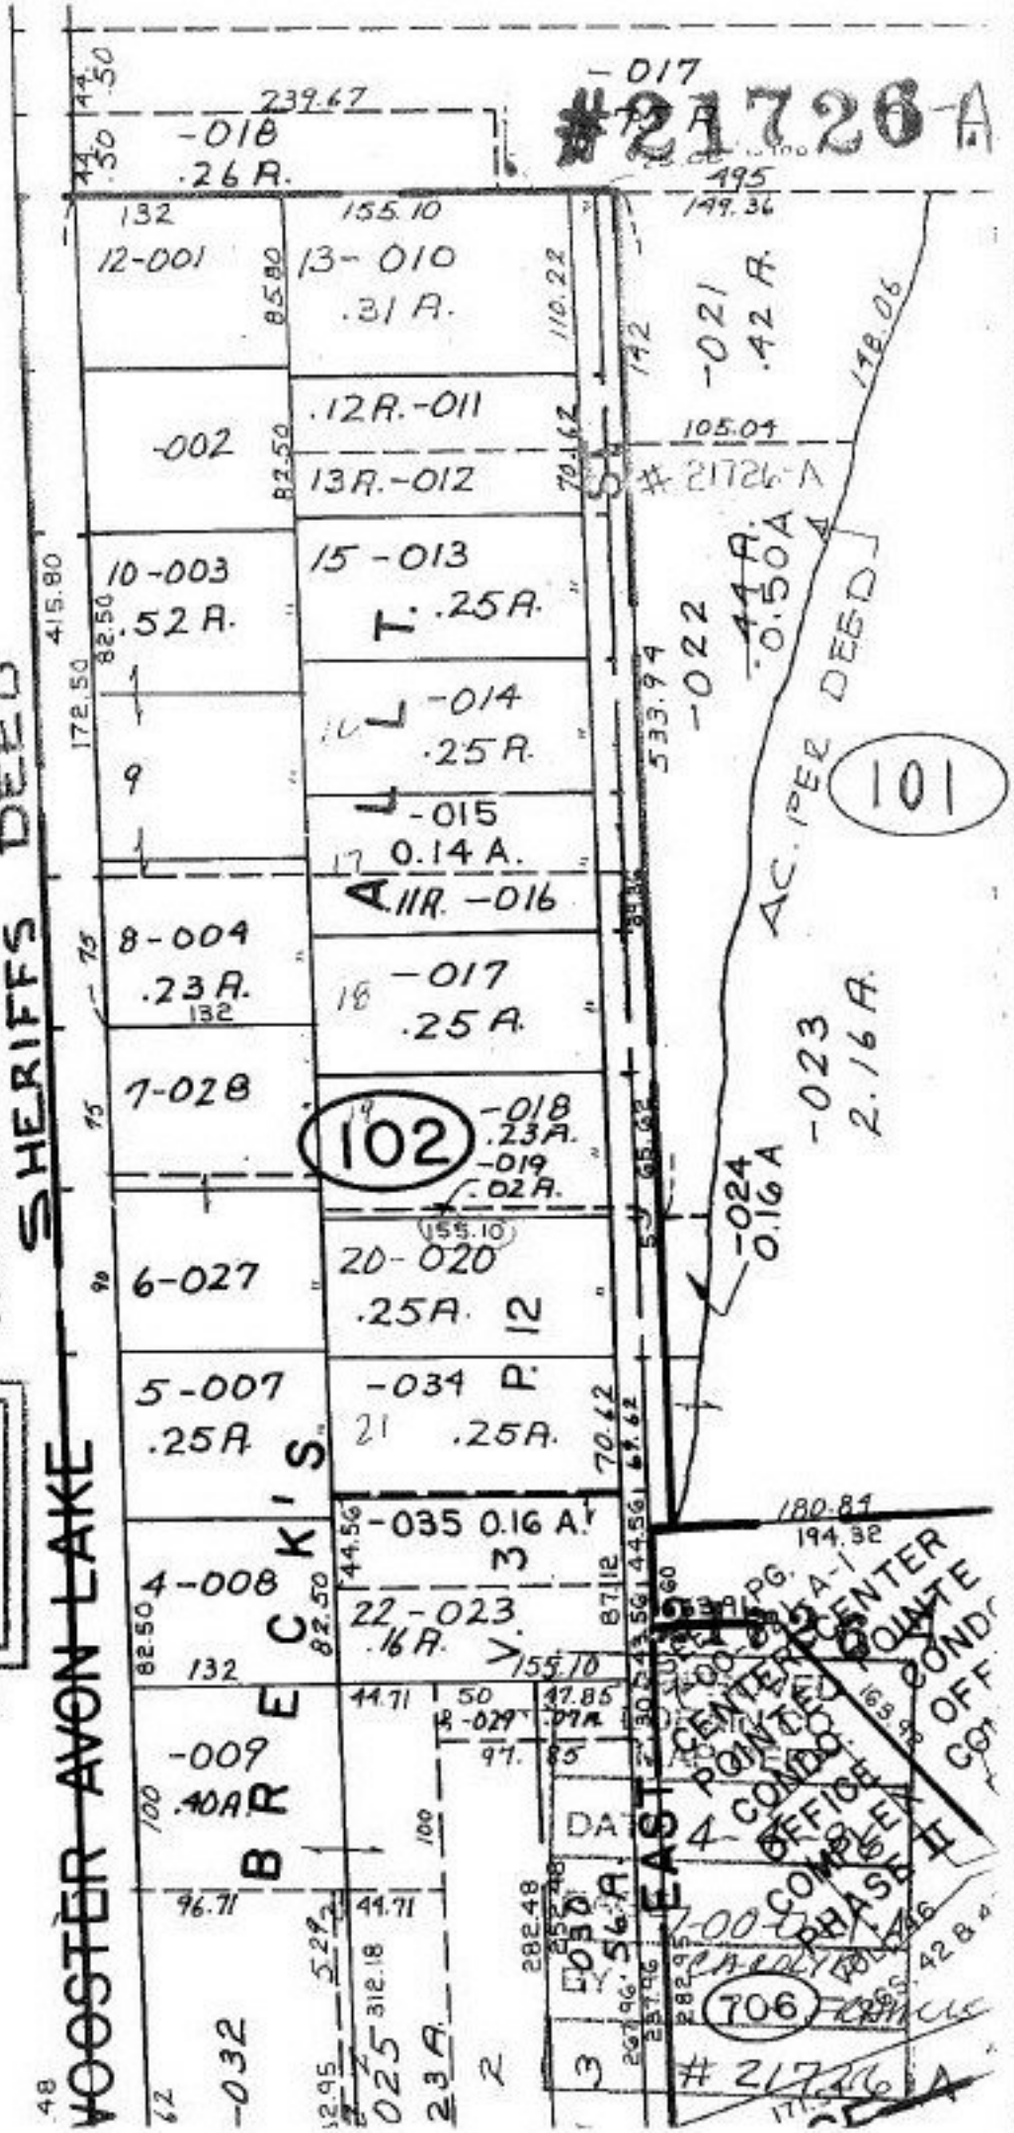

ACREAGE CORRECTION

21726 A

APPROVED
LORAIN CO.
MAP DEPT

DATE 4-4-96

PAGE 7-00-021A

BY CAROLYN FRANCIS