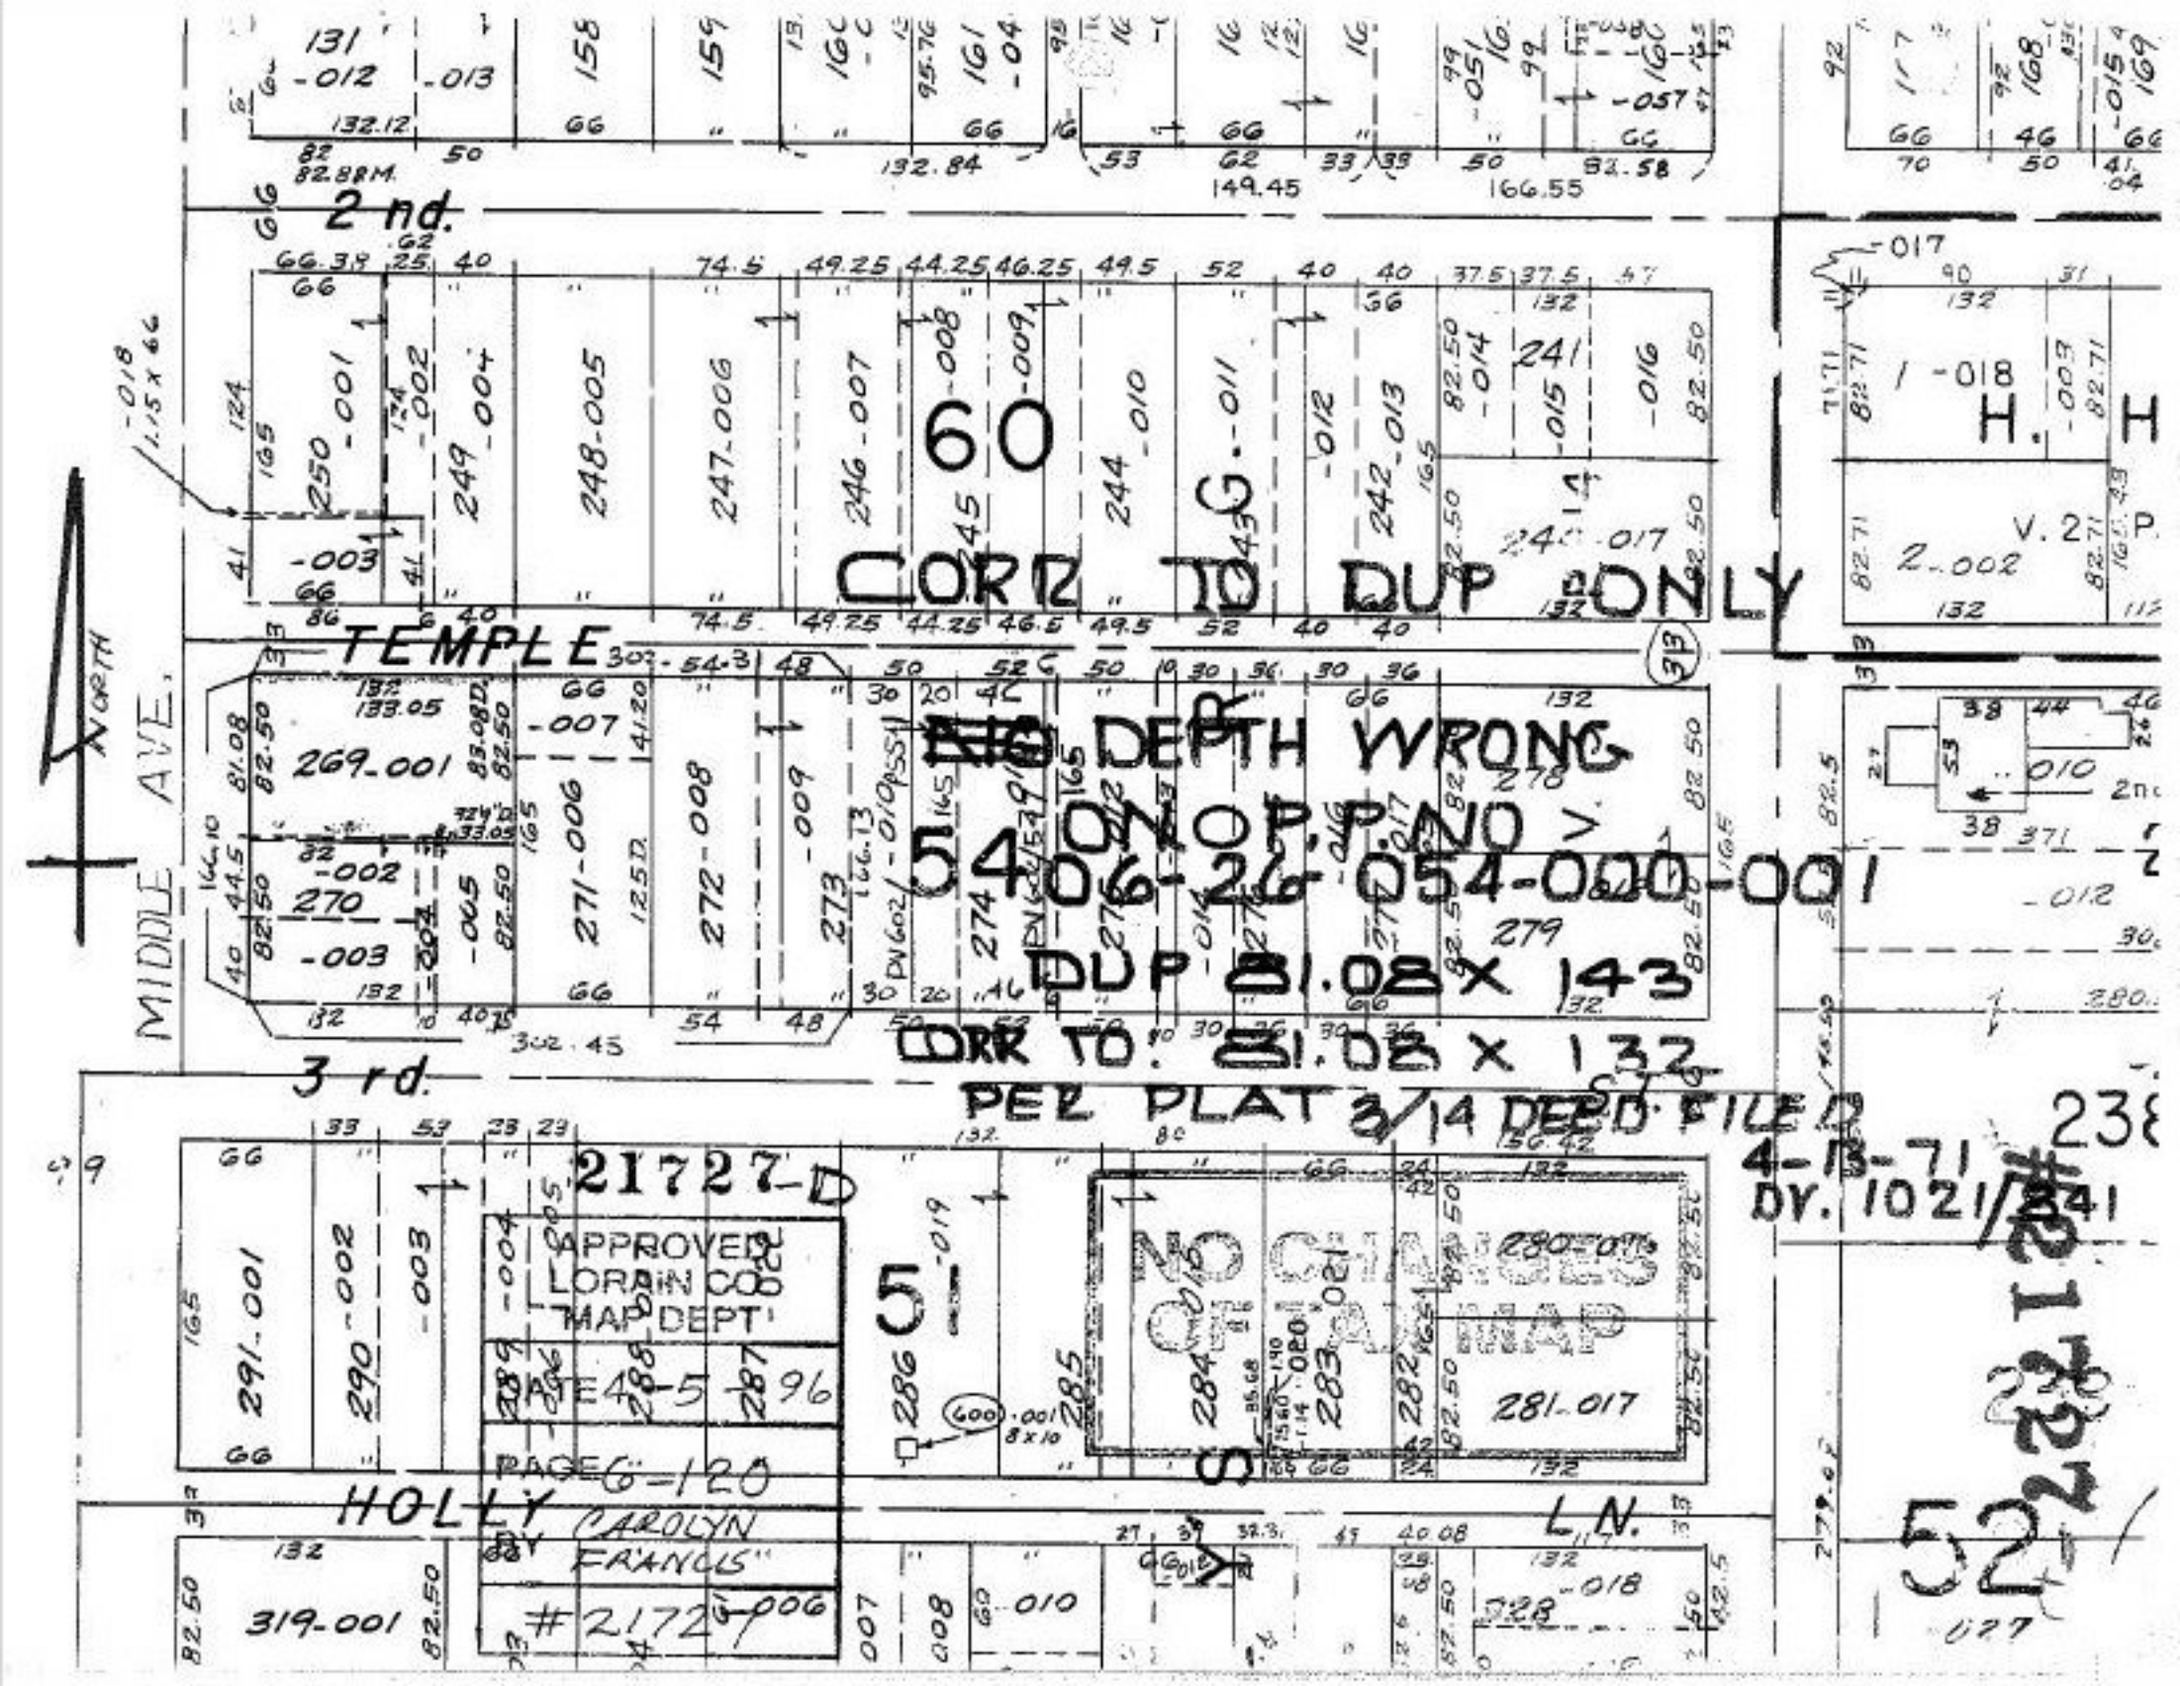
2nd.
3rd.
TEMPLE
HOLLY
MIDDLE AVE.
NORTH
CORR TO DUP ONLY
DEPTH WRONG
DUP 81.08 X 143
CORR TO: 81.08 X 132
PER PLAT 3/14 DEED FILED
4-13-71
DY. 10212
APPROVED
LORAIN CO.
MAP DEPT.
PAGE 6-120
BY CAROLYN
FRANCIS
#21727
21727-D
5-22-12
269-001
270
271-006
272-008
273
274
276
279
280-015
281-017
282
283-021
284
285
286
287
288
289
290-002
291-001
319-001
241
242-013
244-010
245
246-007
247-006
248-005
249-004
250-001
H. H
V. 2 P.
2-002