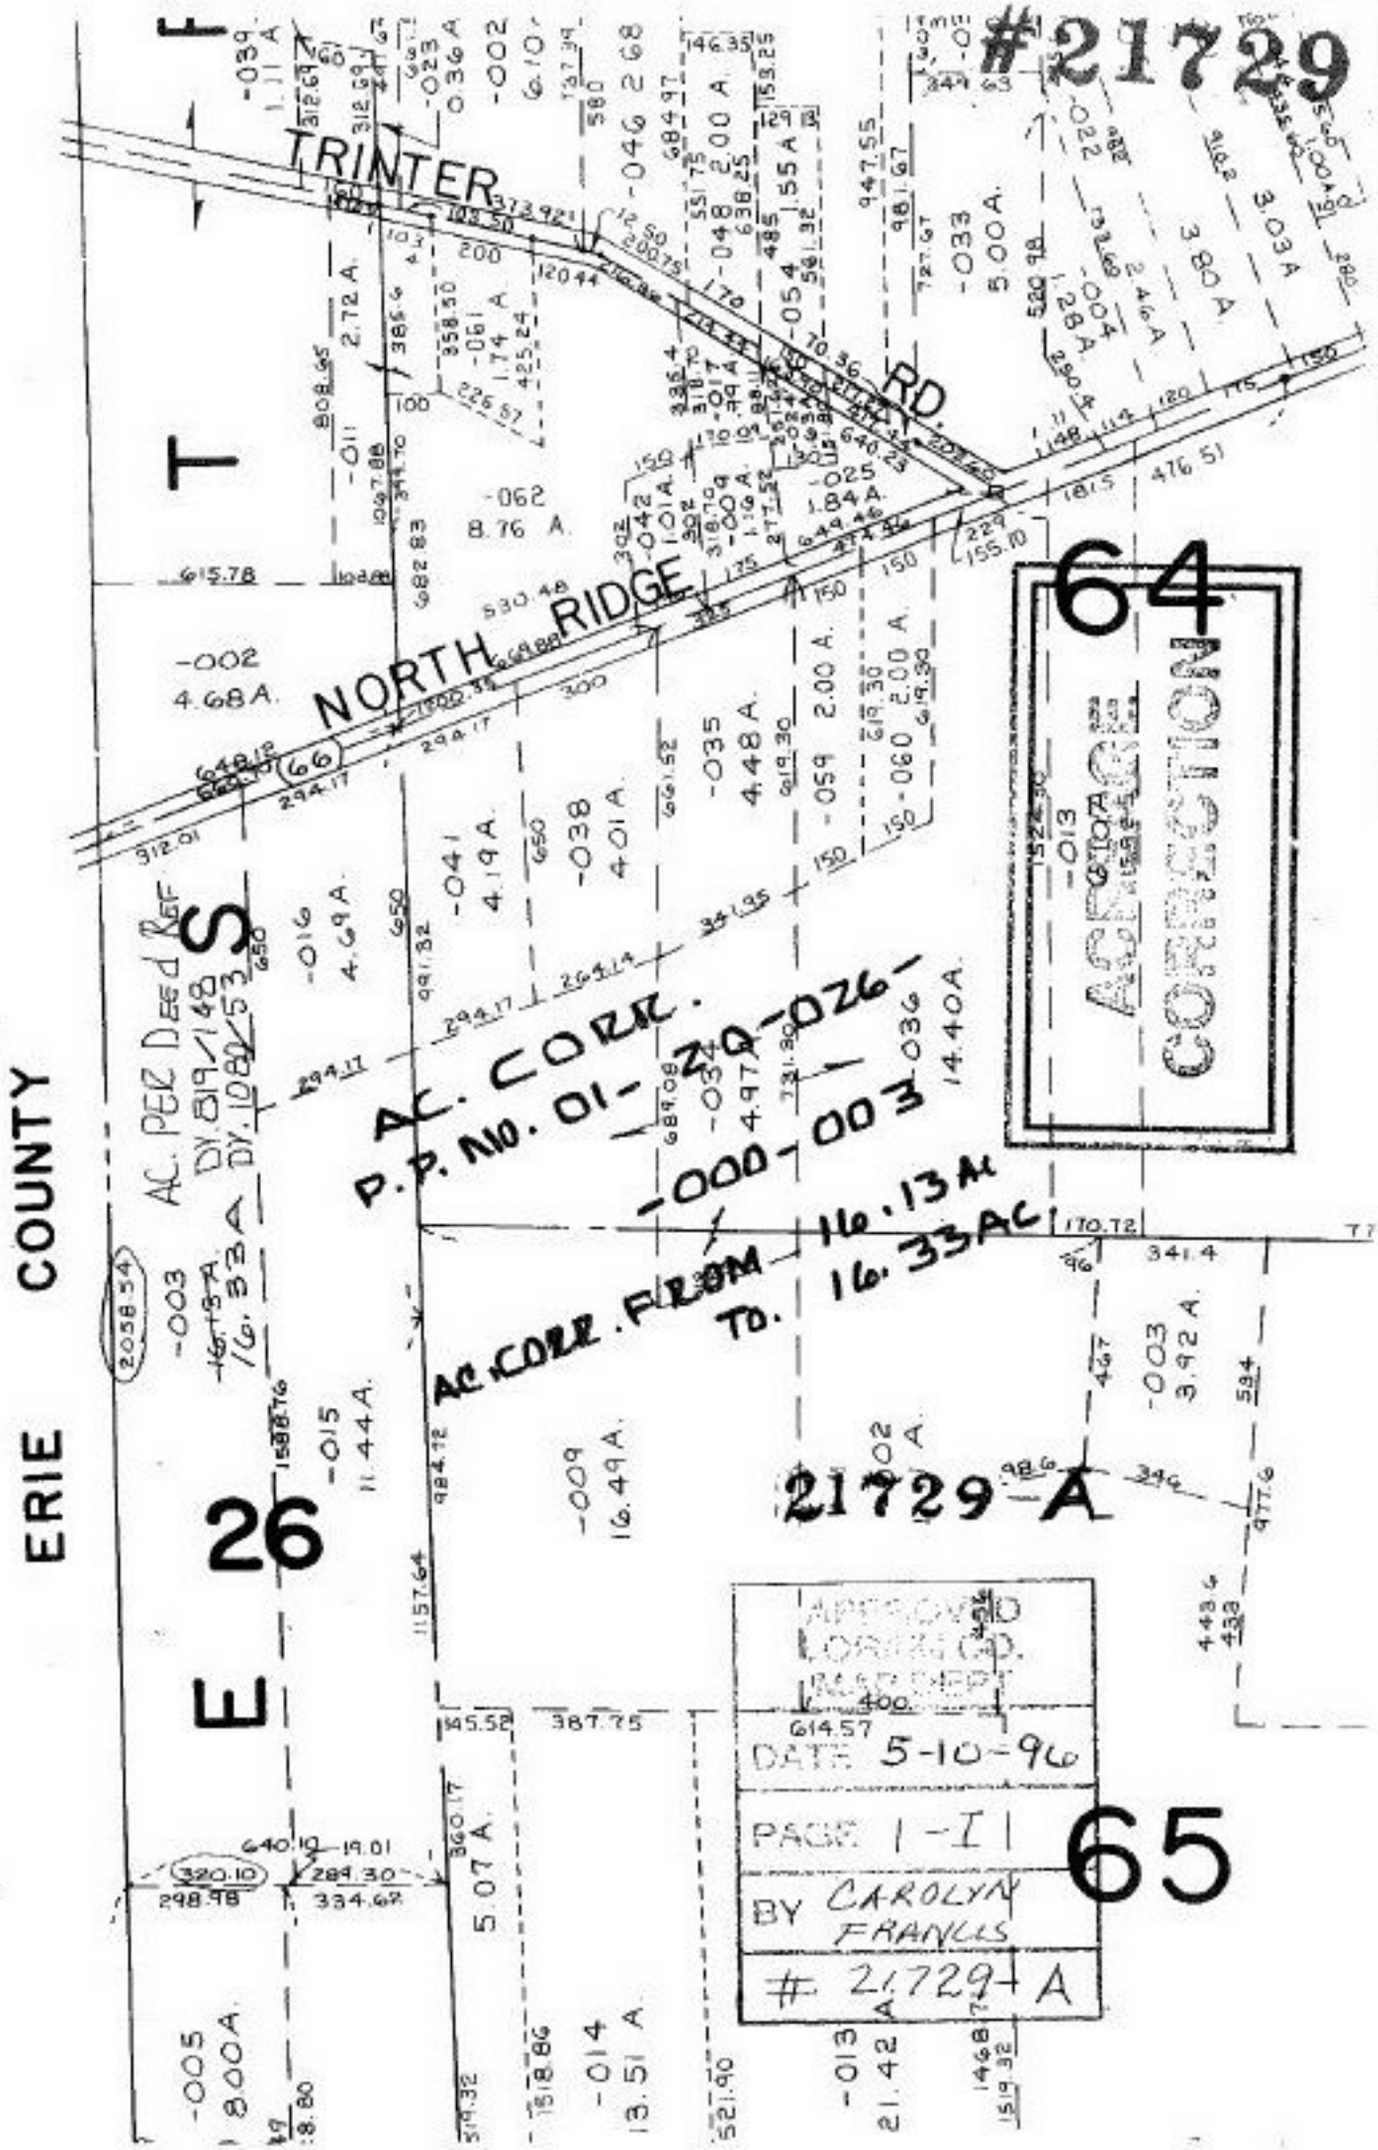
#21729
TRINTER RD.
NORTH RIDGE
ERIE COUNTY
64
65
26
21729-A
AC. CORR.
P.P. NO. 01-20-026-000-003
AC. CORR. FROM 16.13 AC TO 16.33 AC
AC. PER Deed Ref DY. 819/148 DY. 1080/53
ACREAGE CORRECTION
APPROVED LORAIN CO. MAP DEPT
DATE 5-10-96
PAGE 1-I
BY CAROLYN FRANCIS
21729-A