#21732-X
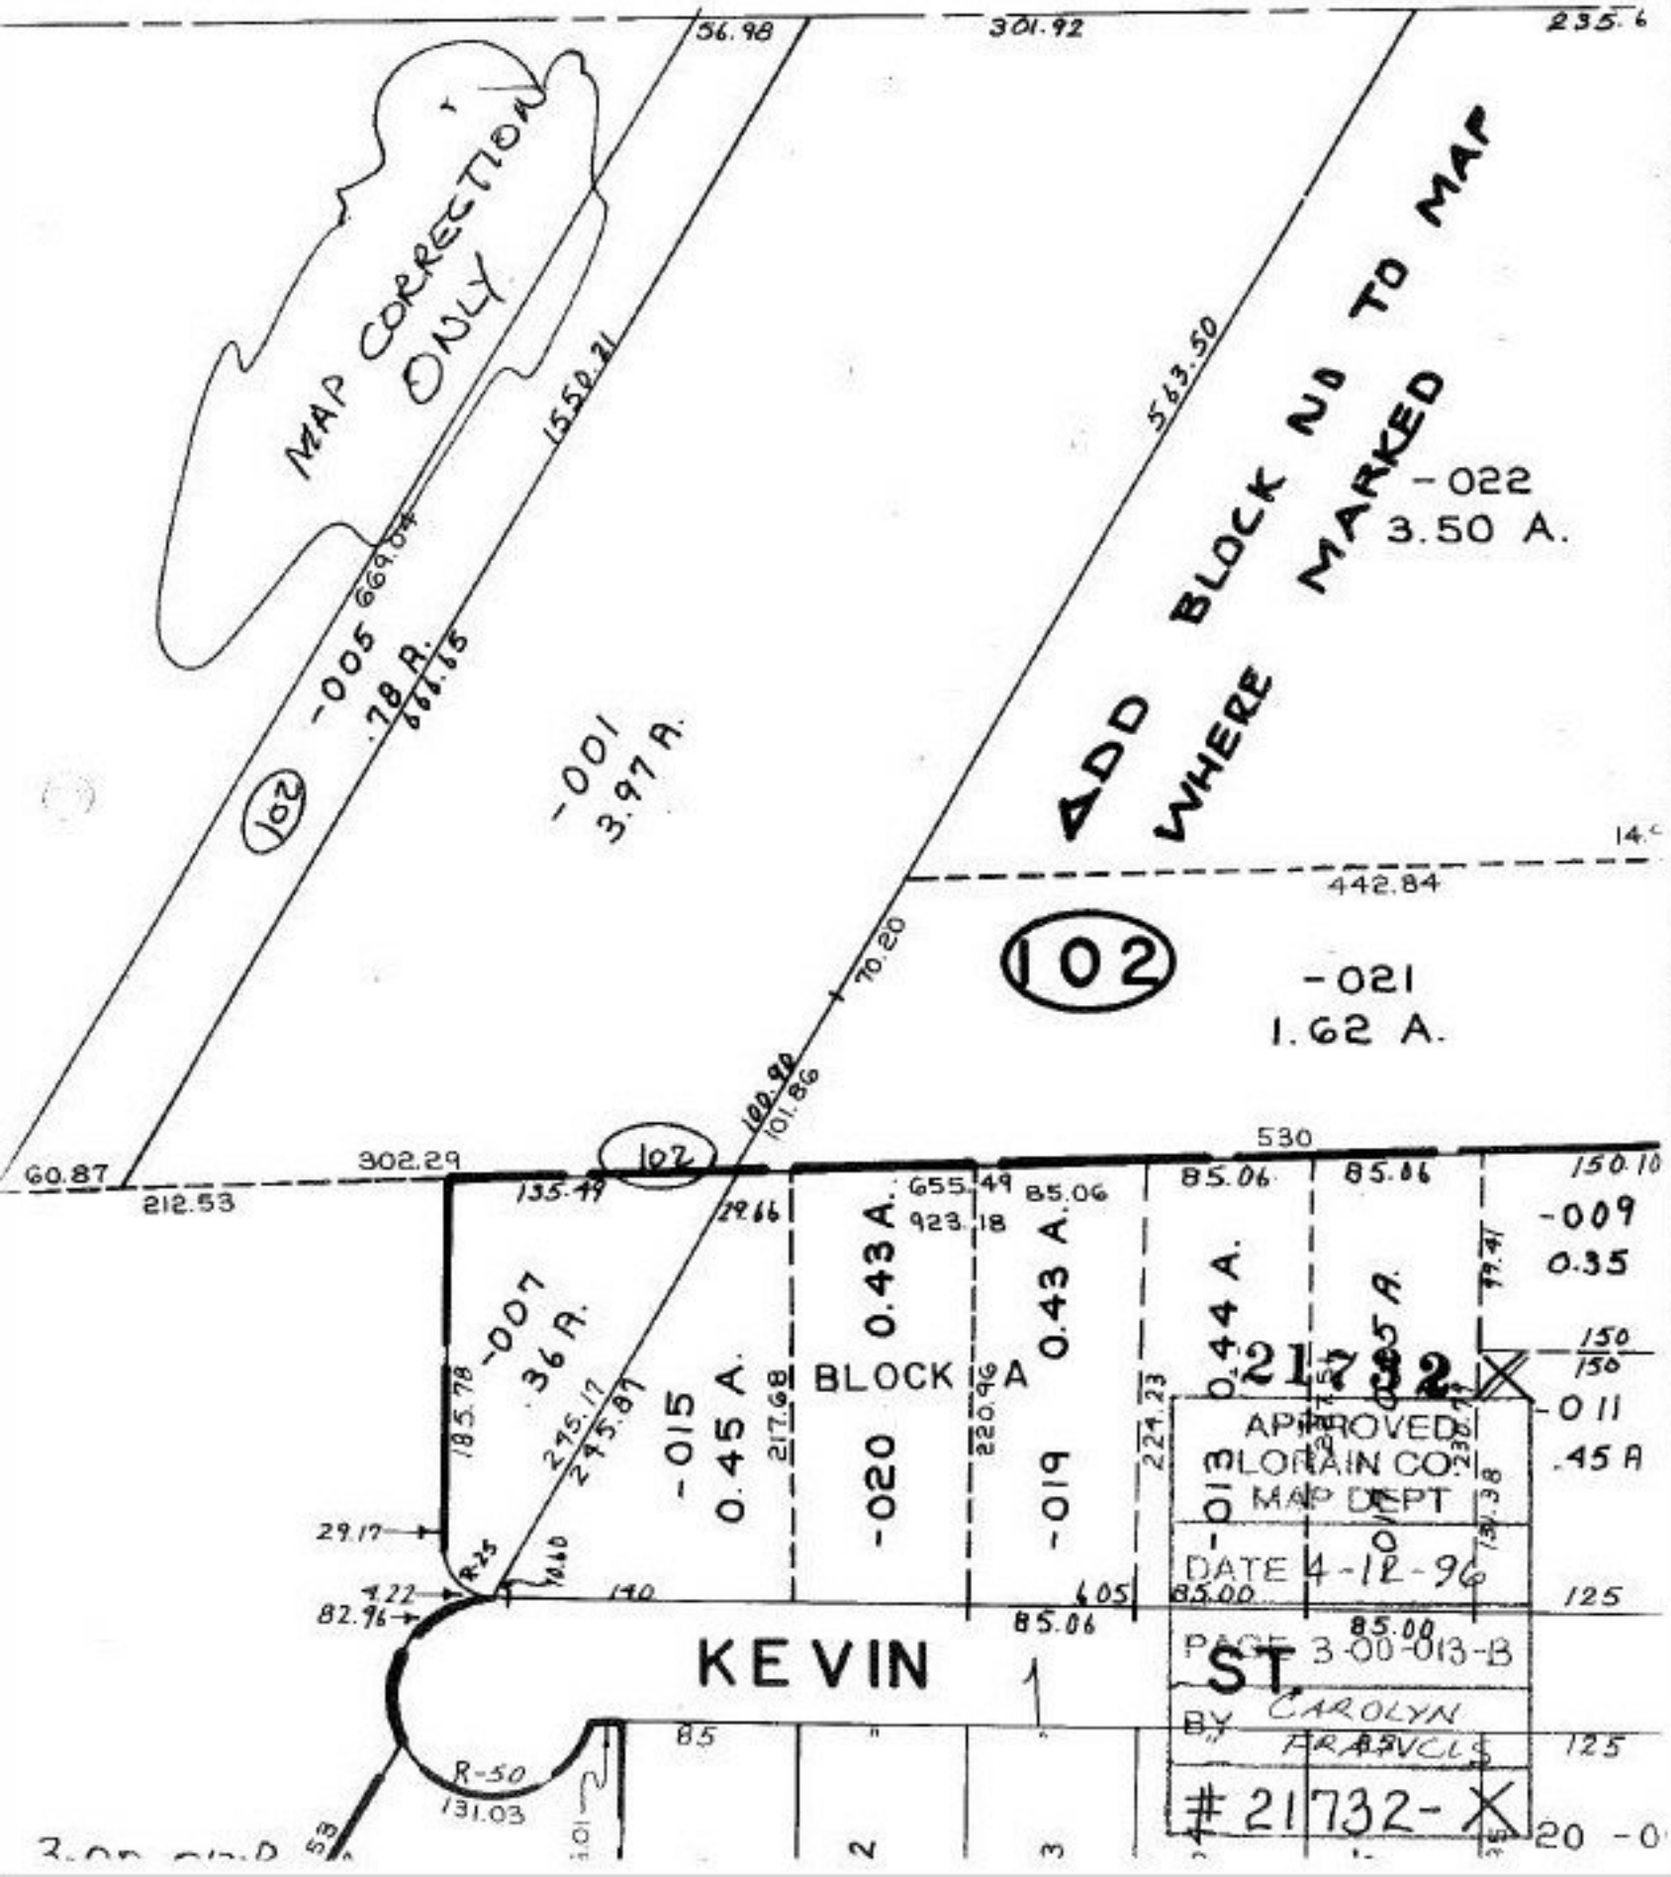
3 00-014-B