#21732

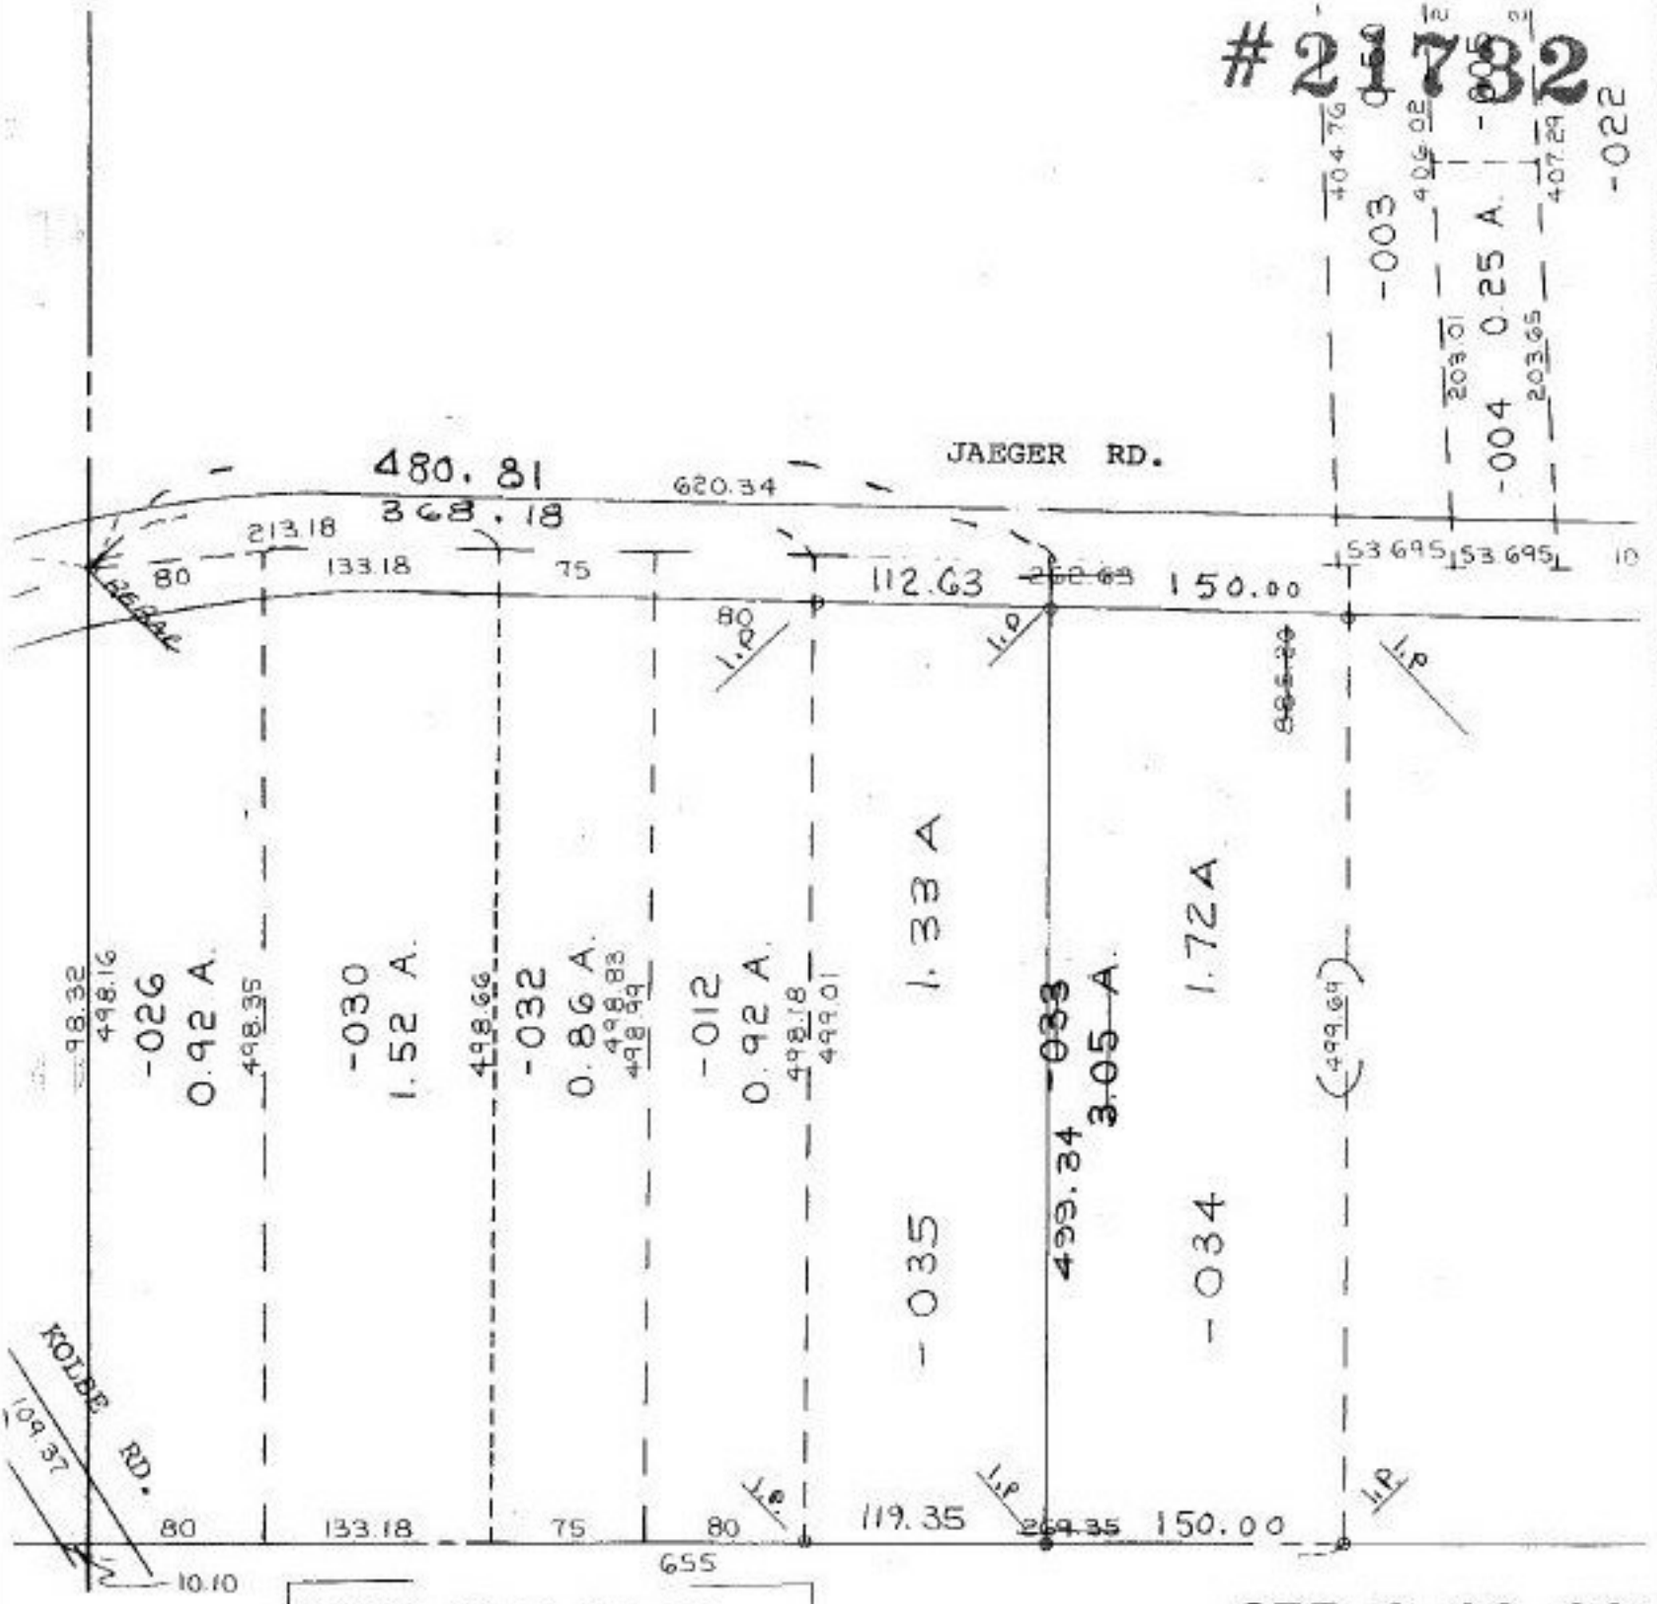

P.P.NO. 02-02-010-000
PRIOR INST: O.R. 1160/701
CLOSURE: 0.04:10,000
SURVEYED BY: DANE A HAPONEK
REG. SURVEYOR

SEE 2-02-001

21732
APPROVED
LORAIN CO.
MAP DEPT
DATE 4-12-96
PAGE 2-02-010A
BY CAROLYN FRANCIS

BLACK RIVE