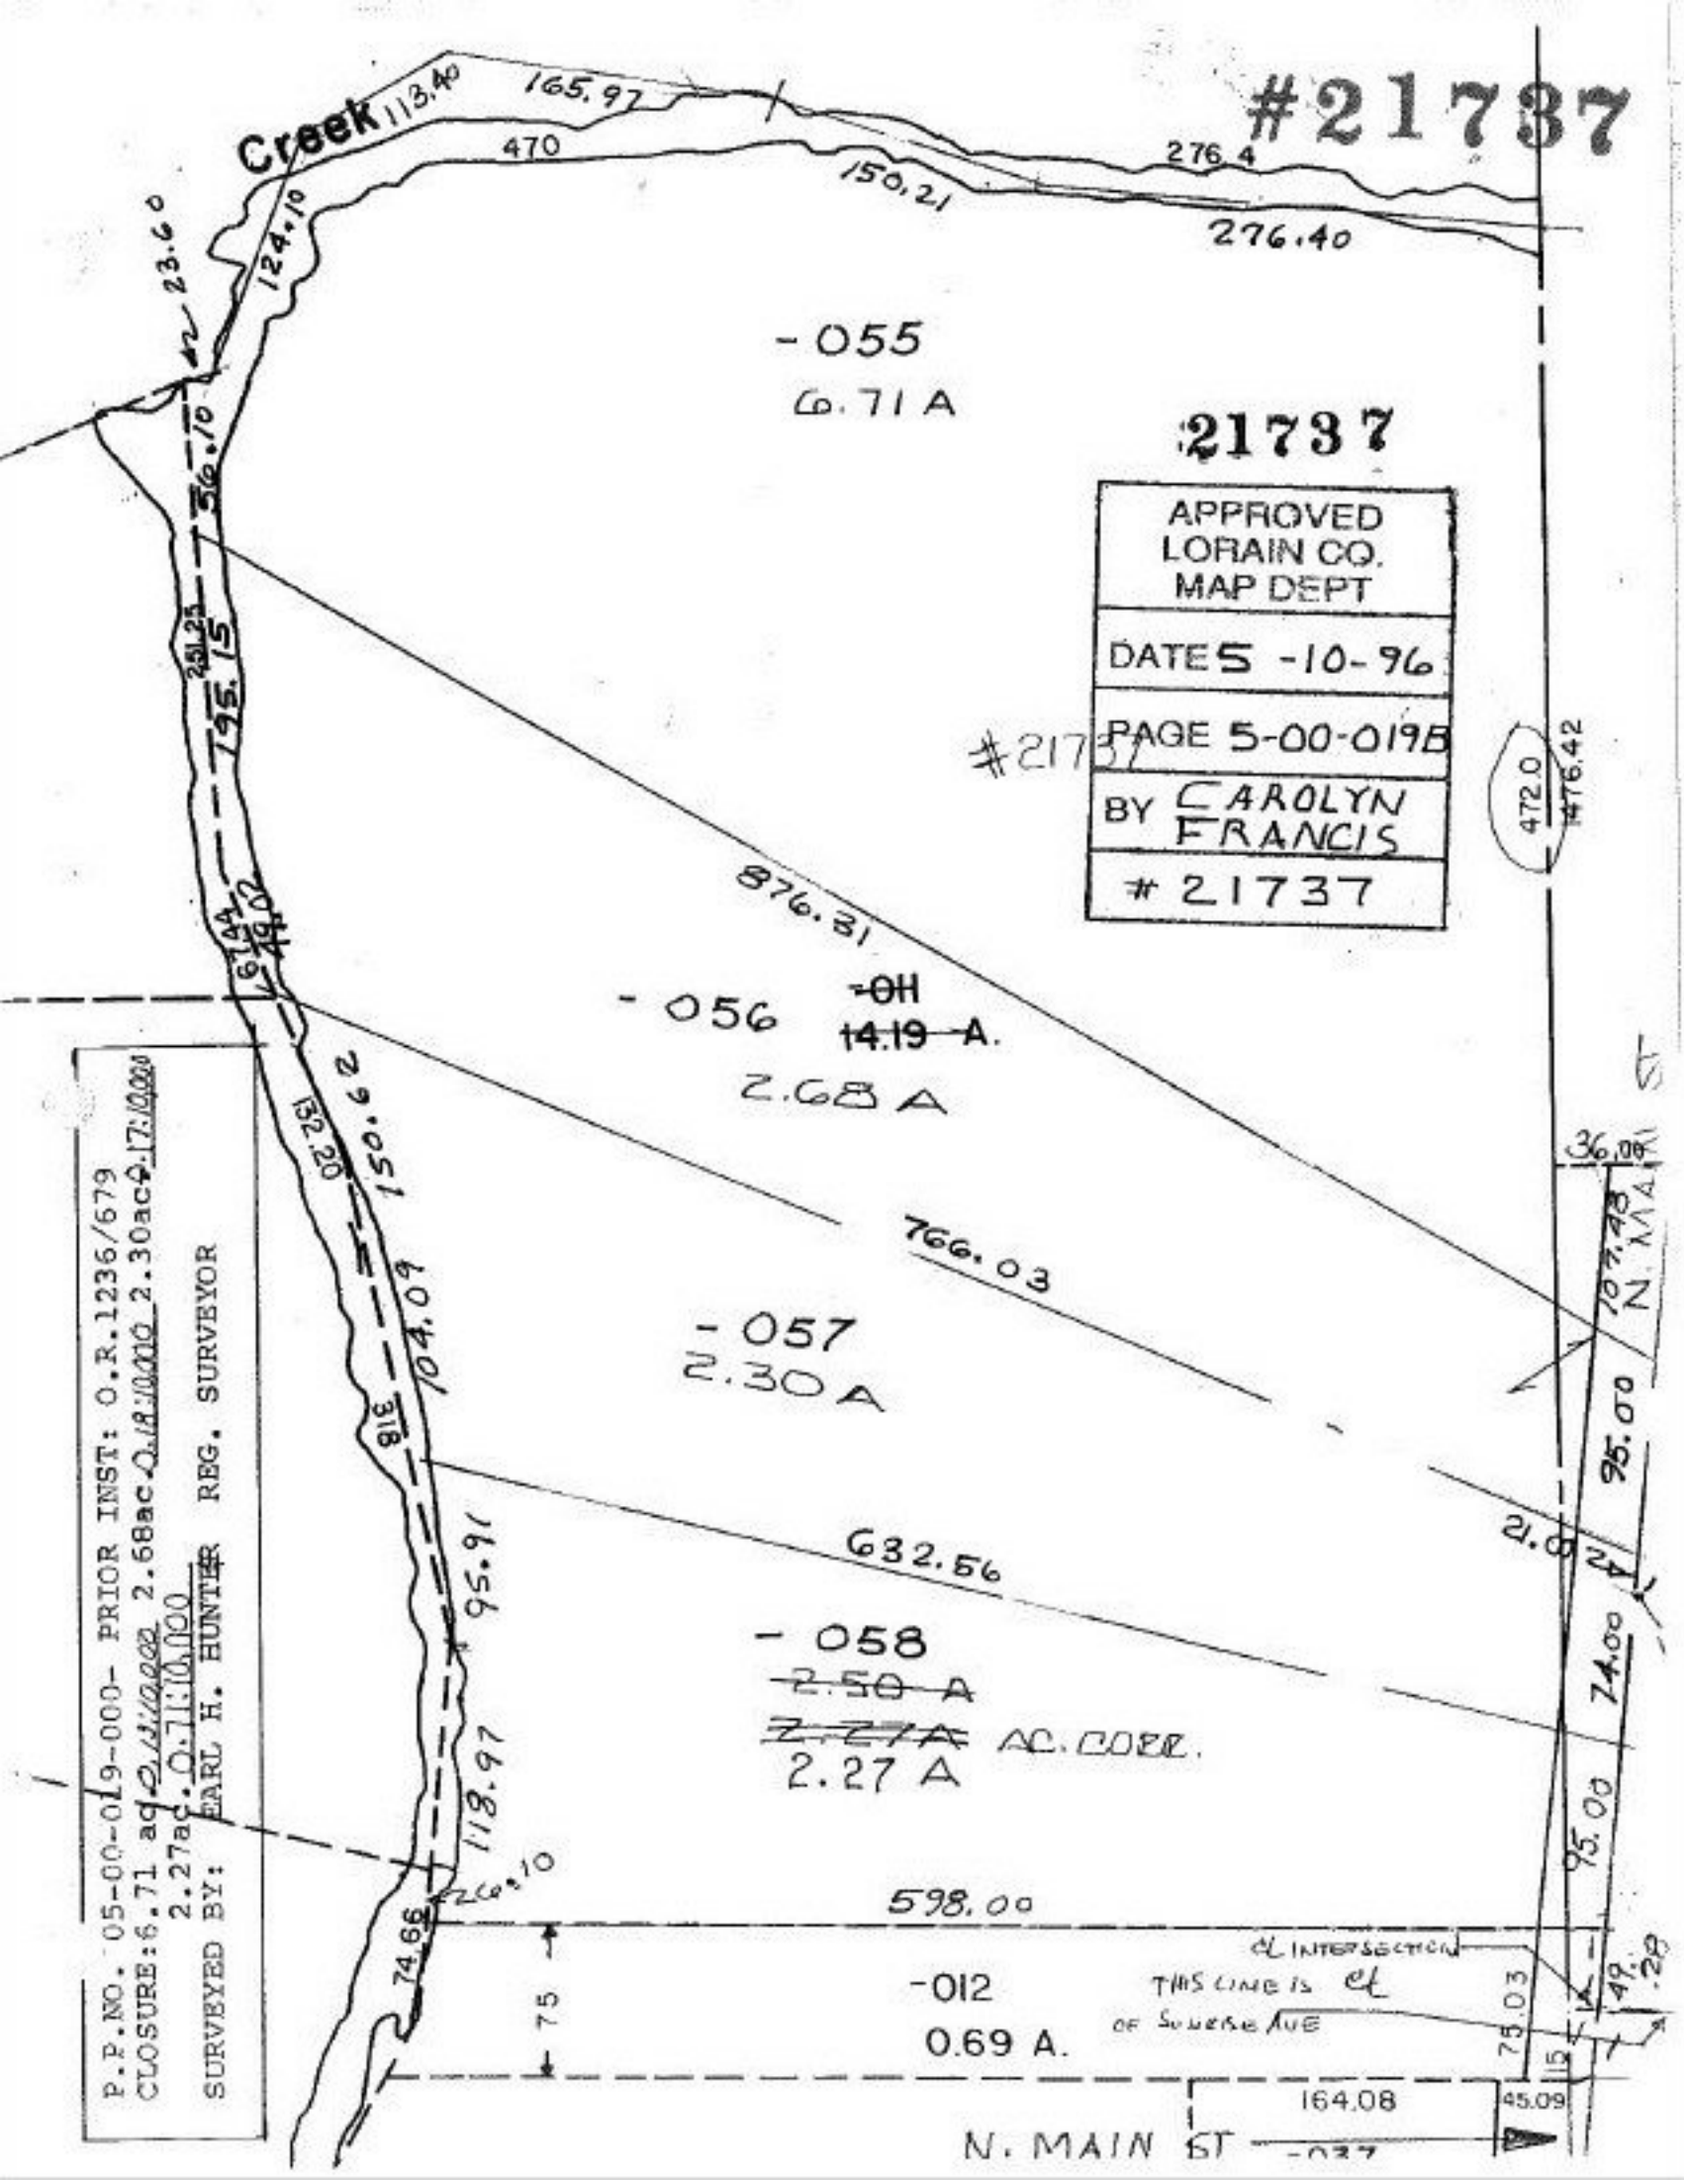
#21737
Creek
113.40
165.97
470
276.4
150.21
276.40
23.60
124.10
56.70
195.15
49.02
876.81
-055
6.71 A
21737
APPROVED
LORAIN CO.
MAP DEPT
DATE 5-10-96
PAGE 5-00-019B
BY CAROLYN FRANCIS
#21737
#21737
472.0
476.42
-056
2.68 A
766.03
-057
2.30 A
632.56
-058
2.27 A
AC. CORR.
598.00
-012
0.69 A.
164.08
45.09
N. MAIN ST
-037
N. MAIN
95.00
74.00
49.20
75.03
75
P.P.NO. 05-00-019-000- PRIOR INST: O.R.1236/679
CLOSURE:6.71 ac 2.68ac 2.30ac
2.27ac
SURVEYED BY: EARL H. HUNTER REG. SURVEYOR