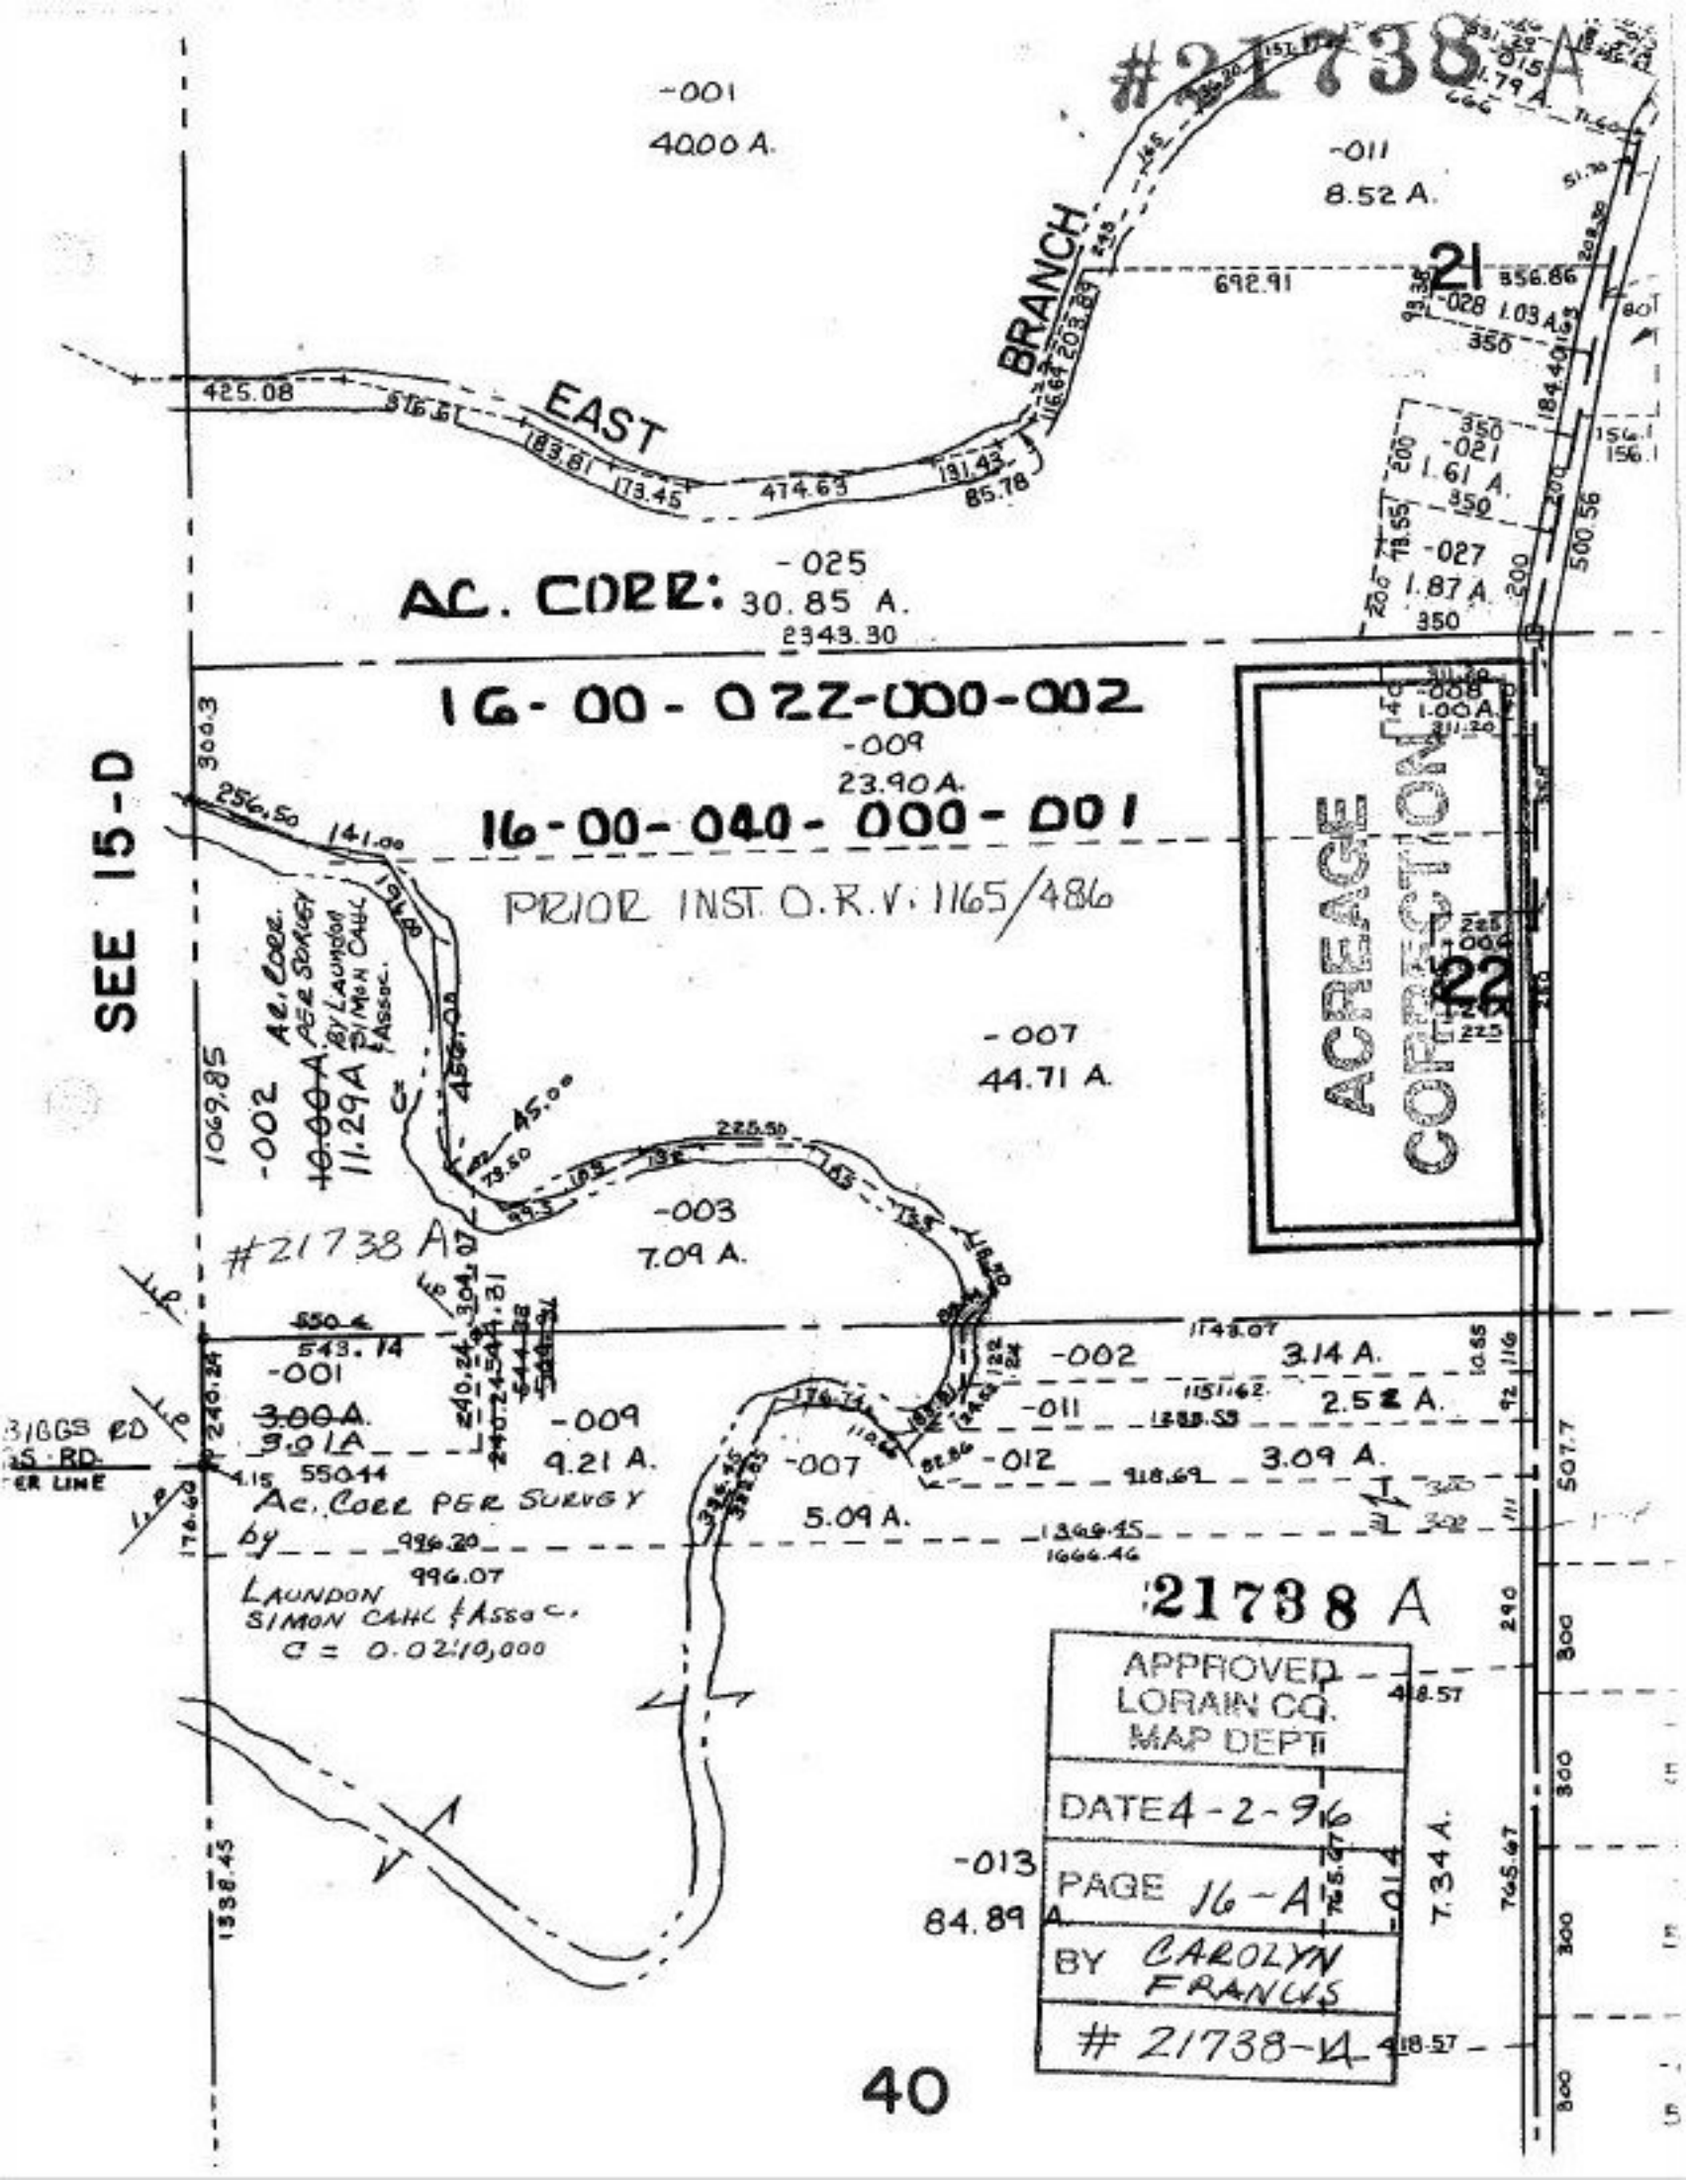
#21738 A
-001
40.00 A.
-011
8.52 A.
BRANCH
EAST
425.08
692.91
856.86
-028
1.03 A.
-021
1.61 A.
-027
1.87 A.
-025
AC. COR:
30.85 A.
2343.30
16-00-022-000-002
-009
23.90 A.
16-00-040-000-001
PRIOR INST. O.R.V: 1165/486
SEE 15-D
-008
1.00 A.
ACREAGE CORRECTION
22
-007
44.71 A.
-002
11.29 A
Ac. Corr. As Per Survey By Launder Simon Calhc & Assoc.
1069.85
-003
7.09 A.
#21738 A
-001
3.00 A.
3.01 A.
-009
9.21 A.
-002
3.14 A.
-011
2.52 A.
-012
3.09 A.
-007
5.09 A.
Ac. Corr per Survey by Launder Simon Calhc & Assoc.
C = 0.02/10,000
996.20
996.07
1338.45
#21738 A
APPROVED
LORAIN CO.
MAP DEPT
DATE 4-2-96
PAGE 16-A
BY CAROLYN FRANCIS
#21738-A
-013
84.89
7.34 A.
40