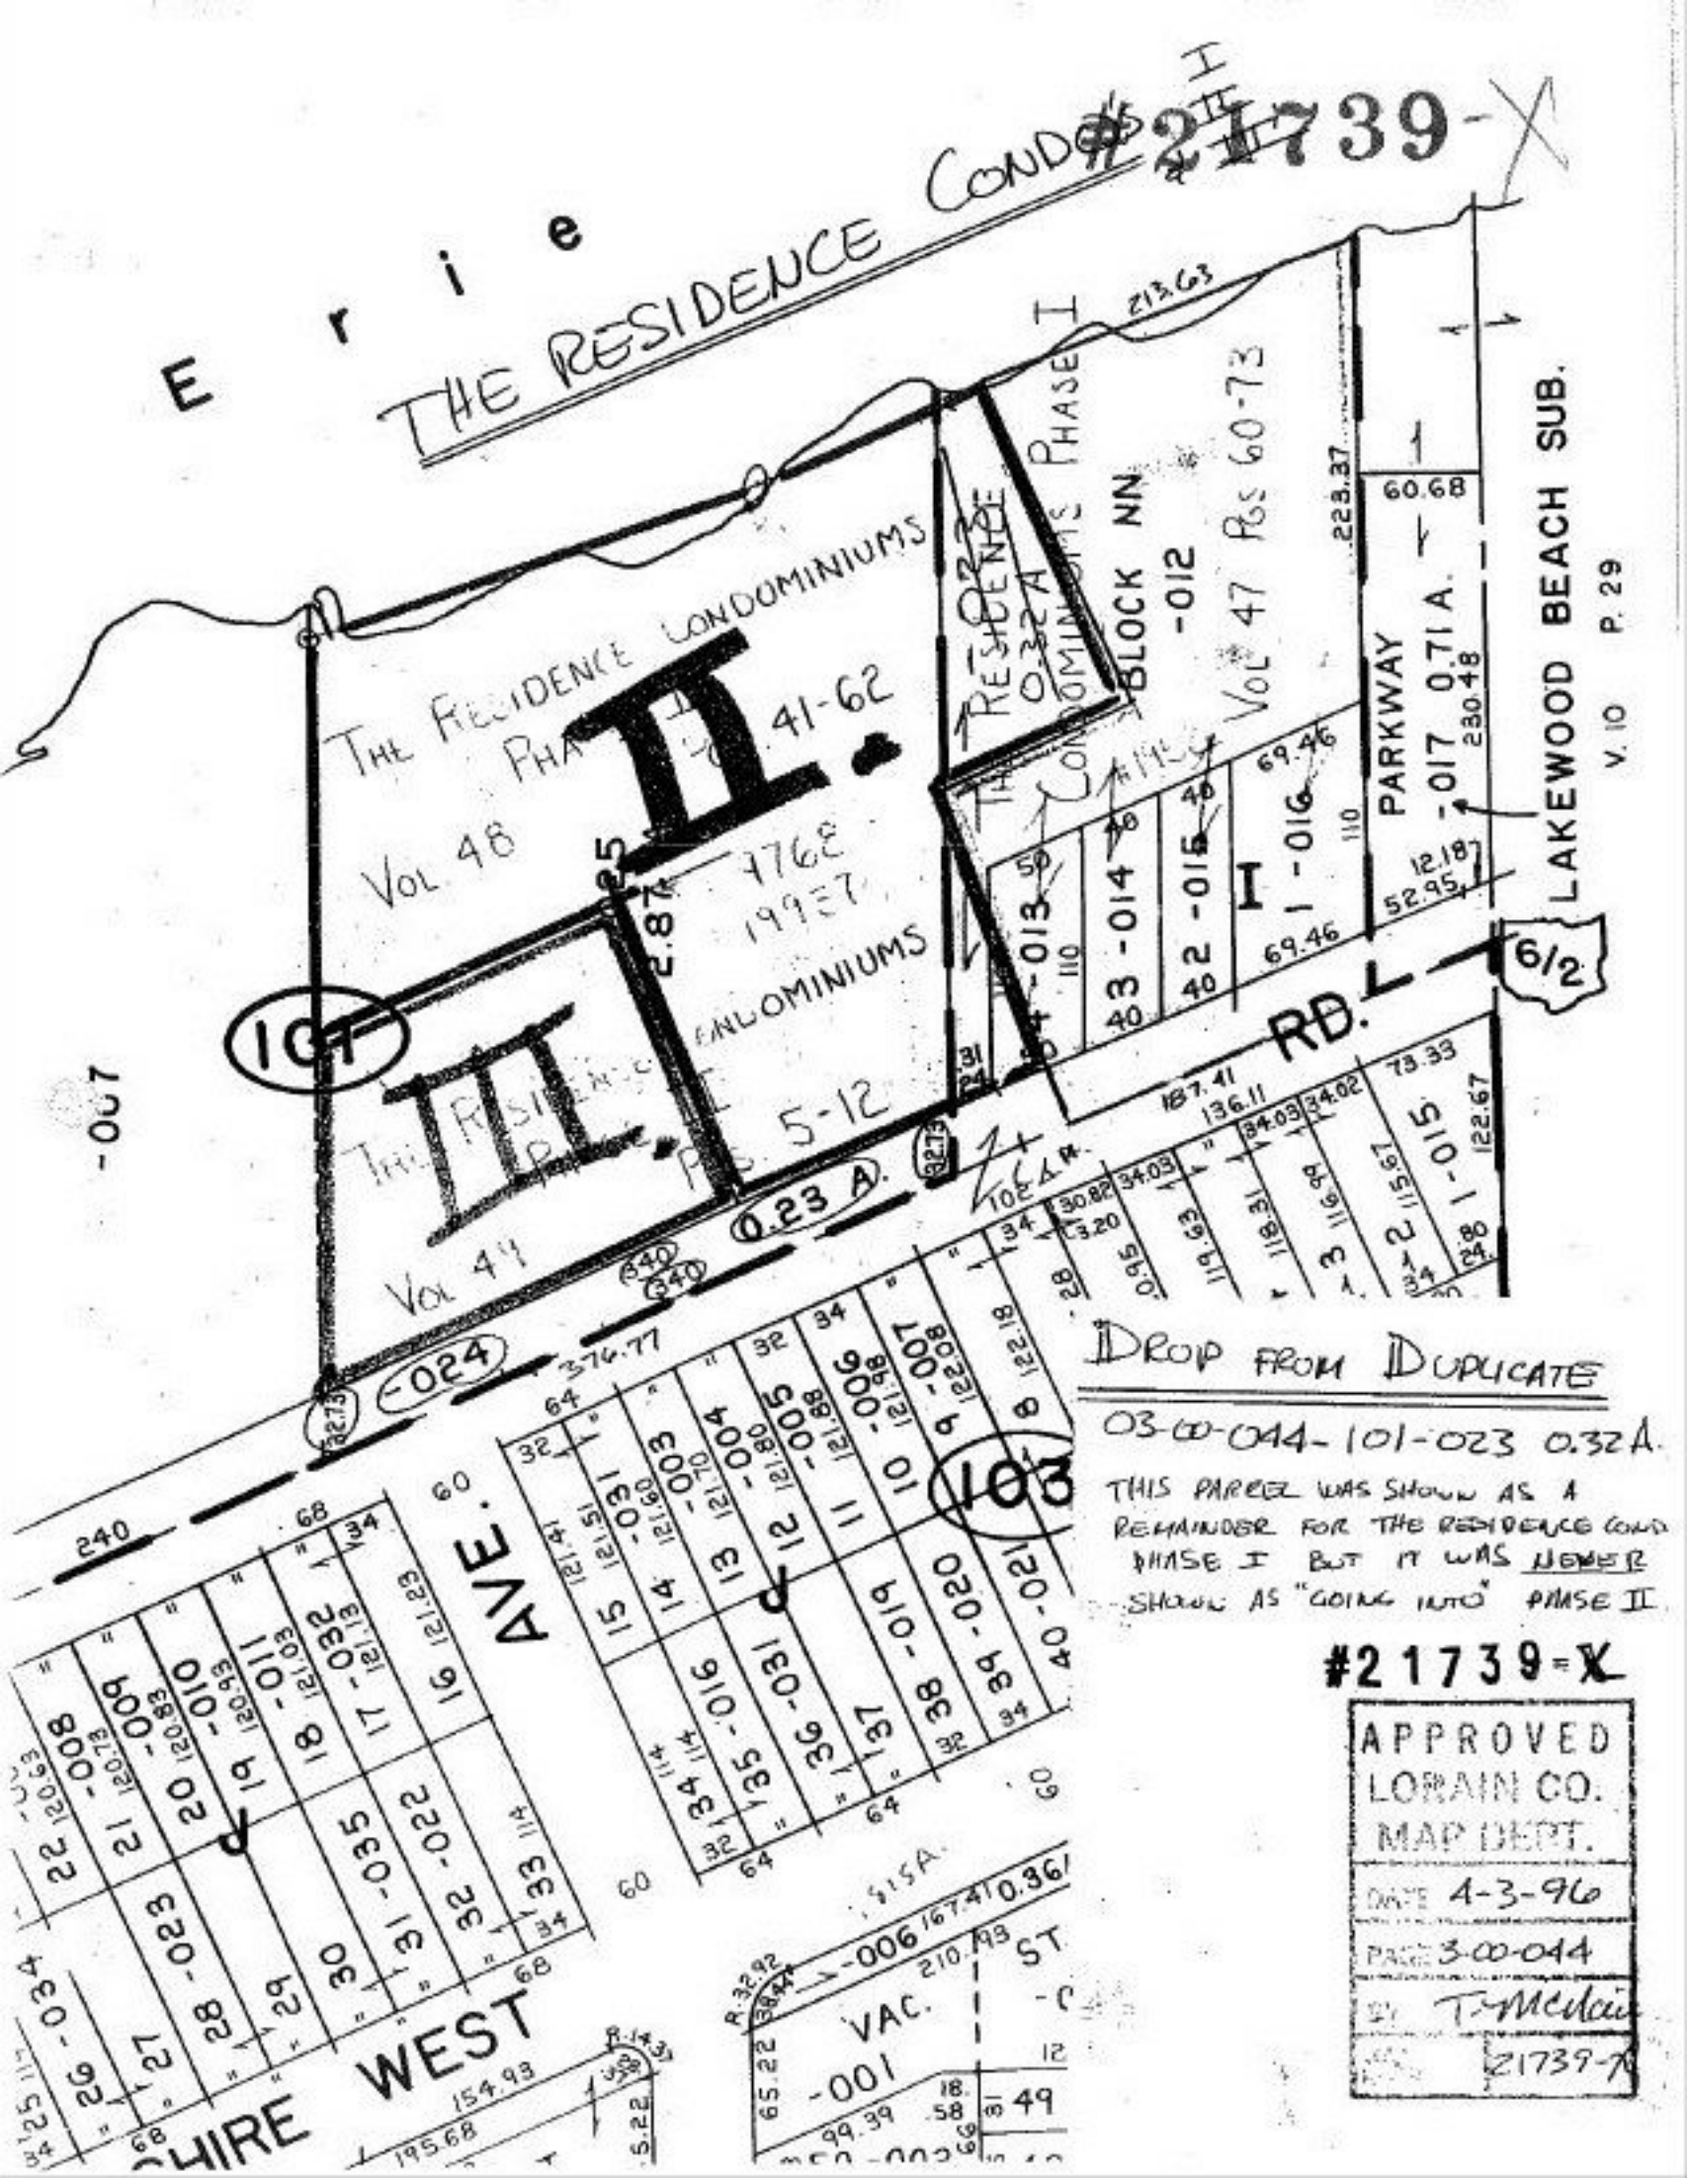


DROP FROM DUPLICATE

03-00-044-101-023 0.32A.

THIS PARCEL WAS SHOWN AS A REMAINDER FOR THE RESIDENCE COND PHASE I BUT IT WAS NEVER SHOWN AS "GOING INTO" PHASE II

#21739-X

APPROVED
LORAIN CO.
MAP DEPT.
DATE 4-3-96
PAGE 3-00-044
BY T. McClain
21739-X