#21743

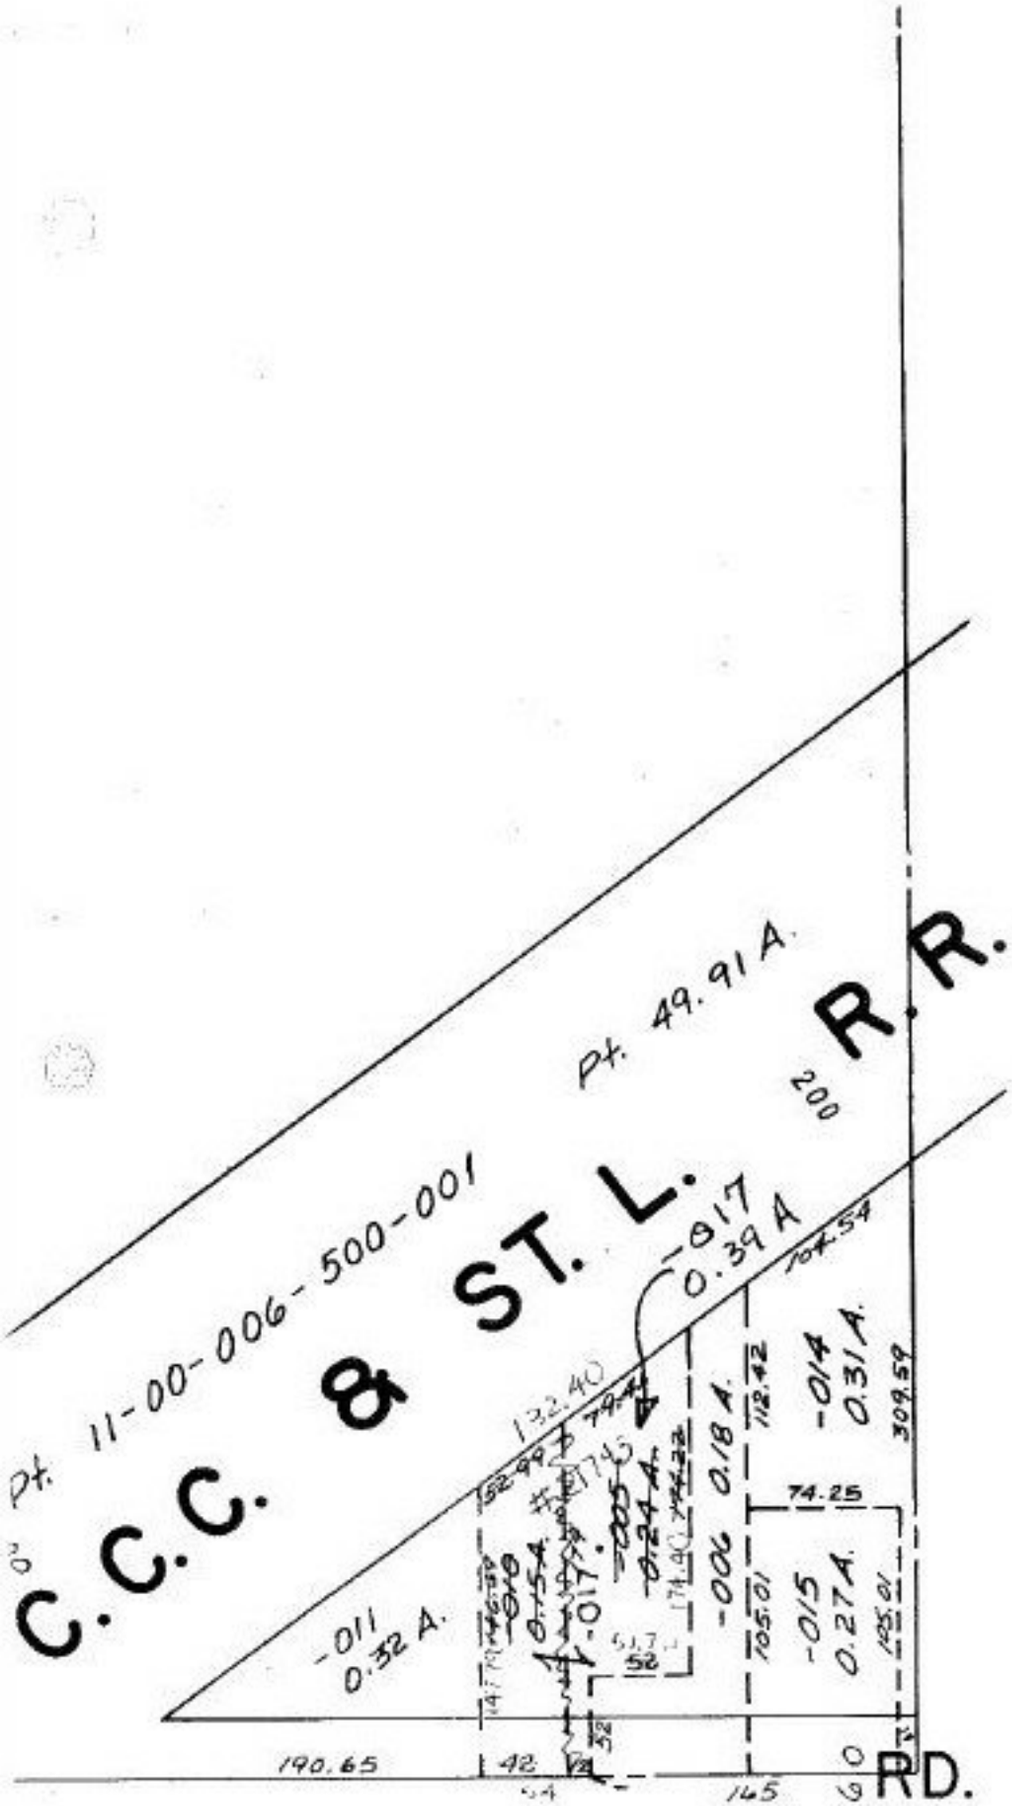

#21743

APPROVED
LORAIN CO.
MAP DEPT.
DATE 4-23-96
PAGE 11-00-015 B
BY K. DYE
J. HATFIELD
21743