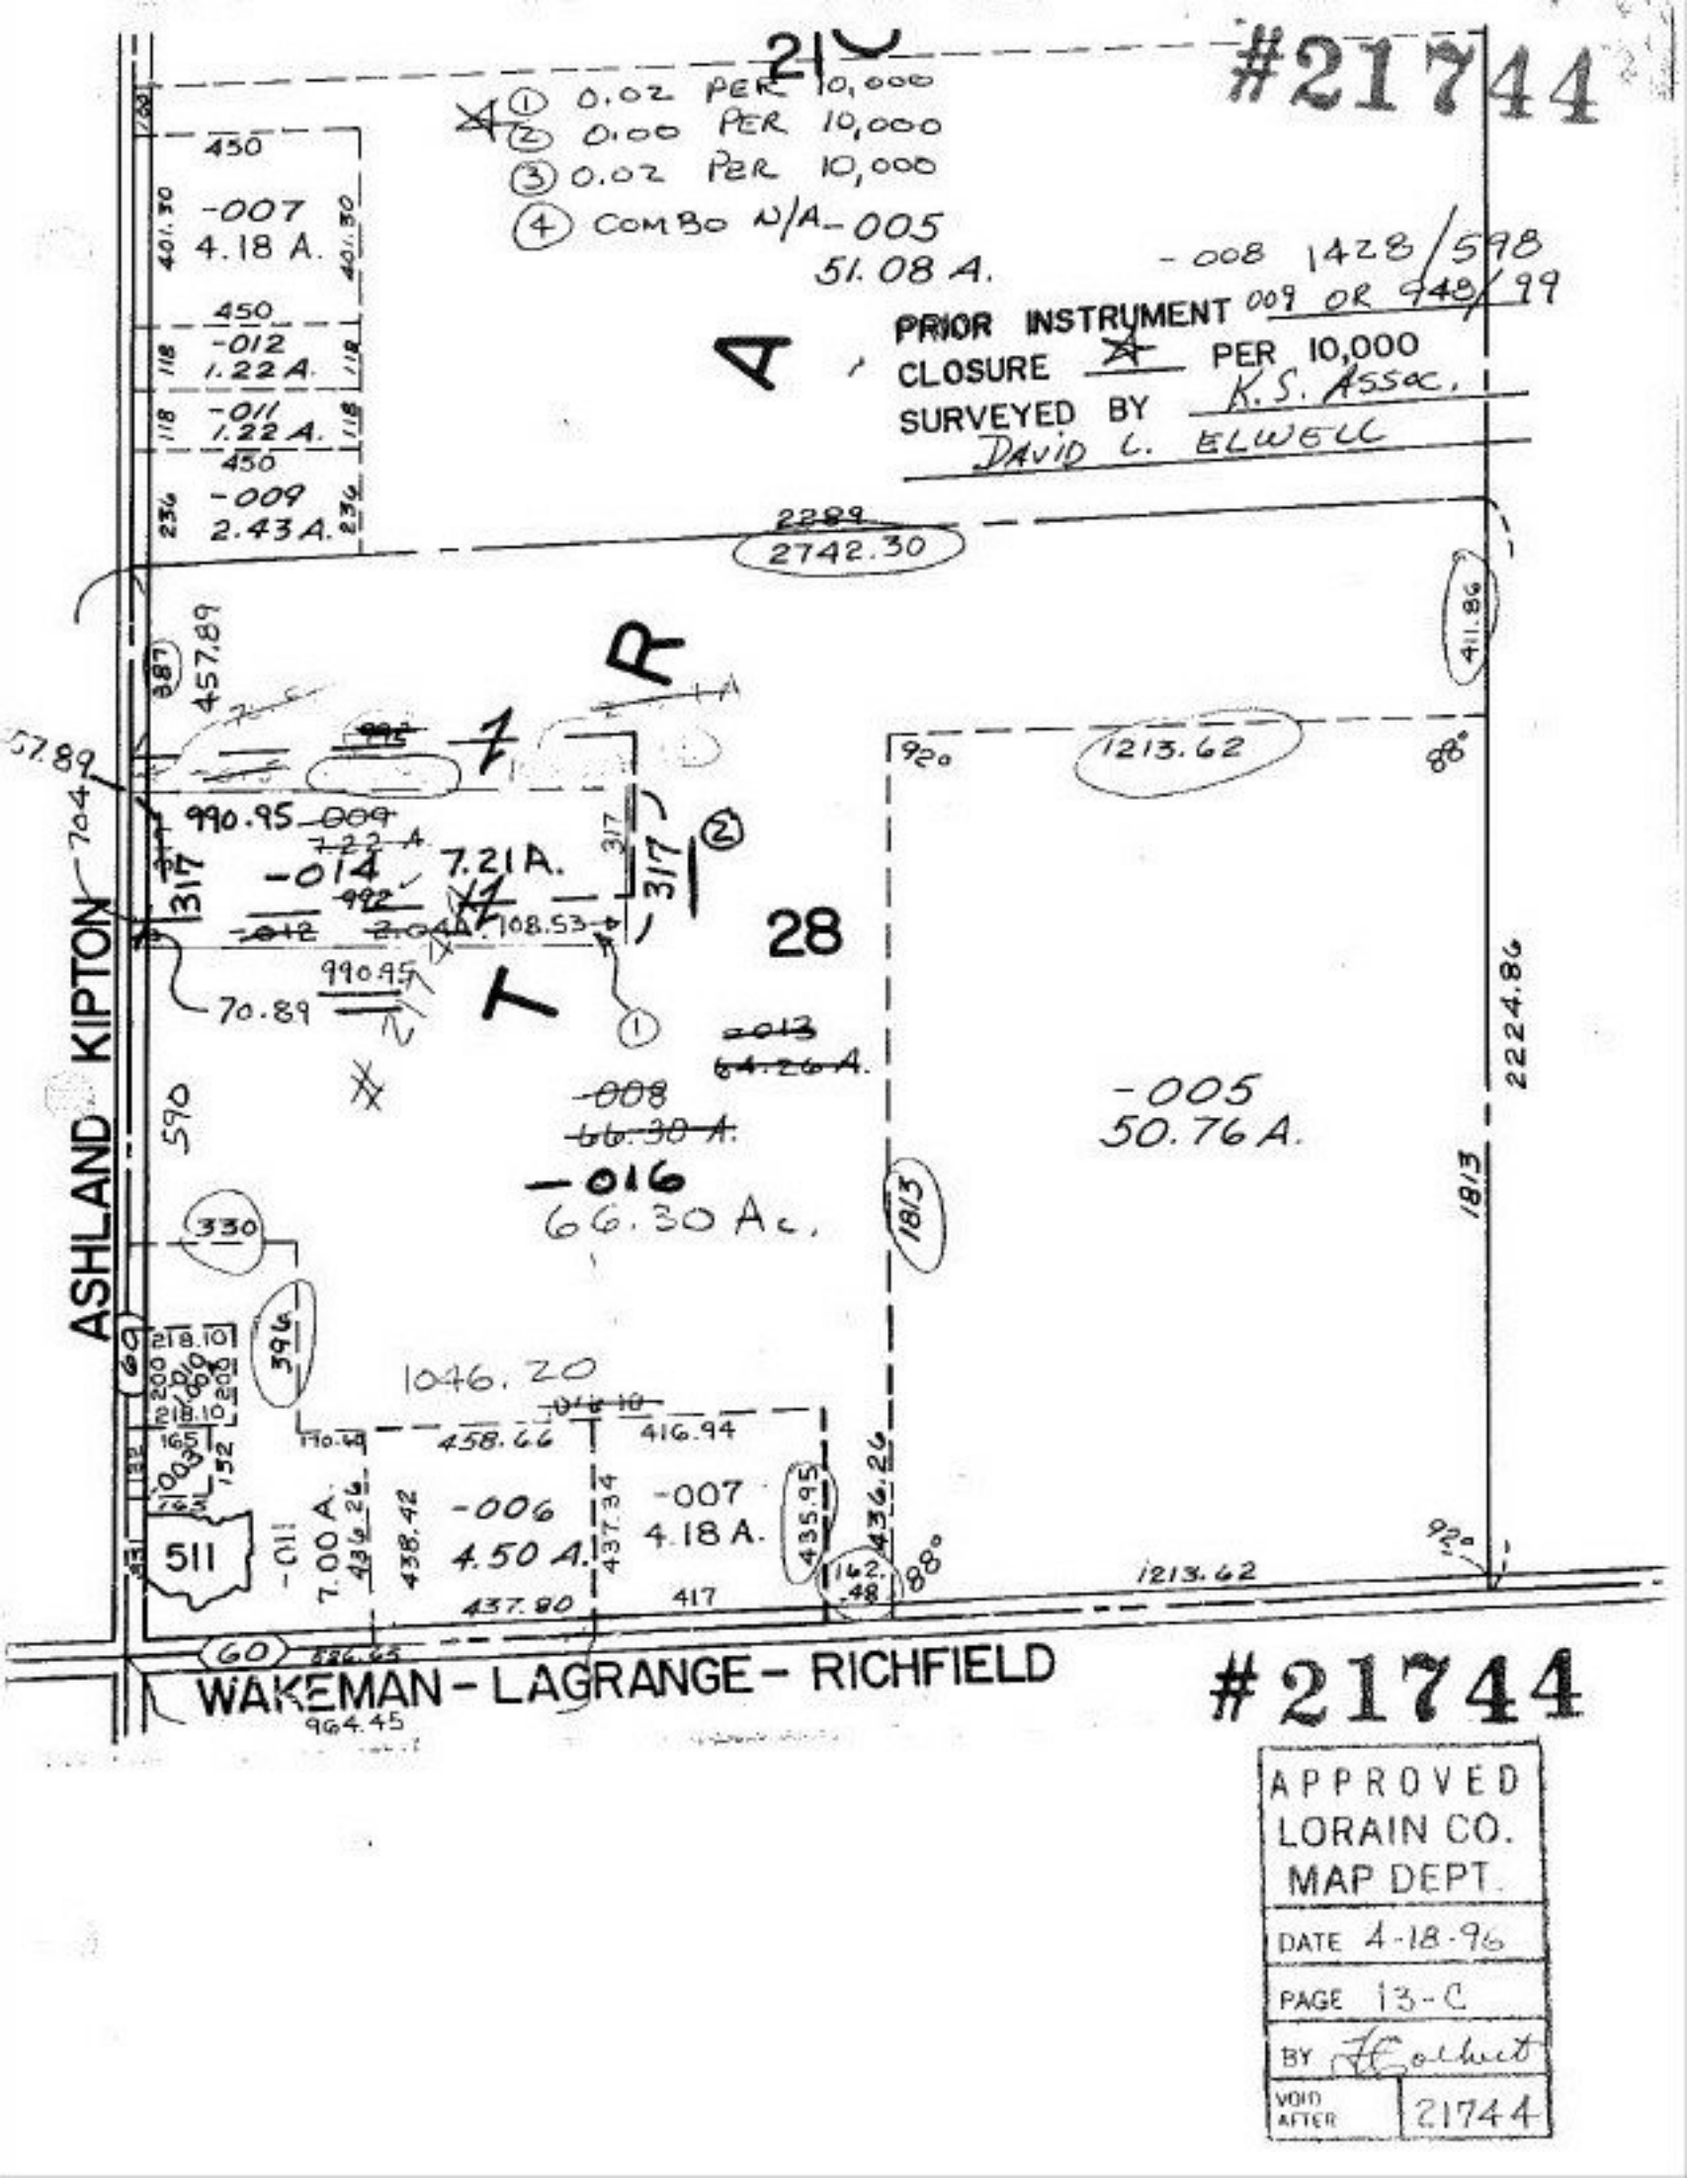
#21744
21C
① 0.02 PER 10,000
② 0.00 PER 10,000
③ 0.02 PER 10,000
④ COMBO N/A
-005
51.08 A.
-008 1428/598
PRIOR INSTRUMENT 009 OR 948/99
CLOSURE ☆ PER 10,000
SURVEYED BY K.S. Assoc.
DAVID L. ELWELL
A
R
T
28
-007
4.18 A.
-012
1.22 A.
-011
1.22 A.
-009
2.43 A.
-014
7.21 A.
-016
66.30 Ac.
-005
50.76 A.
-006
4.50 A.
-007
4.18 A.
-011
7.00 A.
ASHLAND KIPTON
WAKEMAN - LAGRANGE - RICHFIELD
2742.30
1213.62
2224.86
1813
1046.20
990.95
457.89
436.26
964.45
#21744
APPROVED
LORAIN CO.
MAP DEPT.
DATE 4-18-96
PAGE 13-C
BY
VOID AFTER 21744