#21748

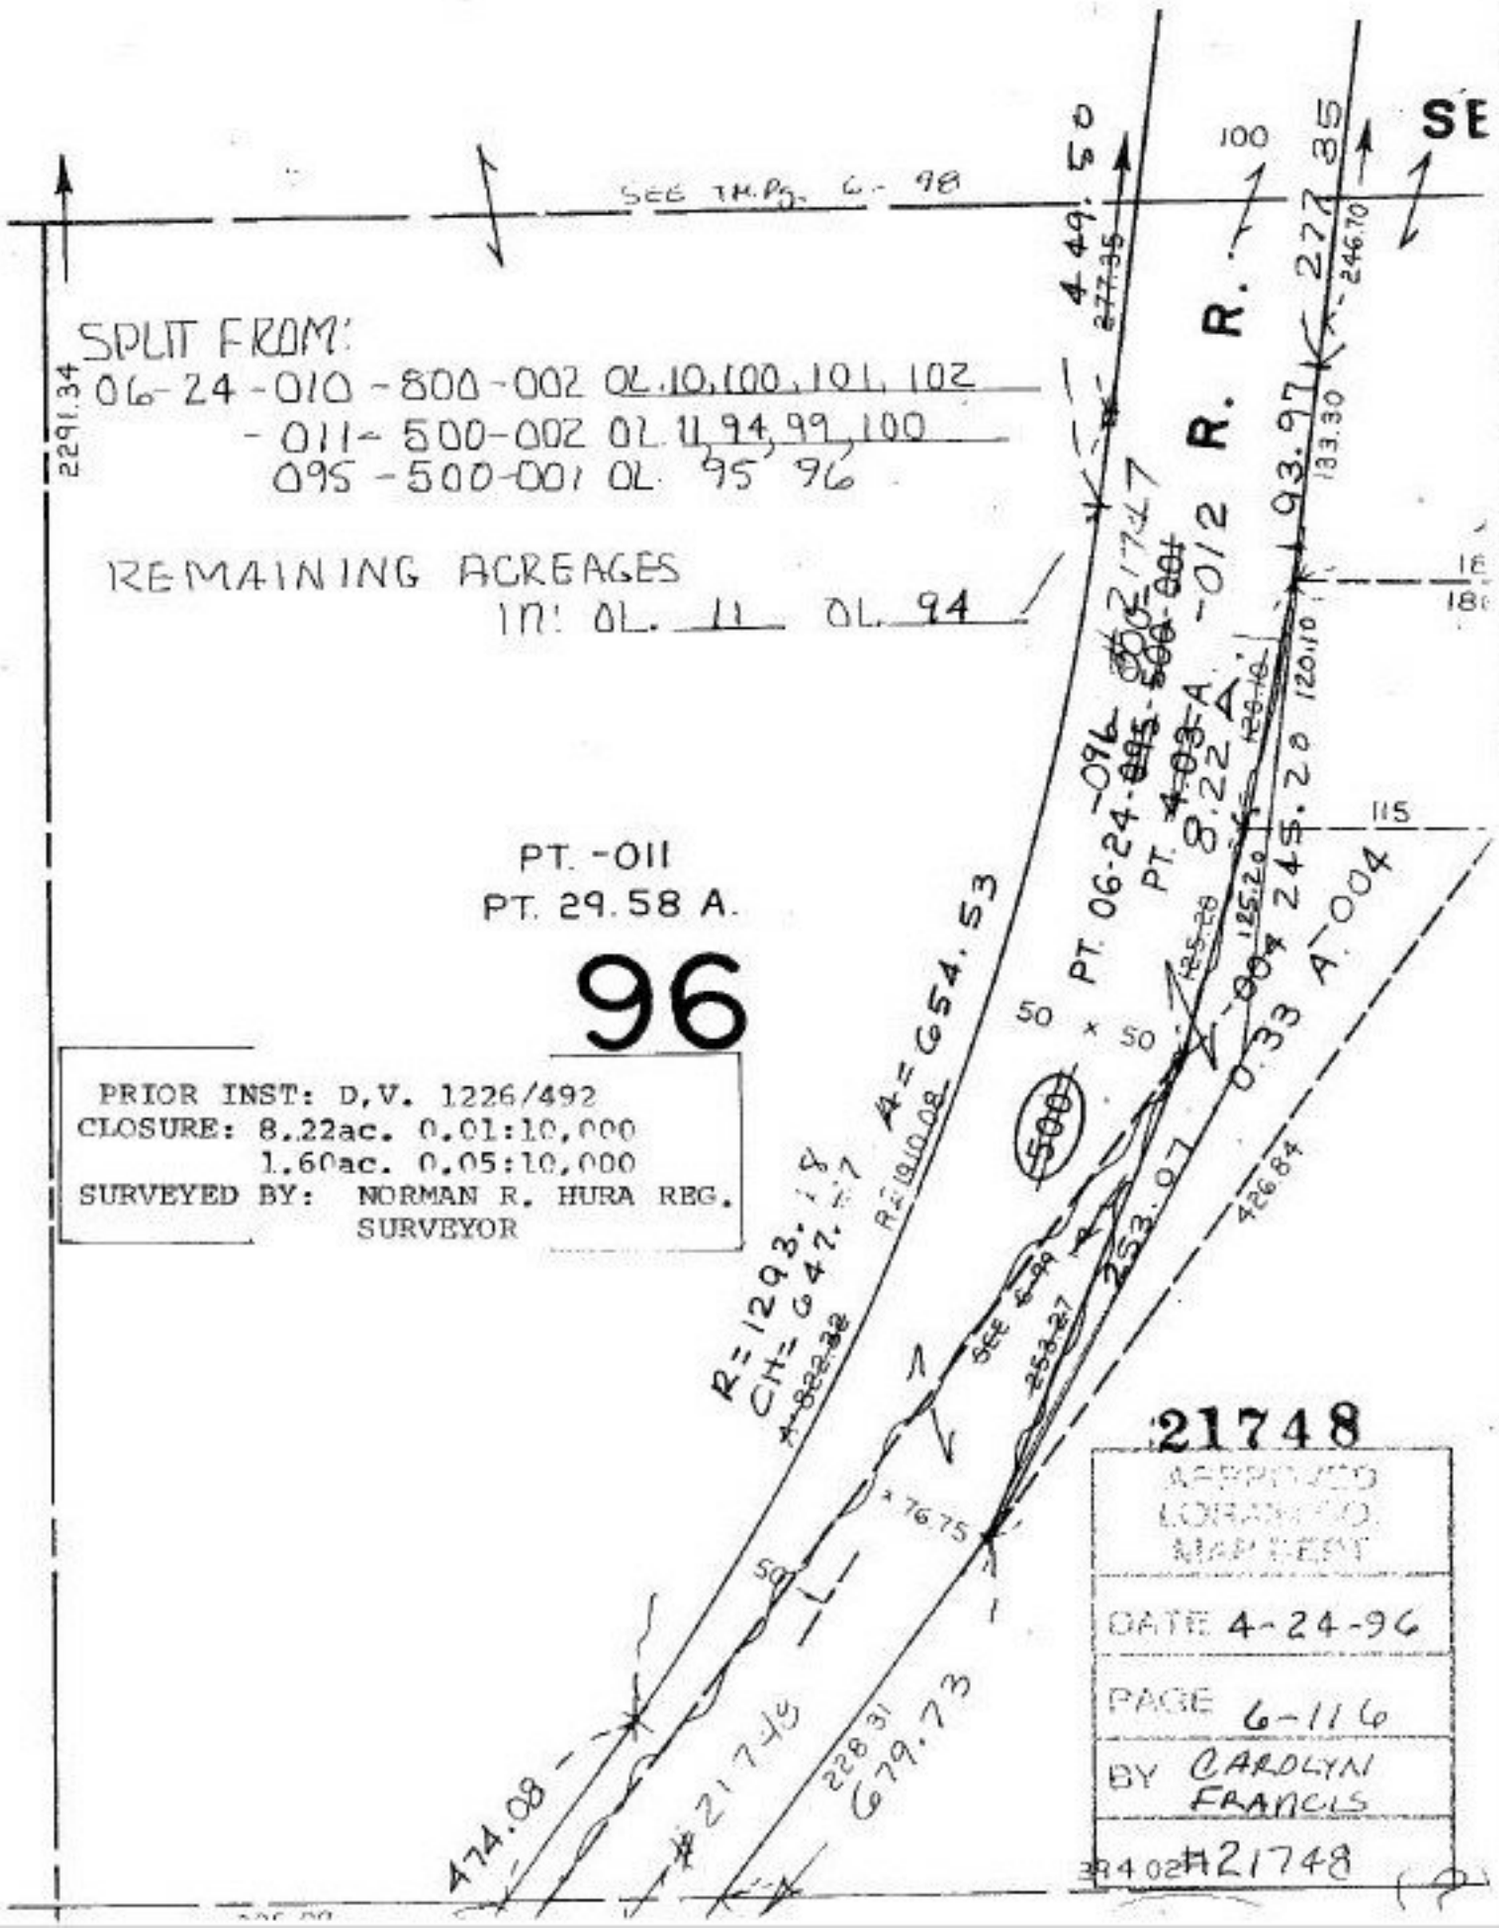
SEE THIS PG. 6-98
SPLIT FROM:
06-24-010-800-002 OL. 10, 100, 101, 102
-011-500-002 OL. 11, 94, 99, 100
095-500-001 OL. 95 96
REMAINING ACREAGES
IN: OL. 11 OL. 94
PT. -011
PT. 29.58 A.
96
PRIOR INST: D,V. 1226/492
CLOSURE: 8.22ac. 0.01:10,000
1.60ac. 0.05:10,000
SURVEYED BY: NORMAN R. HURA REG. SURVEYOR
PT. 06-24-095-500-096
PT. 8.22 A.
-012
-004
A=654.53
R=1293.18
CH=647.17
253.07
245.20
120.10
133.30
277.35
449.50
227.35
246.70
93.97
2291.34
474.08
679.73
228.31
426.84
253.27
125.20
120.10
50 x 50
x 76.75
SEE 6-99
SE
100
115
0.33 A.
004
21748
APPROVED
MAP ENT.
DATE 4-24-96
PAGE 6-116
BY CAROLYN FRANCIS
394021748