#21748

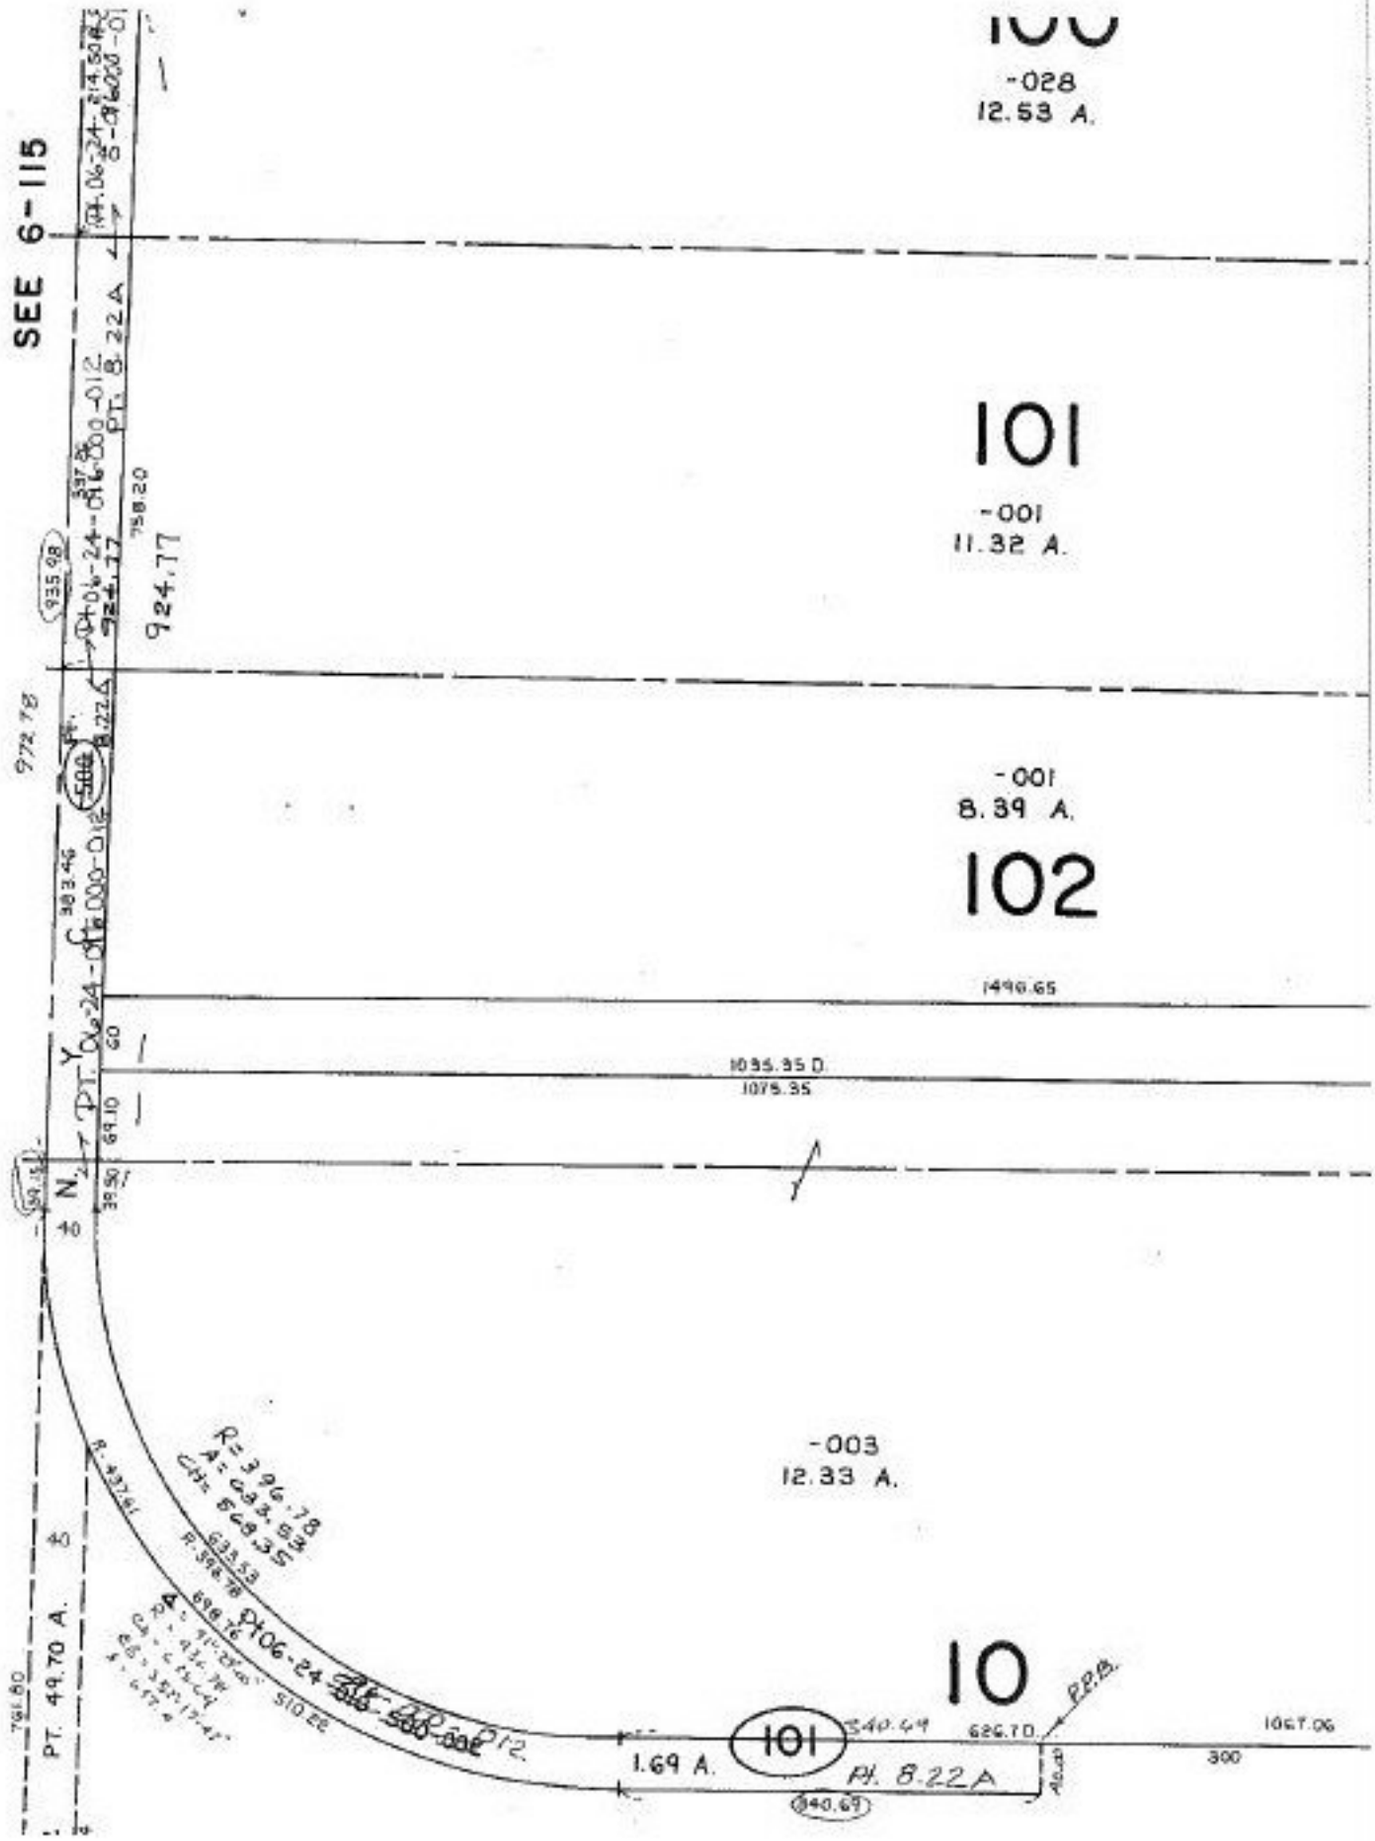

SEE 6-115
100
-028
12.53 A.
101
-001
11.32 A.
924.77
-001
8.39 A.
102
1490.65
1035.35 D.
1075.35
-003
12.33 A.
10
101
1.69 A.
Pt. 8.22 A
PT. 49.70 A.