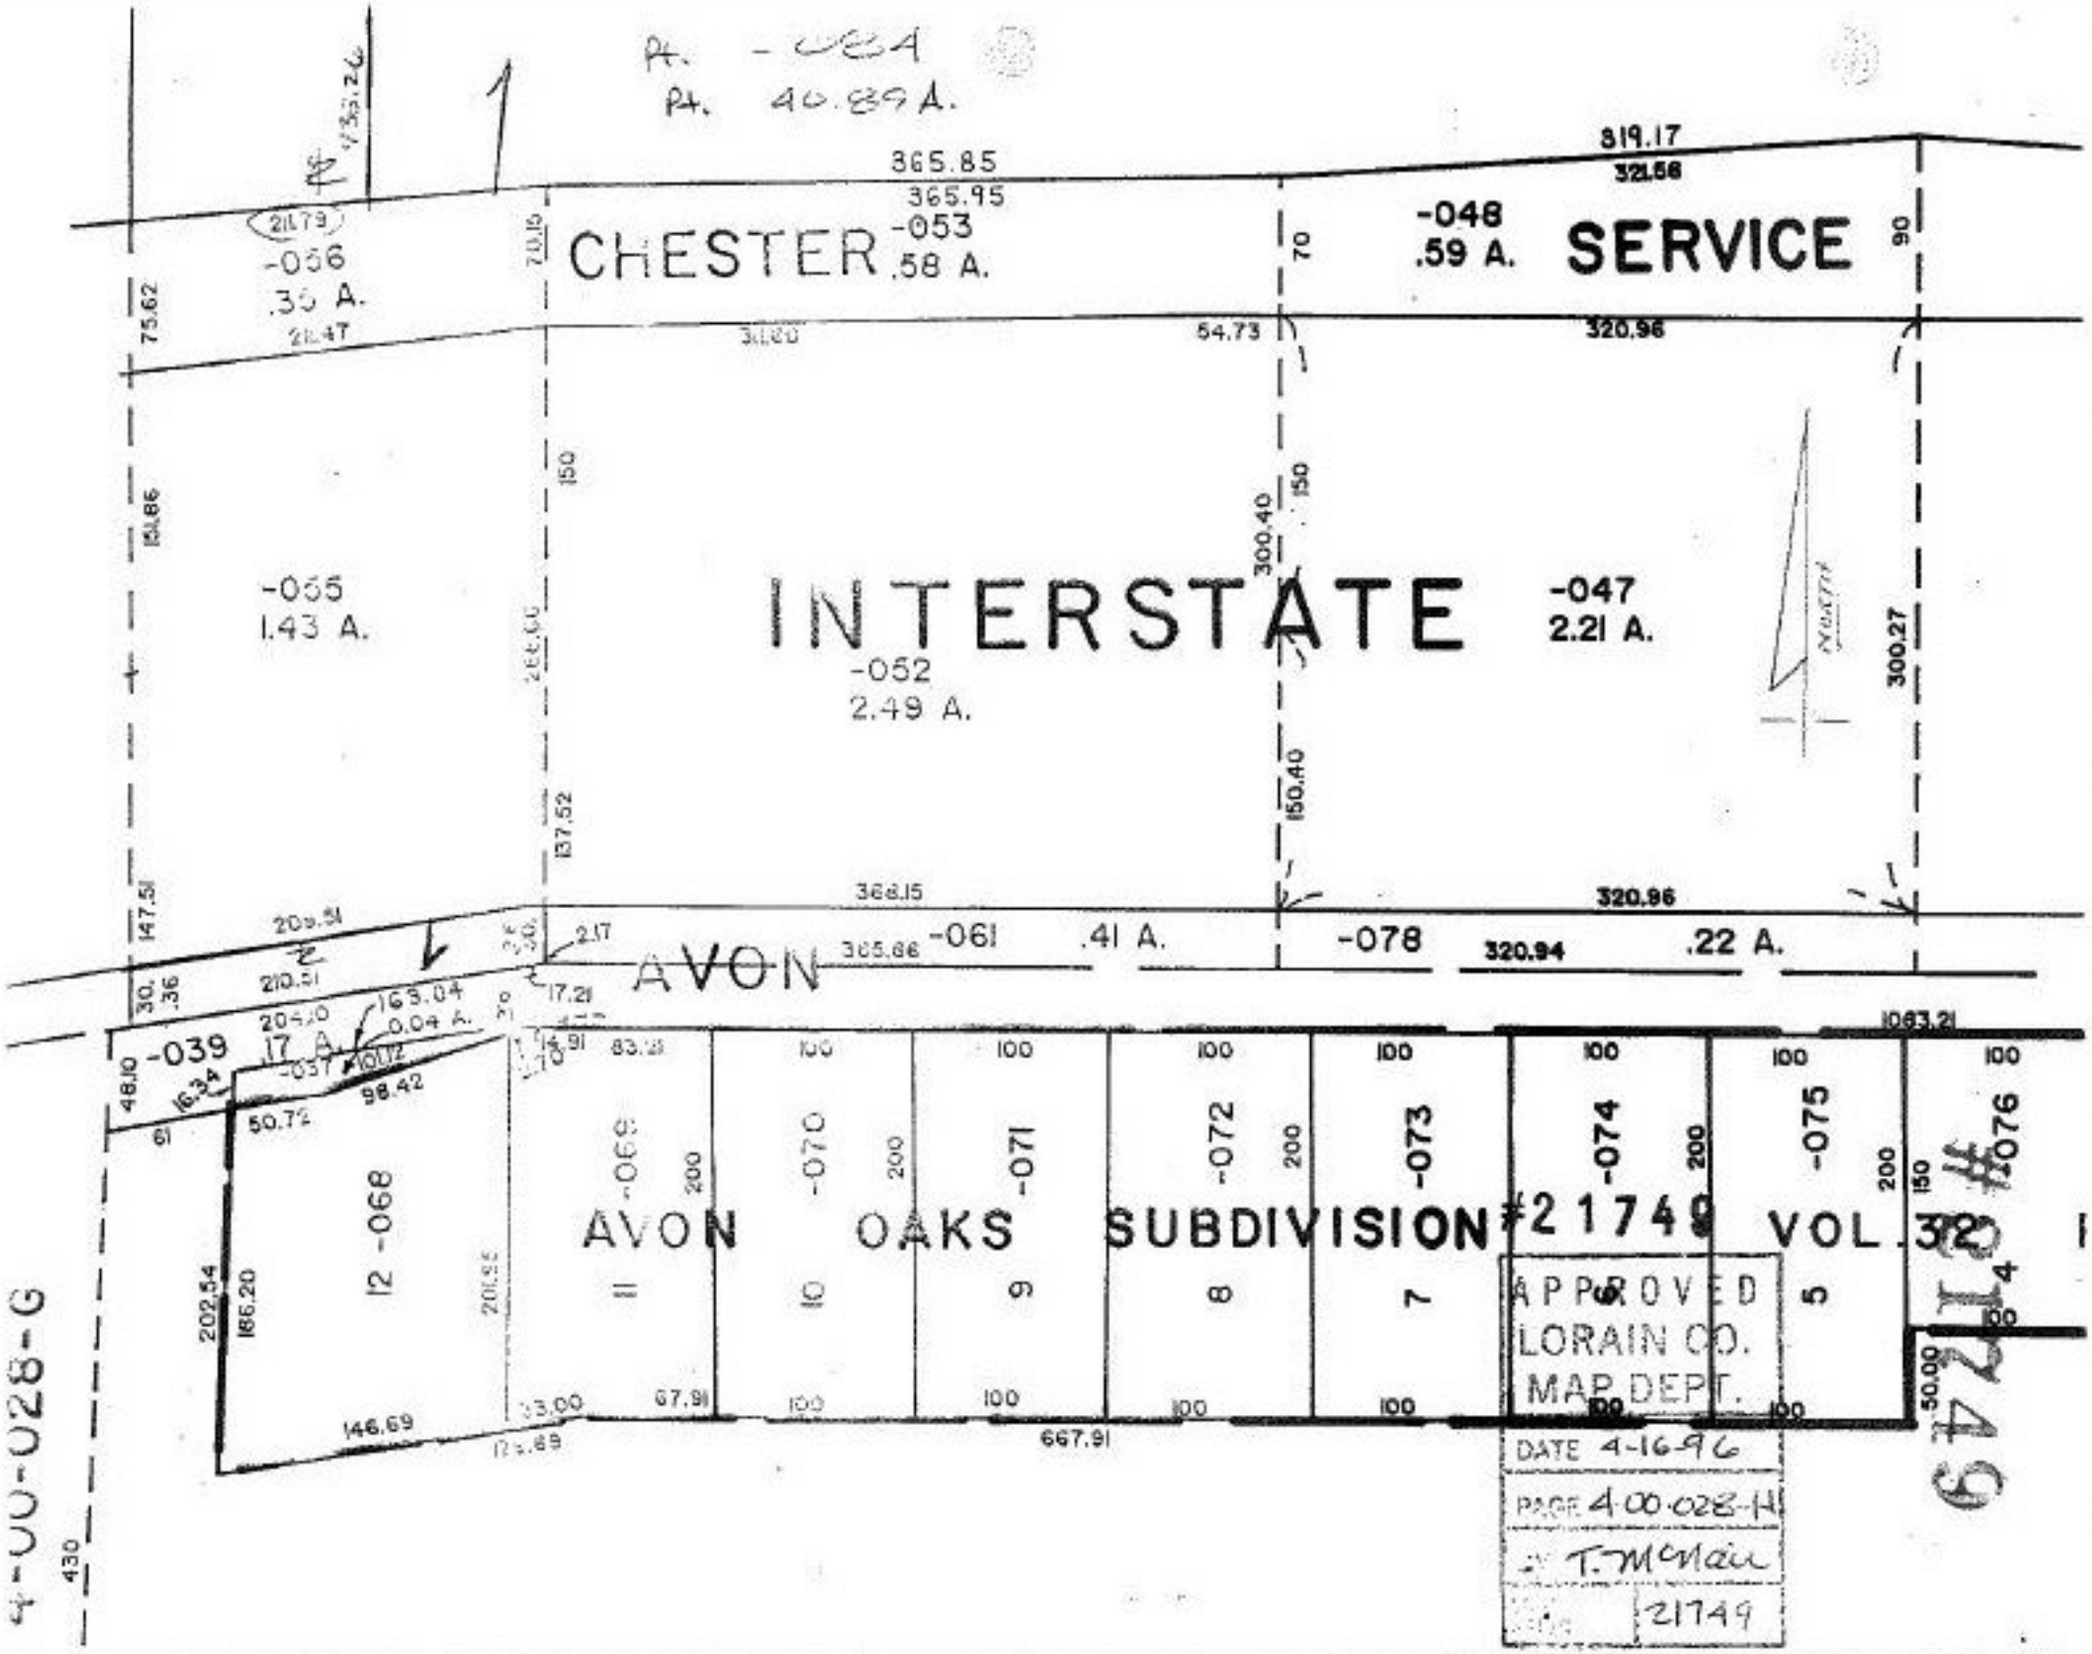
Pt. -054
Pt. 40.89 A.
CHESTER
-053
.58 A.
-048
.59 A.
SERVICE
-056
.36 A.
-055
1.43 A.
INTERSTATE
-052
2.49 A.
-047
2.21 A.
AVON
-061
.41 A.
-078
.22 A.
-039
.17 A.
-057
0.04 A.
AVON OAKS SUBDIVISION #2
12 -068
11 -069
10 -070
9 -071
8 -072
7 -073
6 -074
5 -075
-076
#21749 VOL. 32
APPROVED
LORAIN CO.
MAP DEPT.
DATE 4-16-96
PAGE 4-00-028-H
BY T. McNair
21749
4-00-028-G
NORTH