ALLEY VACATION :
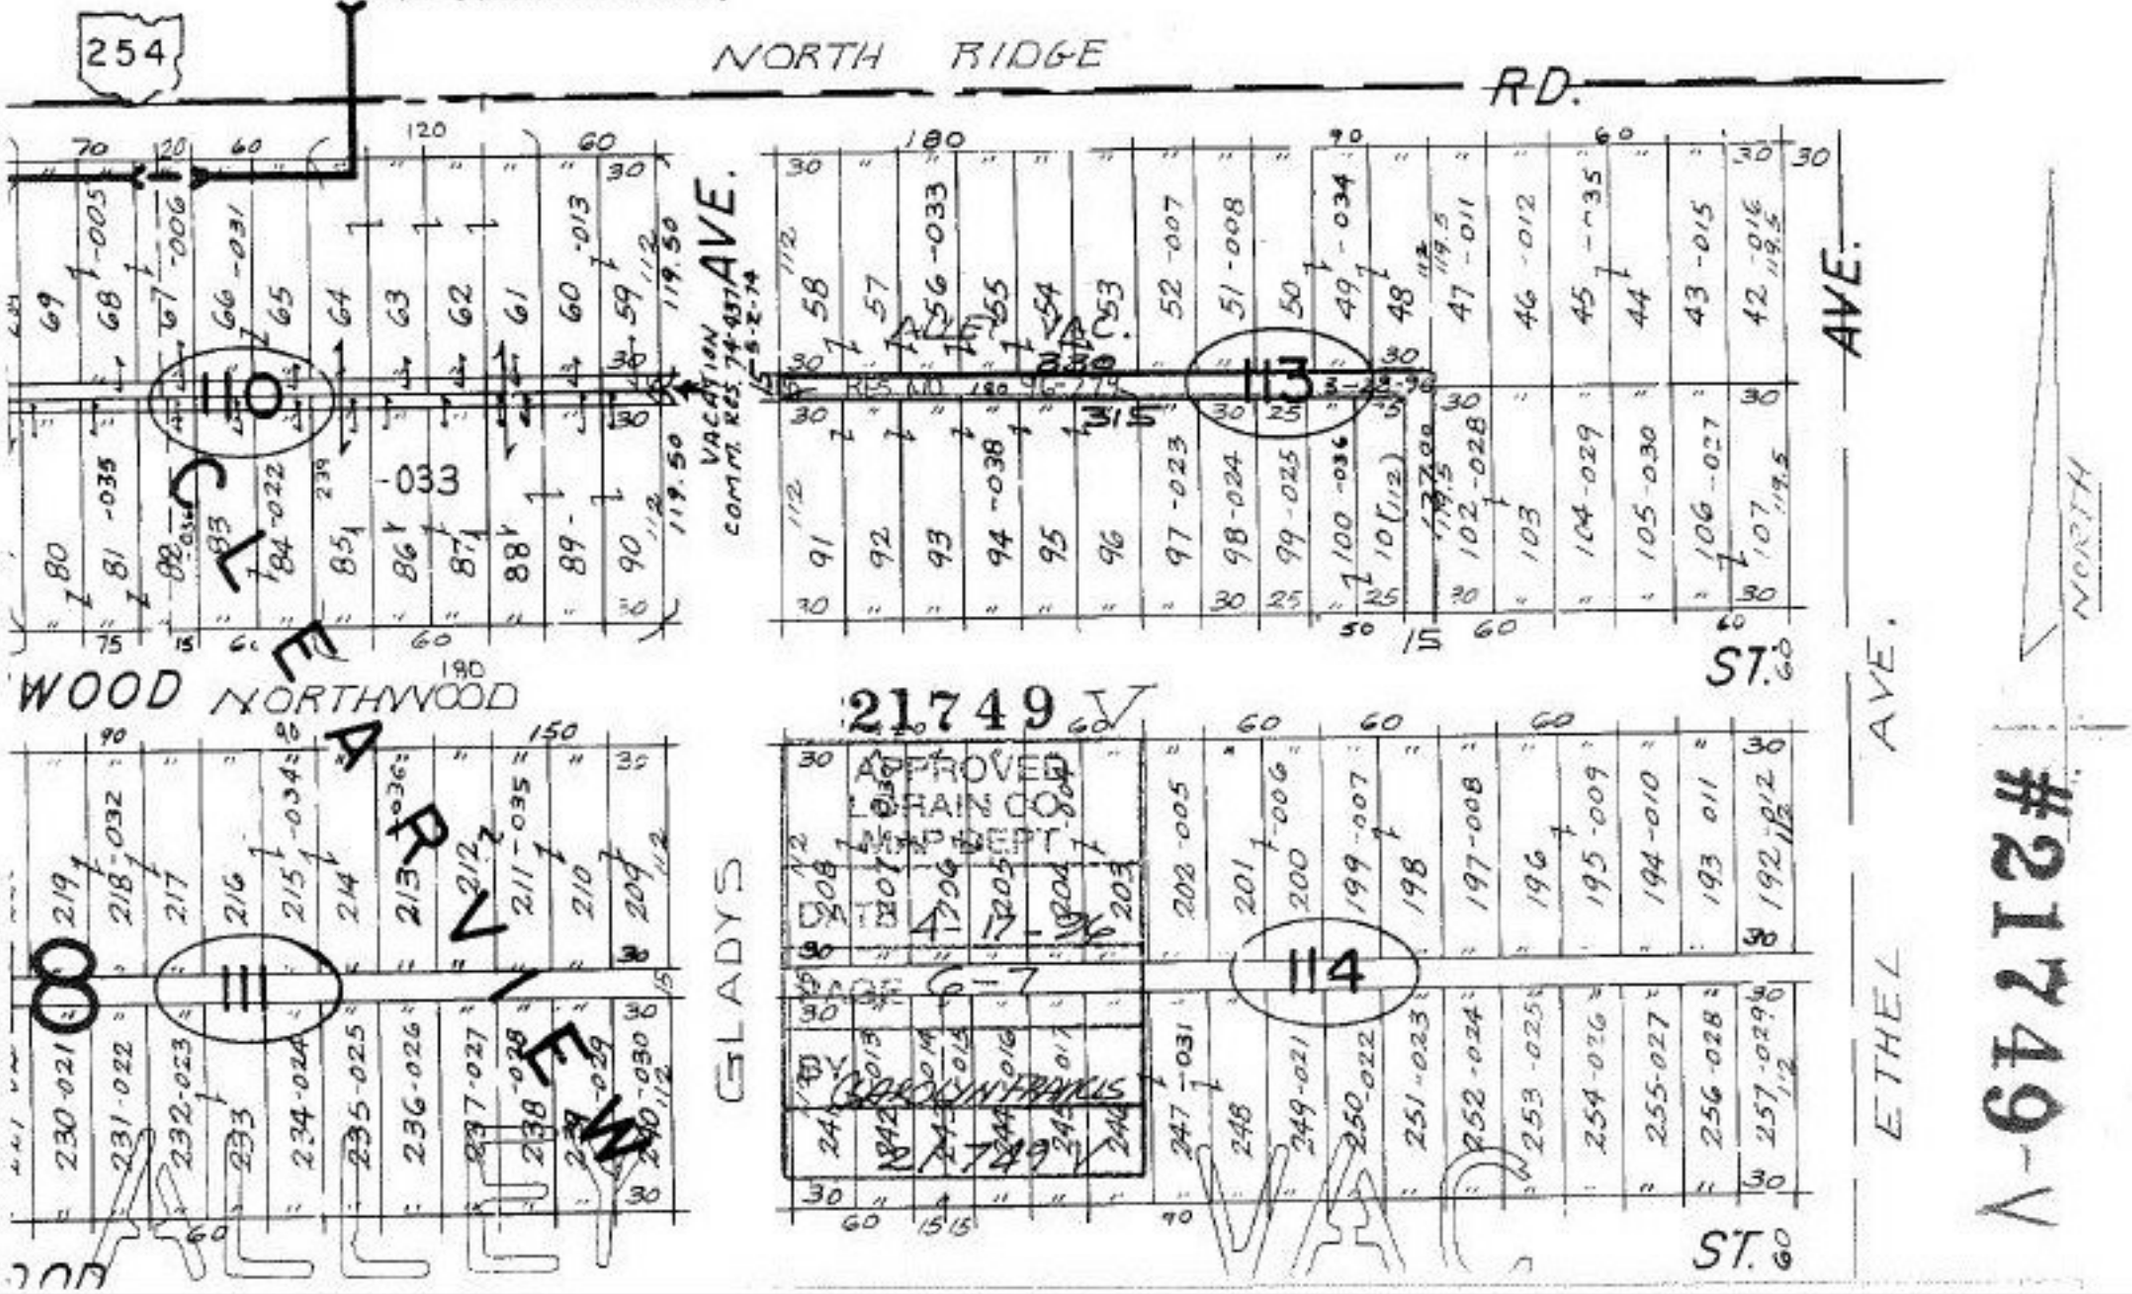
RES. NO. VACATING ALLEY IN CLEARVIEW SUBD. LOCATED BETWEEN GLADYS AVE. AND NORTHWOOD AVE.