


-022
8.82 AC

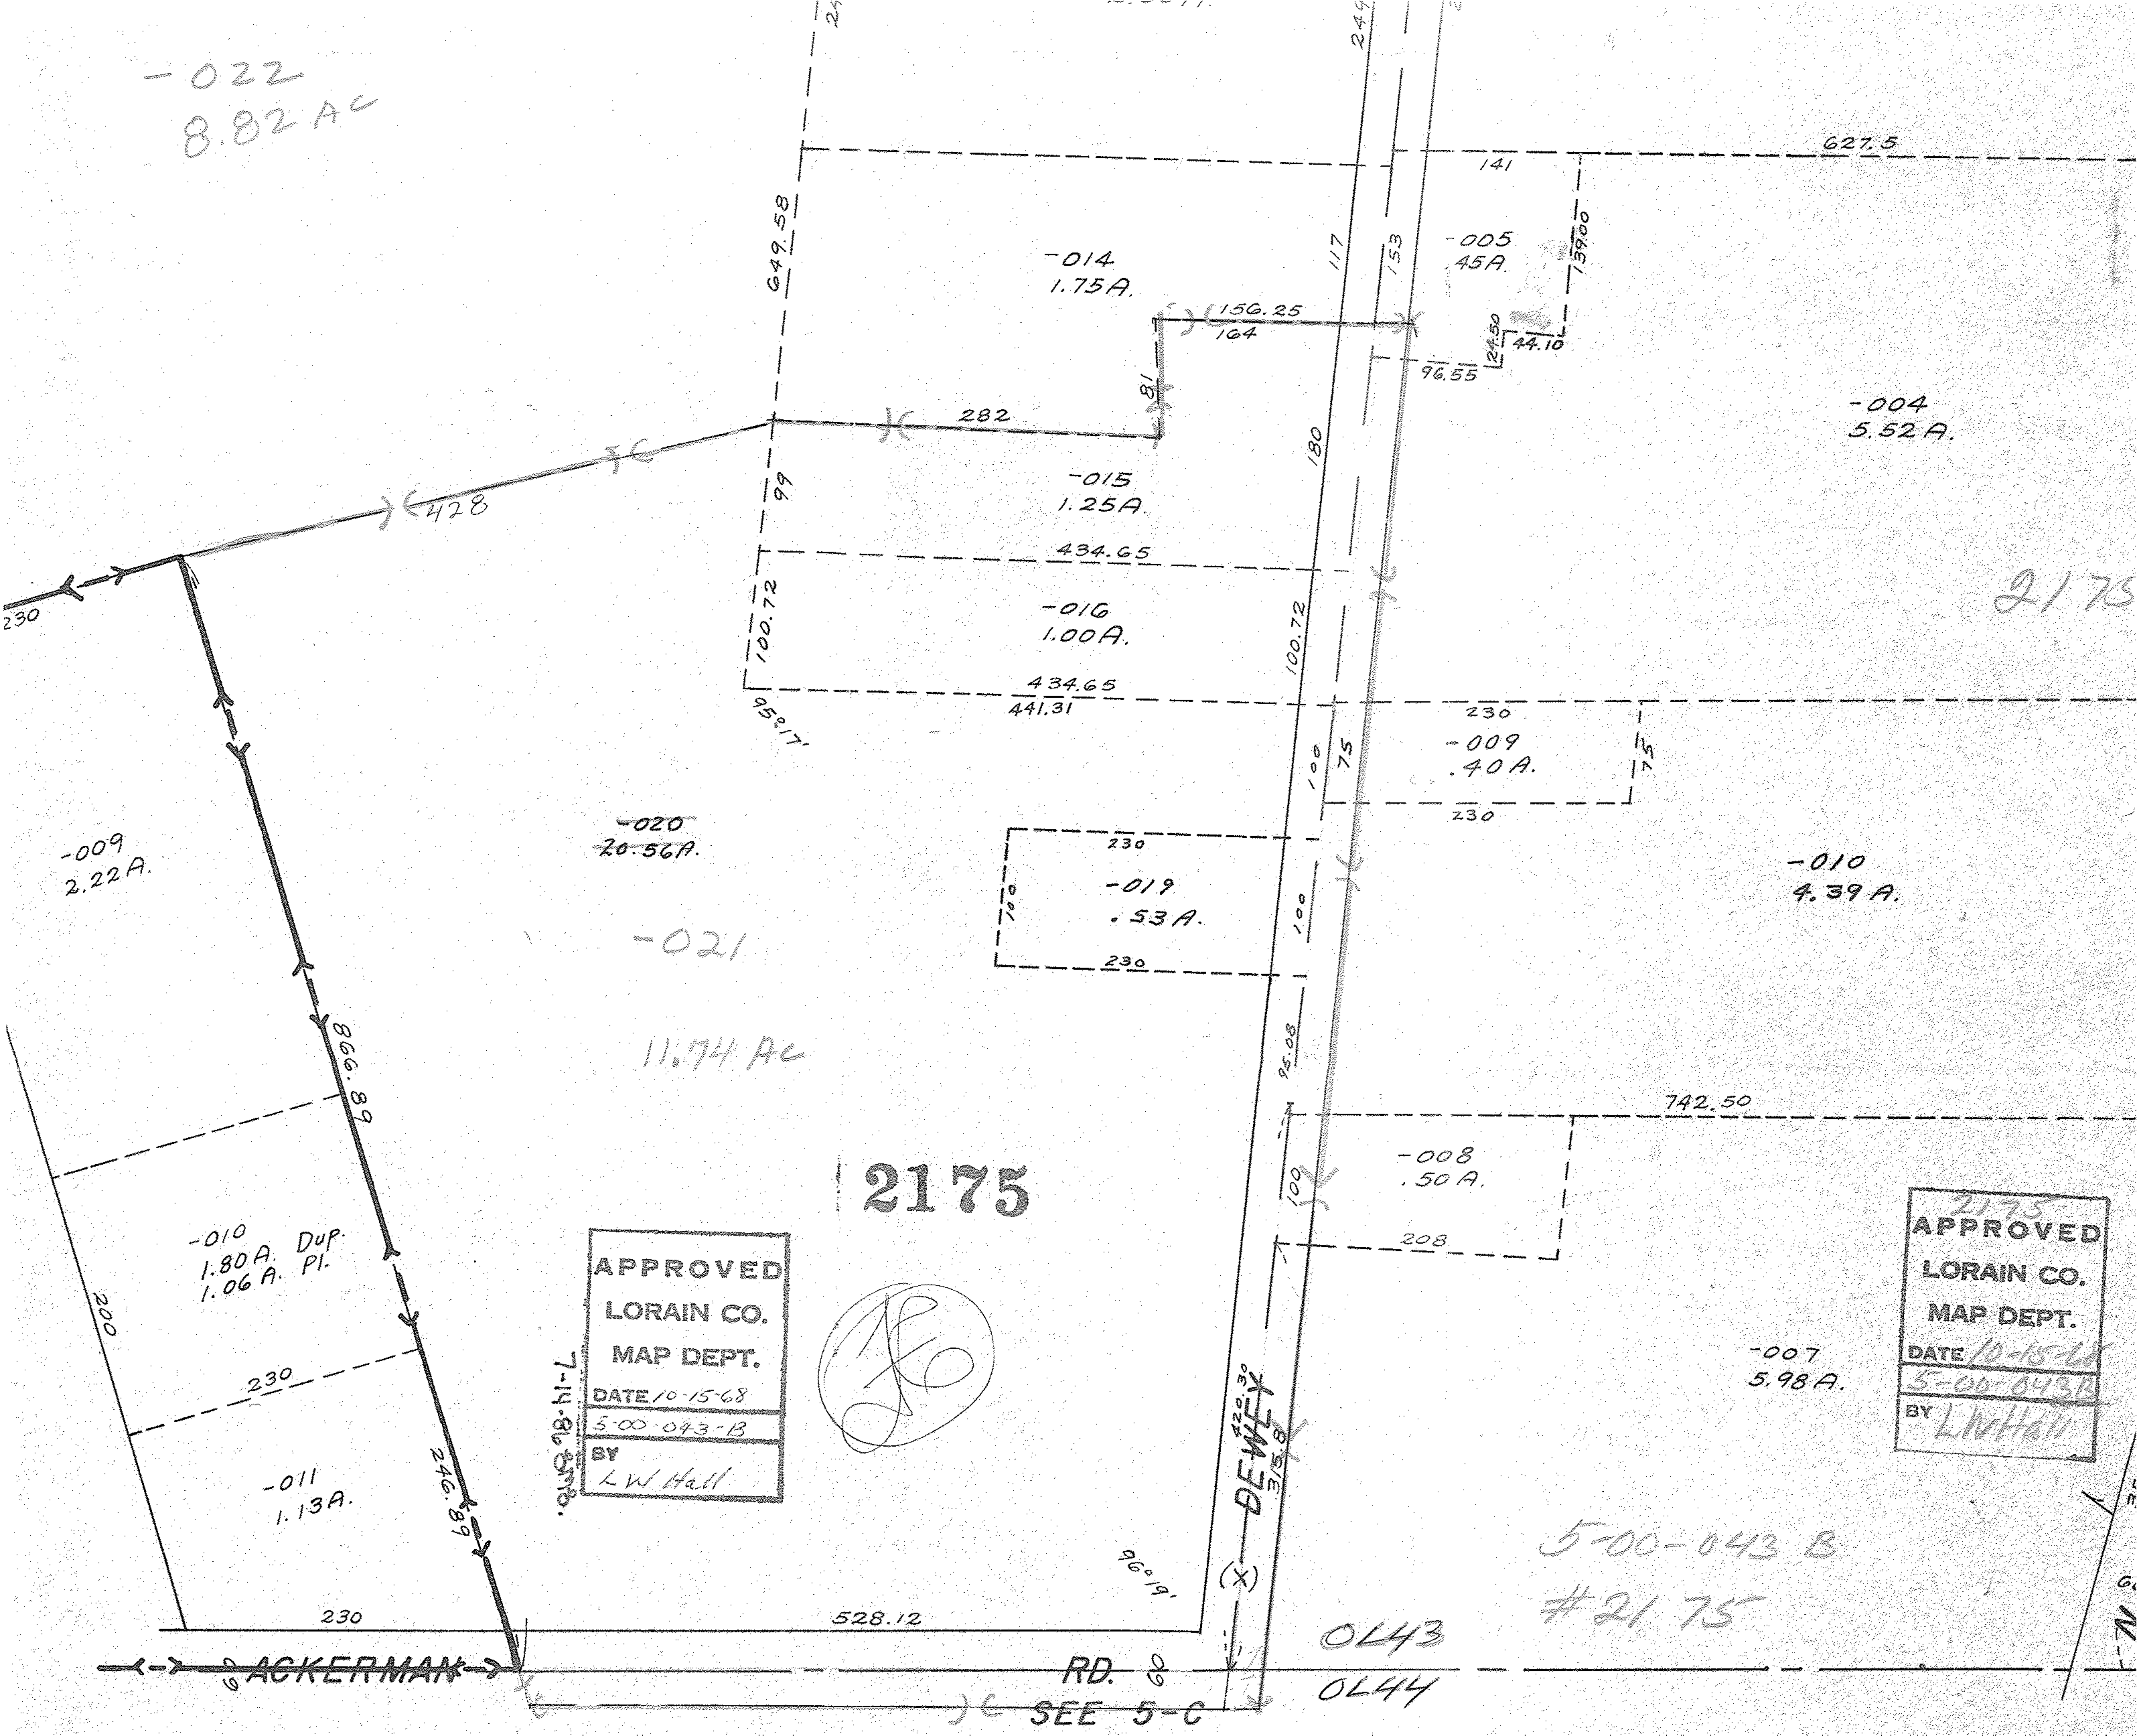

-009
2.22 A.

-010
1.80 A. Dup. PI.
1.06 A. PI.

-011
1.13 A.

-014
1.75 A.

-015
1.25 A.

-016
1.00 A.

-019
.53 A.

-020
20.56 A.

-021

11.74 AC

-004
5.52 A.

-005
45 A.

-009
.40 A.

-010
4.39 A.

-008
.50 A.

-007
5.98 A.

APPROVED
LORAIN CO.
MAP DEPT.
DATE 10-15-68
5-00-043-B
BY
LW Hall

(Handwritten signature)

2175
APPROVED
LORAIN CO.
MAP DEPT.
DATE 10-15-68
5-00-043-B
BY
LWHall

5-00-043 B
#2175

2175

0443
0444

RD. 6
SEE 5-C

ACKERMAN

2175


























