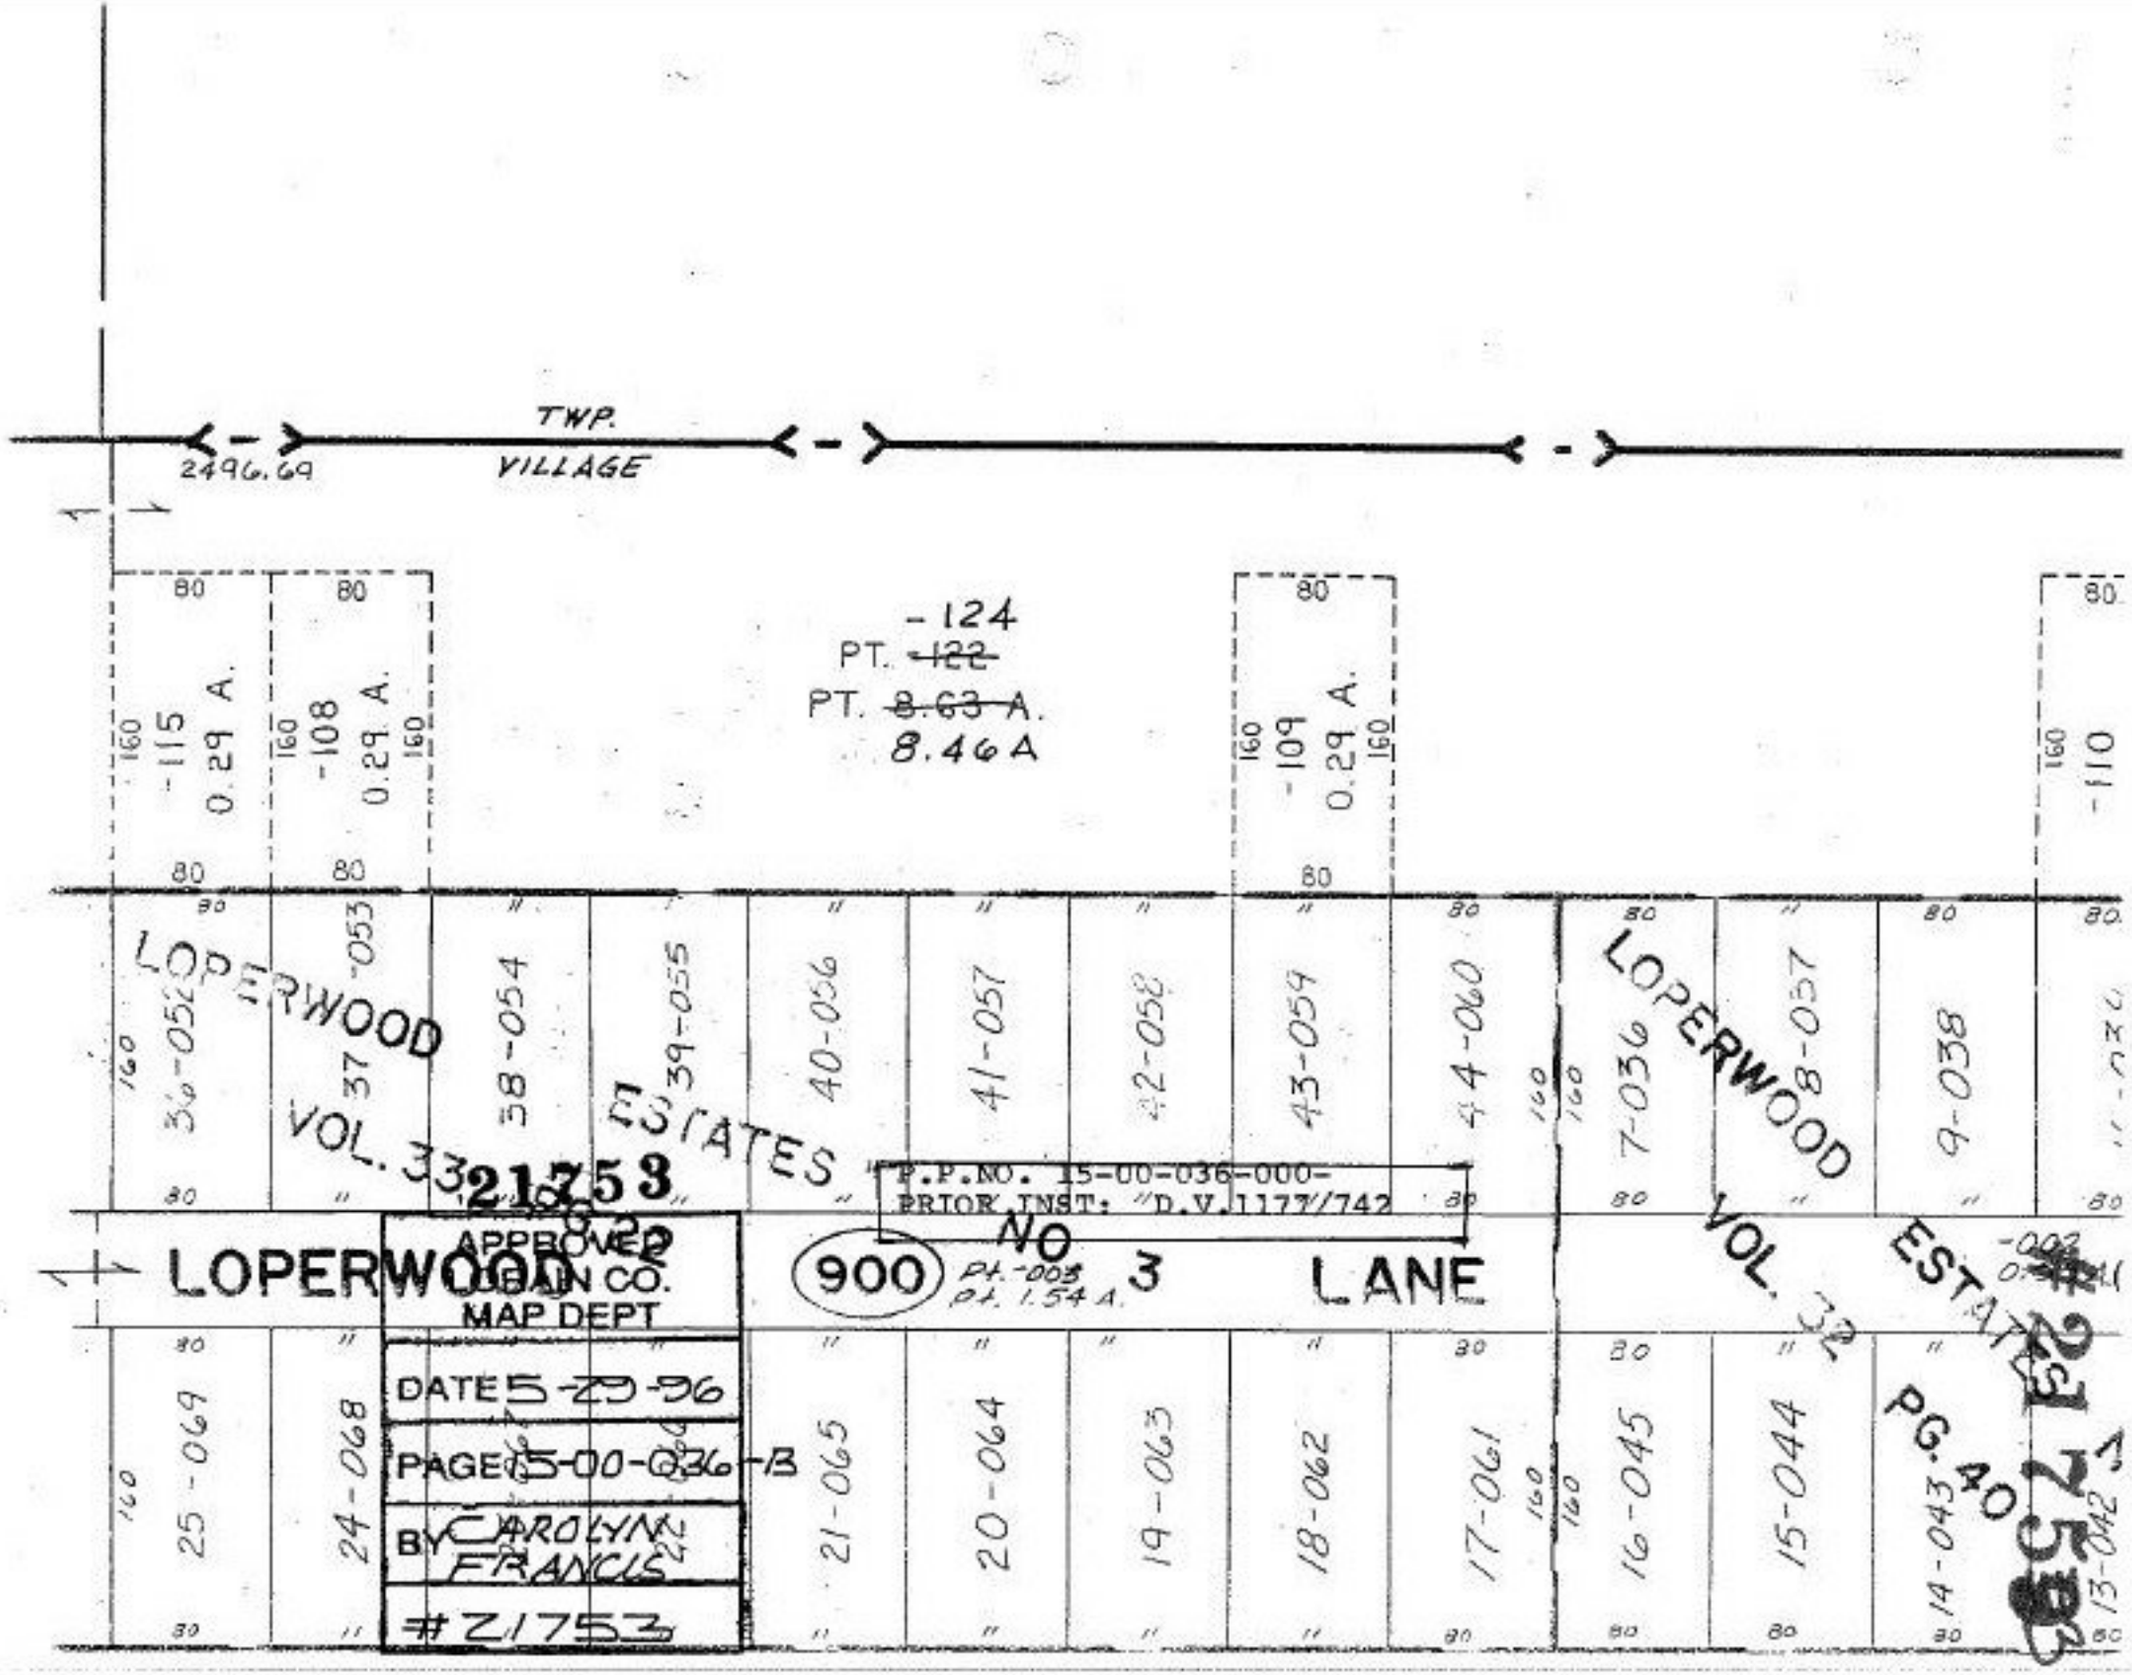
TWP.
VILLAGE
2496.69
-124
PT. ~~122~~
PT. ~~8.63 A.~~
8.46 A
-115
0.29 A.
-108
0.29 A.
-109
0.29 A.
-110
LOPERWOOD
VOL. 37
ESTATES
LOPERWOOD
VOL. 32
ESTATES
P.P.NO. 15-00-036-000-
PRIOR INST: "D.V. 1177/742
900
PT. -003
PT. 1.54 A.
NO 3 LANE
LOPERWOOD
APPROVED
MAP DEPT
DATE 5-29-96
PAGE 15-00-036-B
BY CAROLYN FRANCIS
#21753
#21753
PG. 40